



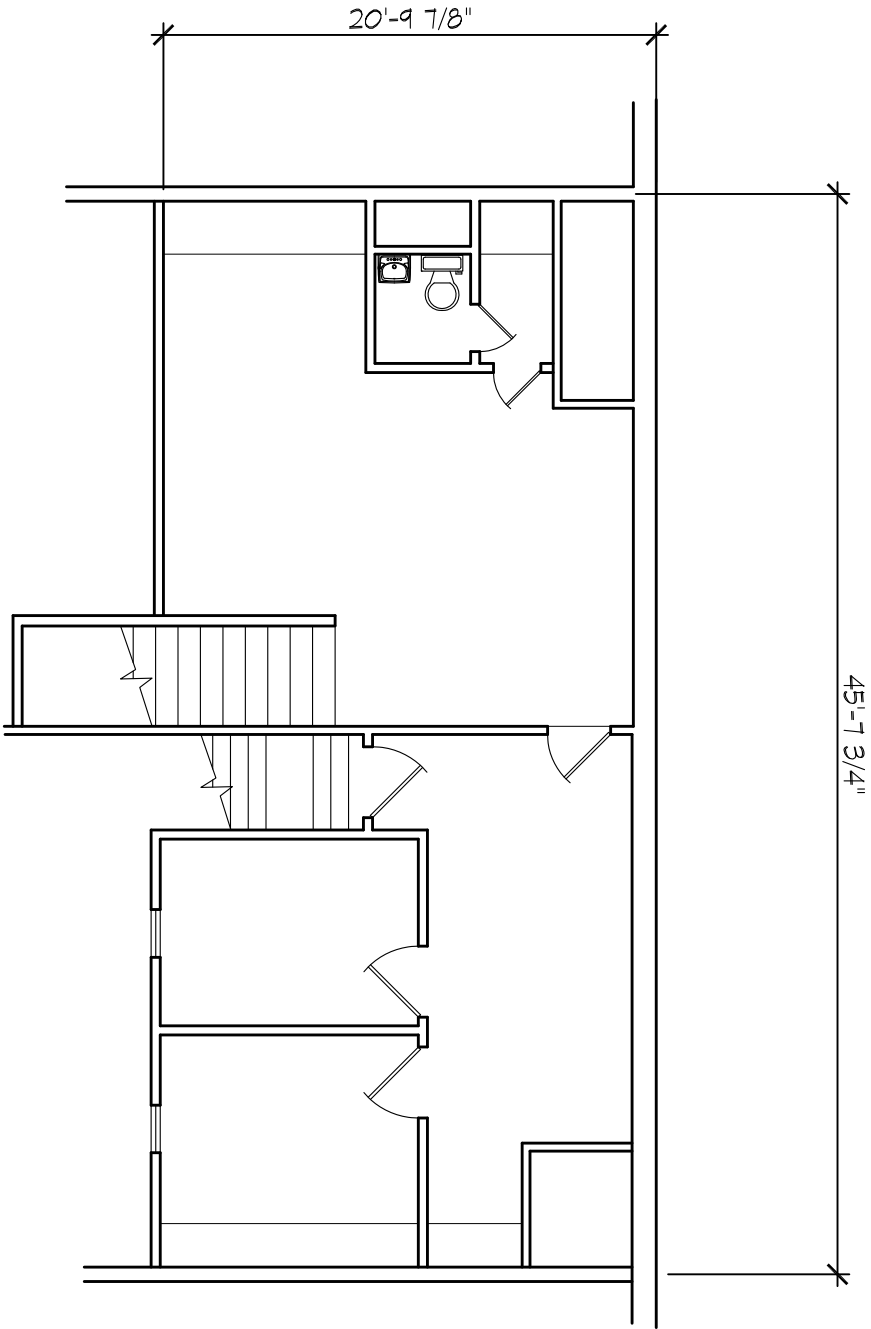

AS BUILT UPPER LEVEL FLOOR PLAN
5888 LEESBURG PIKE
FALLS CHURCH, VIRGINIA
957 s.f.

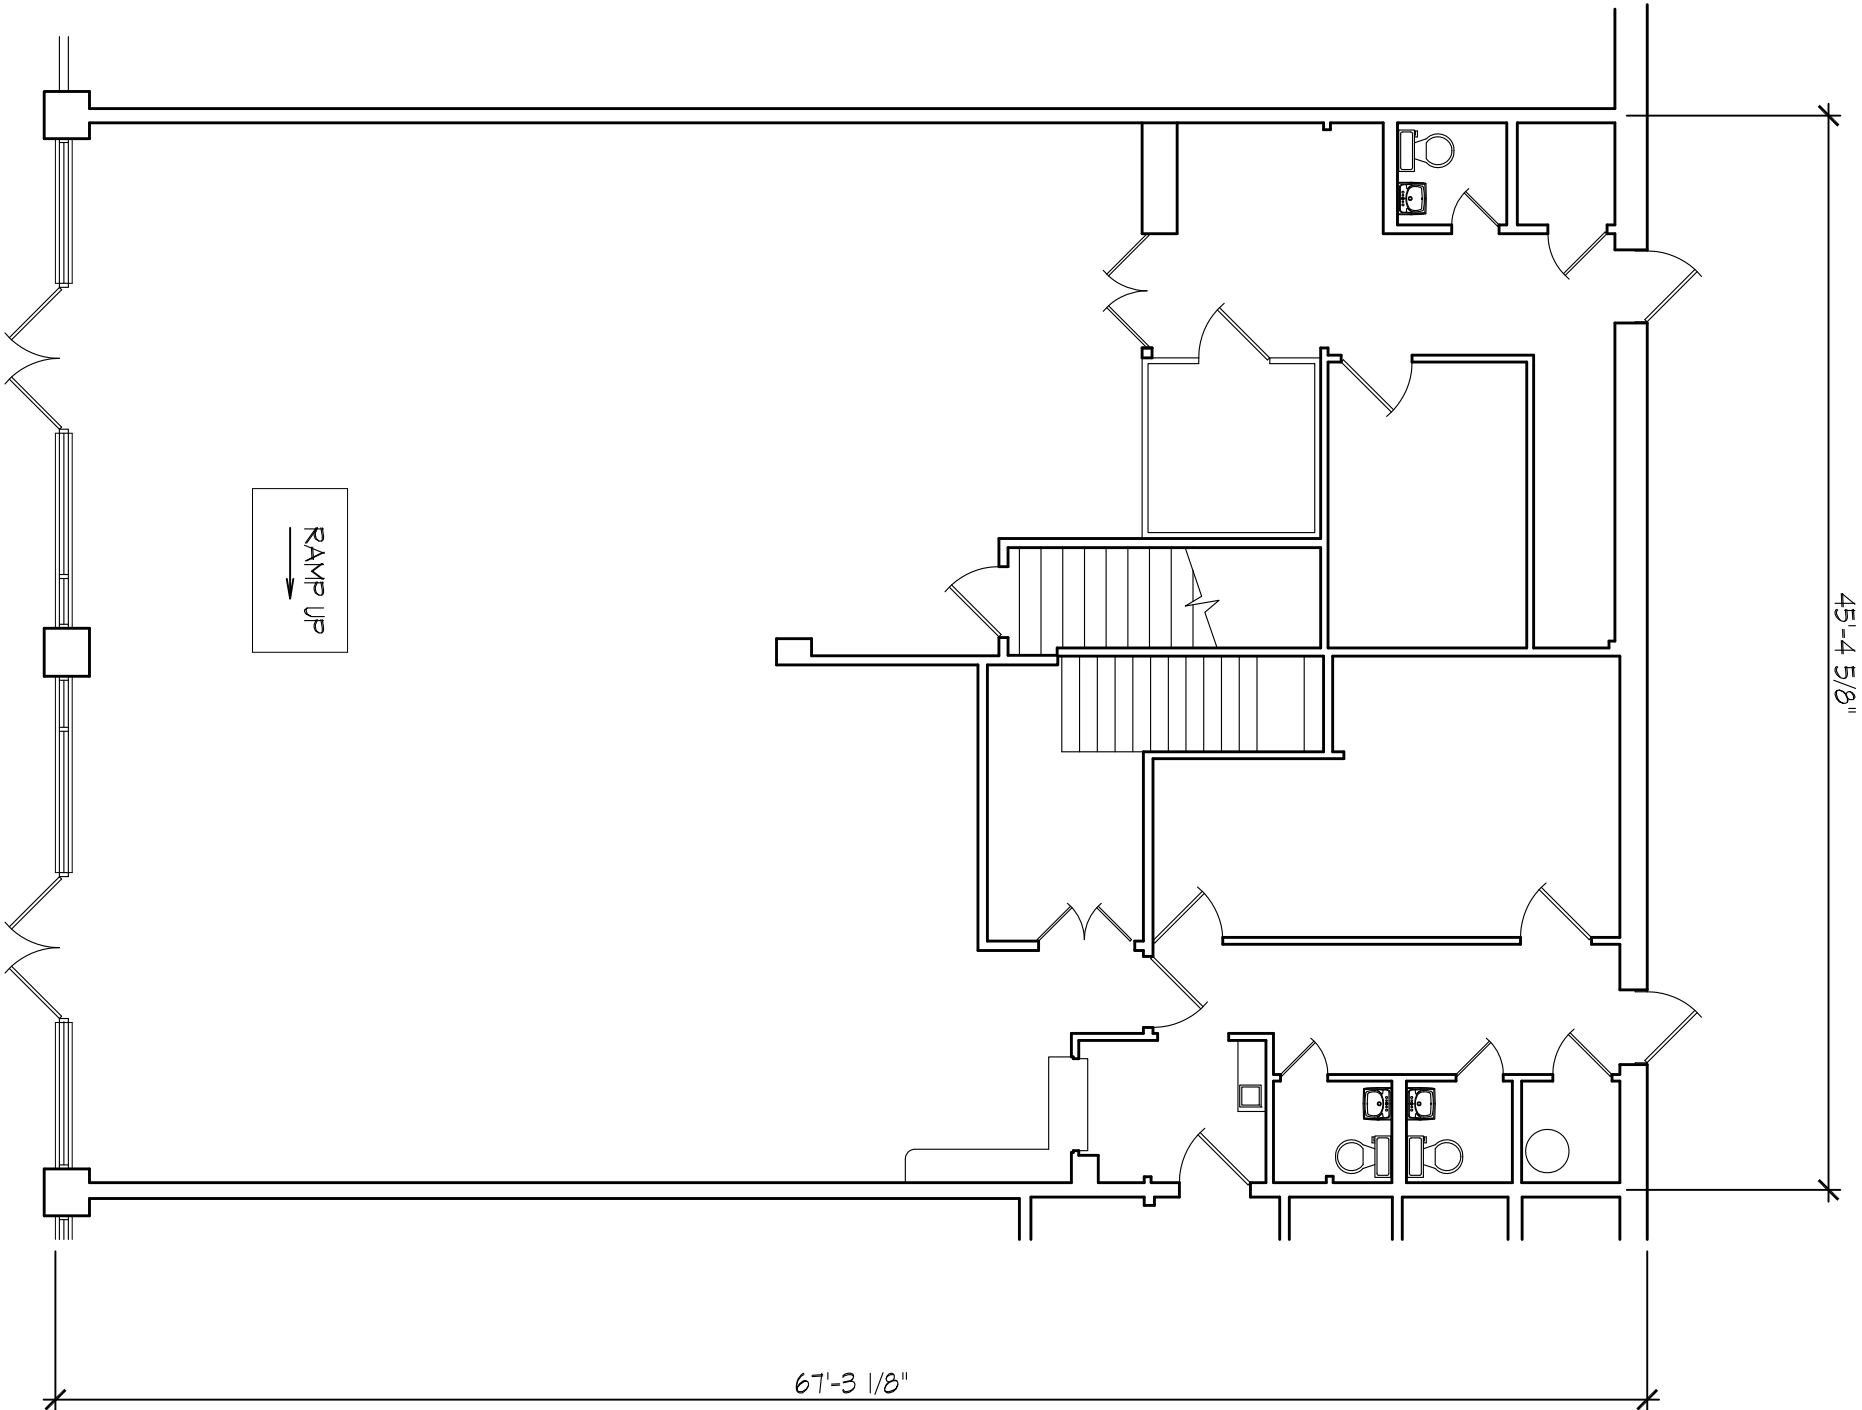

AS BUILT GROUND FLOOR PLAN
5888 LEESBURG PIKE
FALLS CHURCH, VIRGINIA
3,053 s.f.