



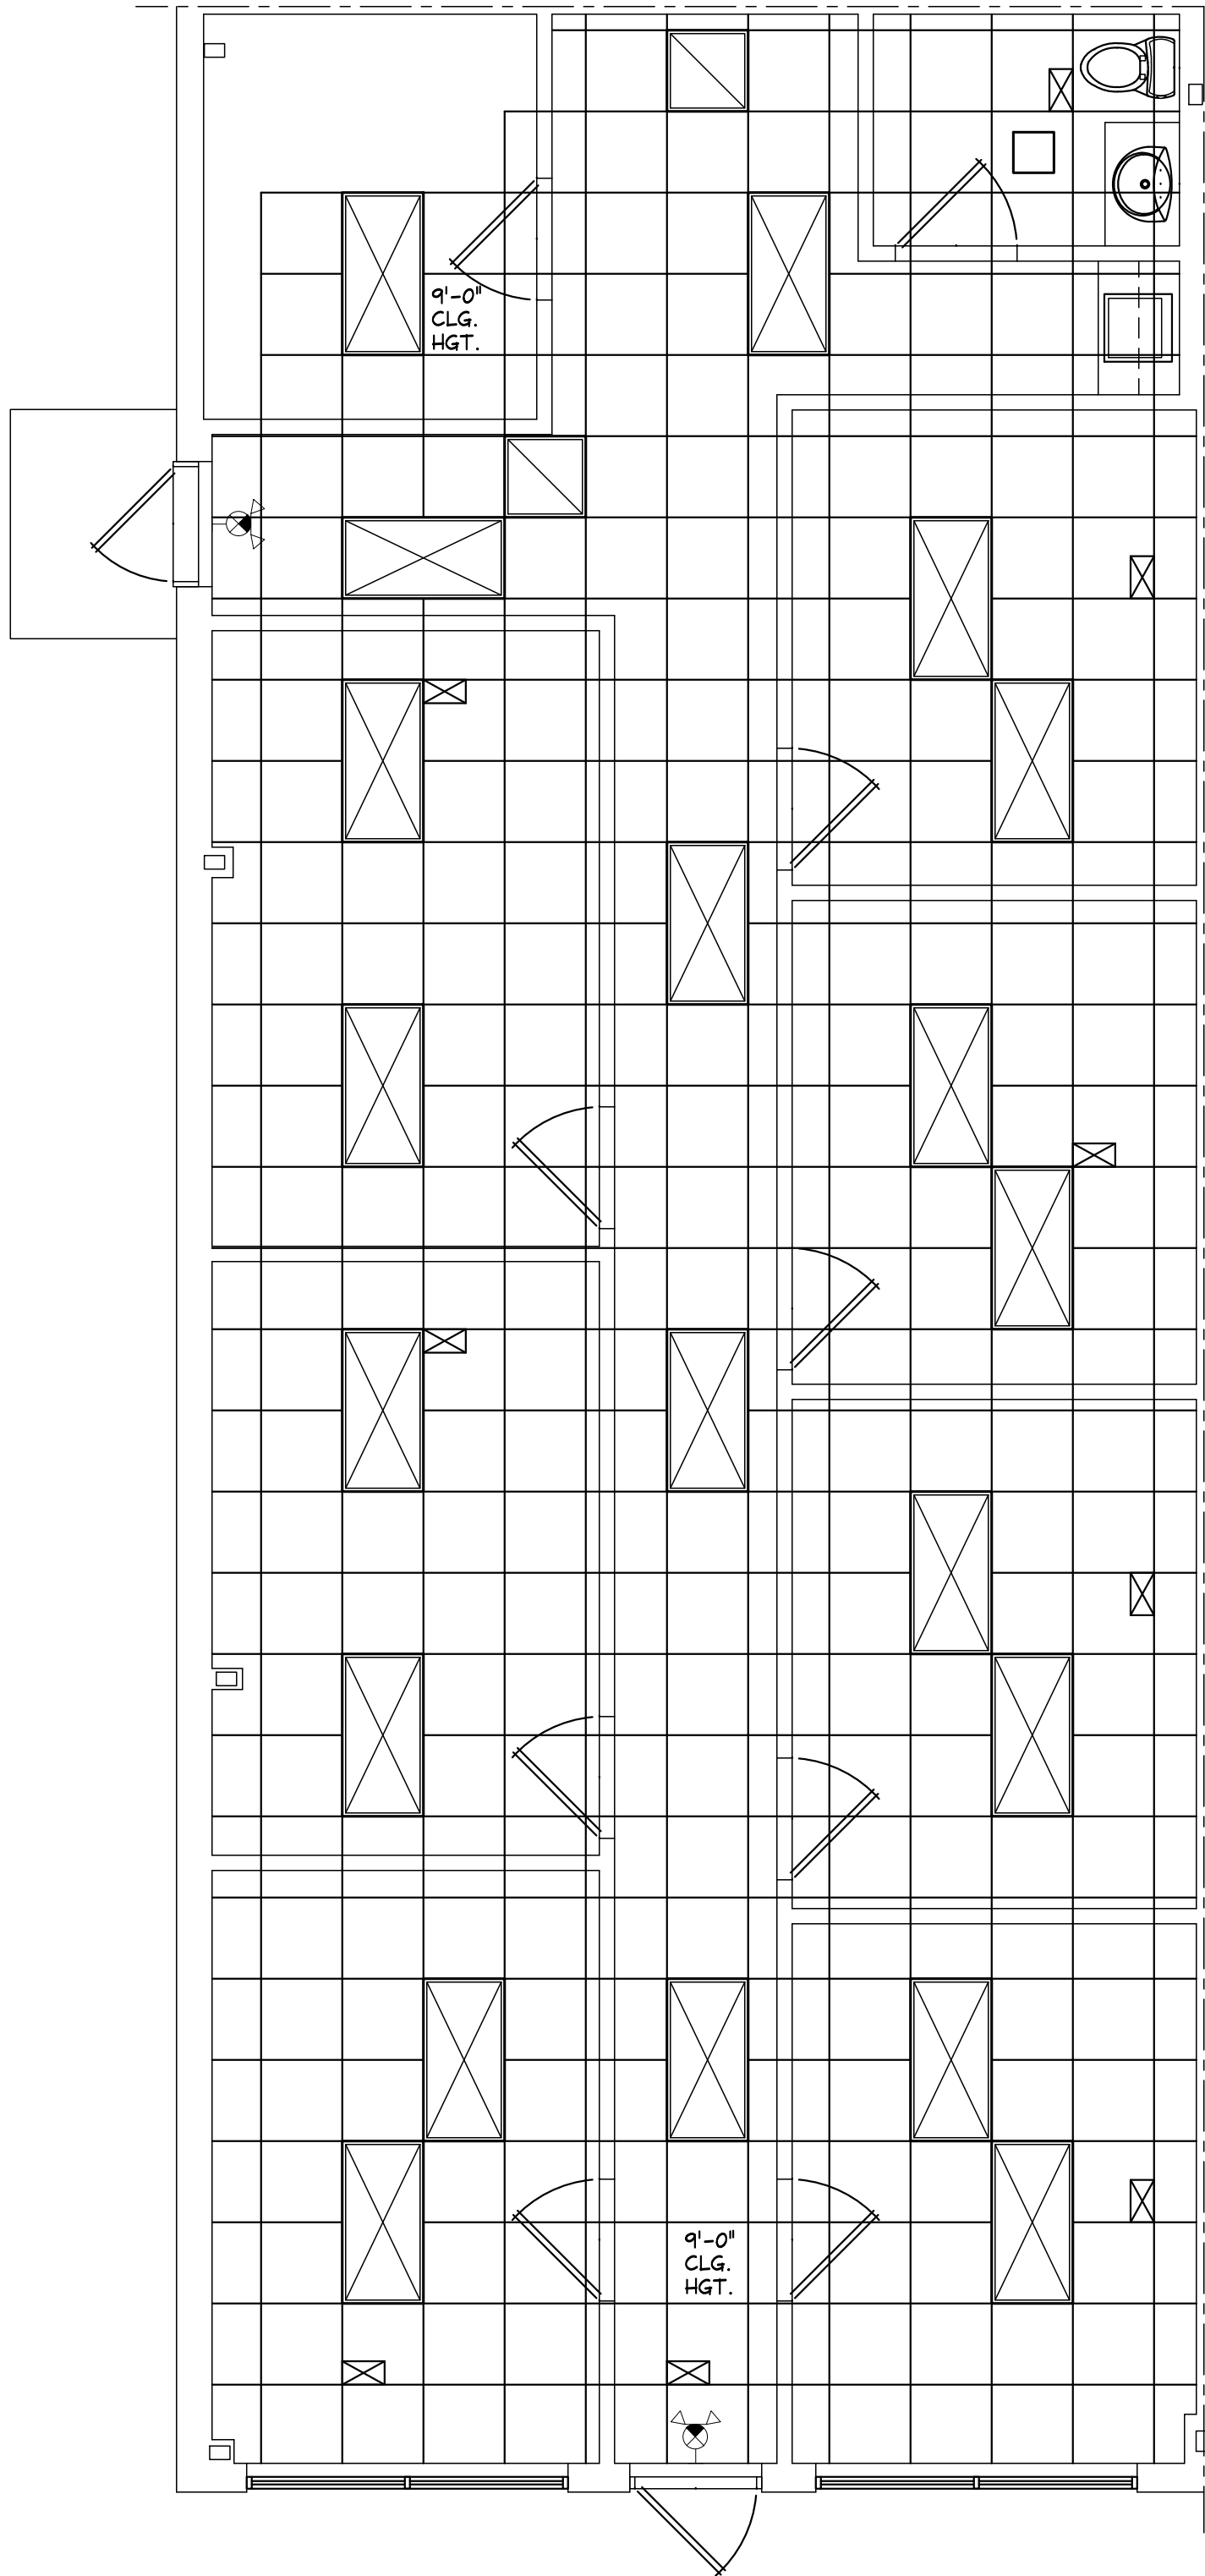

SUITE 4
REFLECTED CEILING PLAN
SCALE: 1/4" = 1'-0"

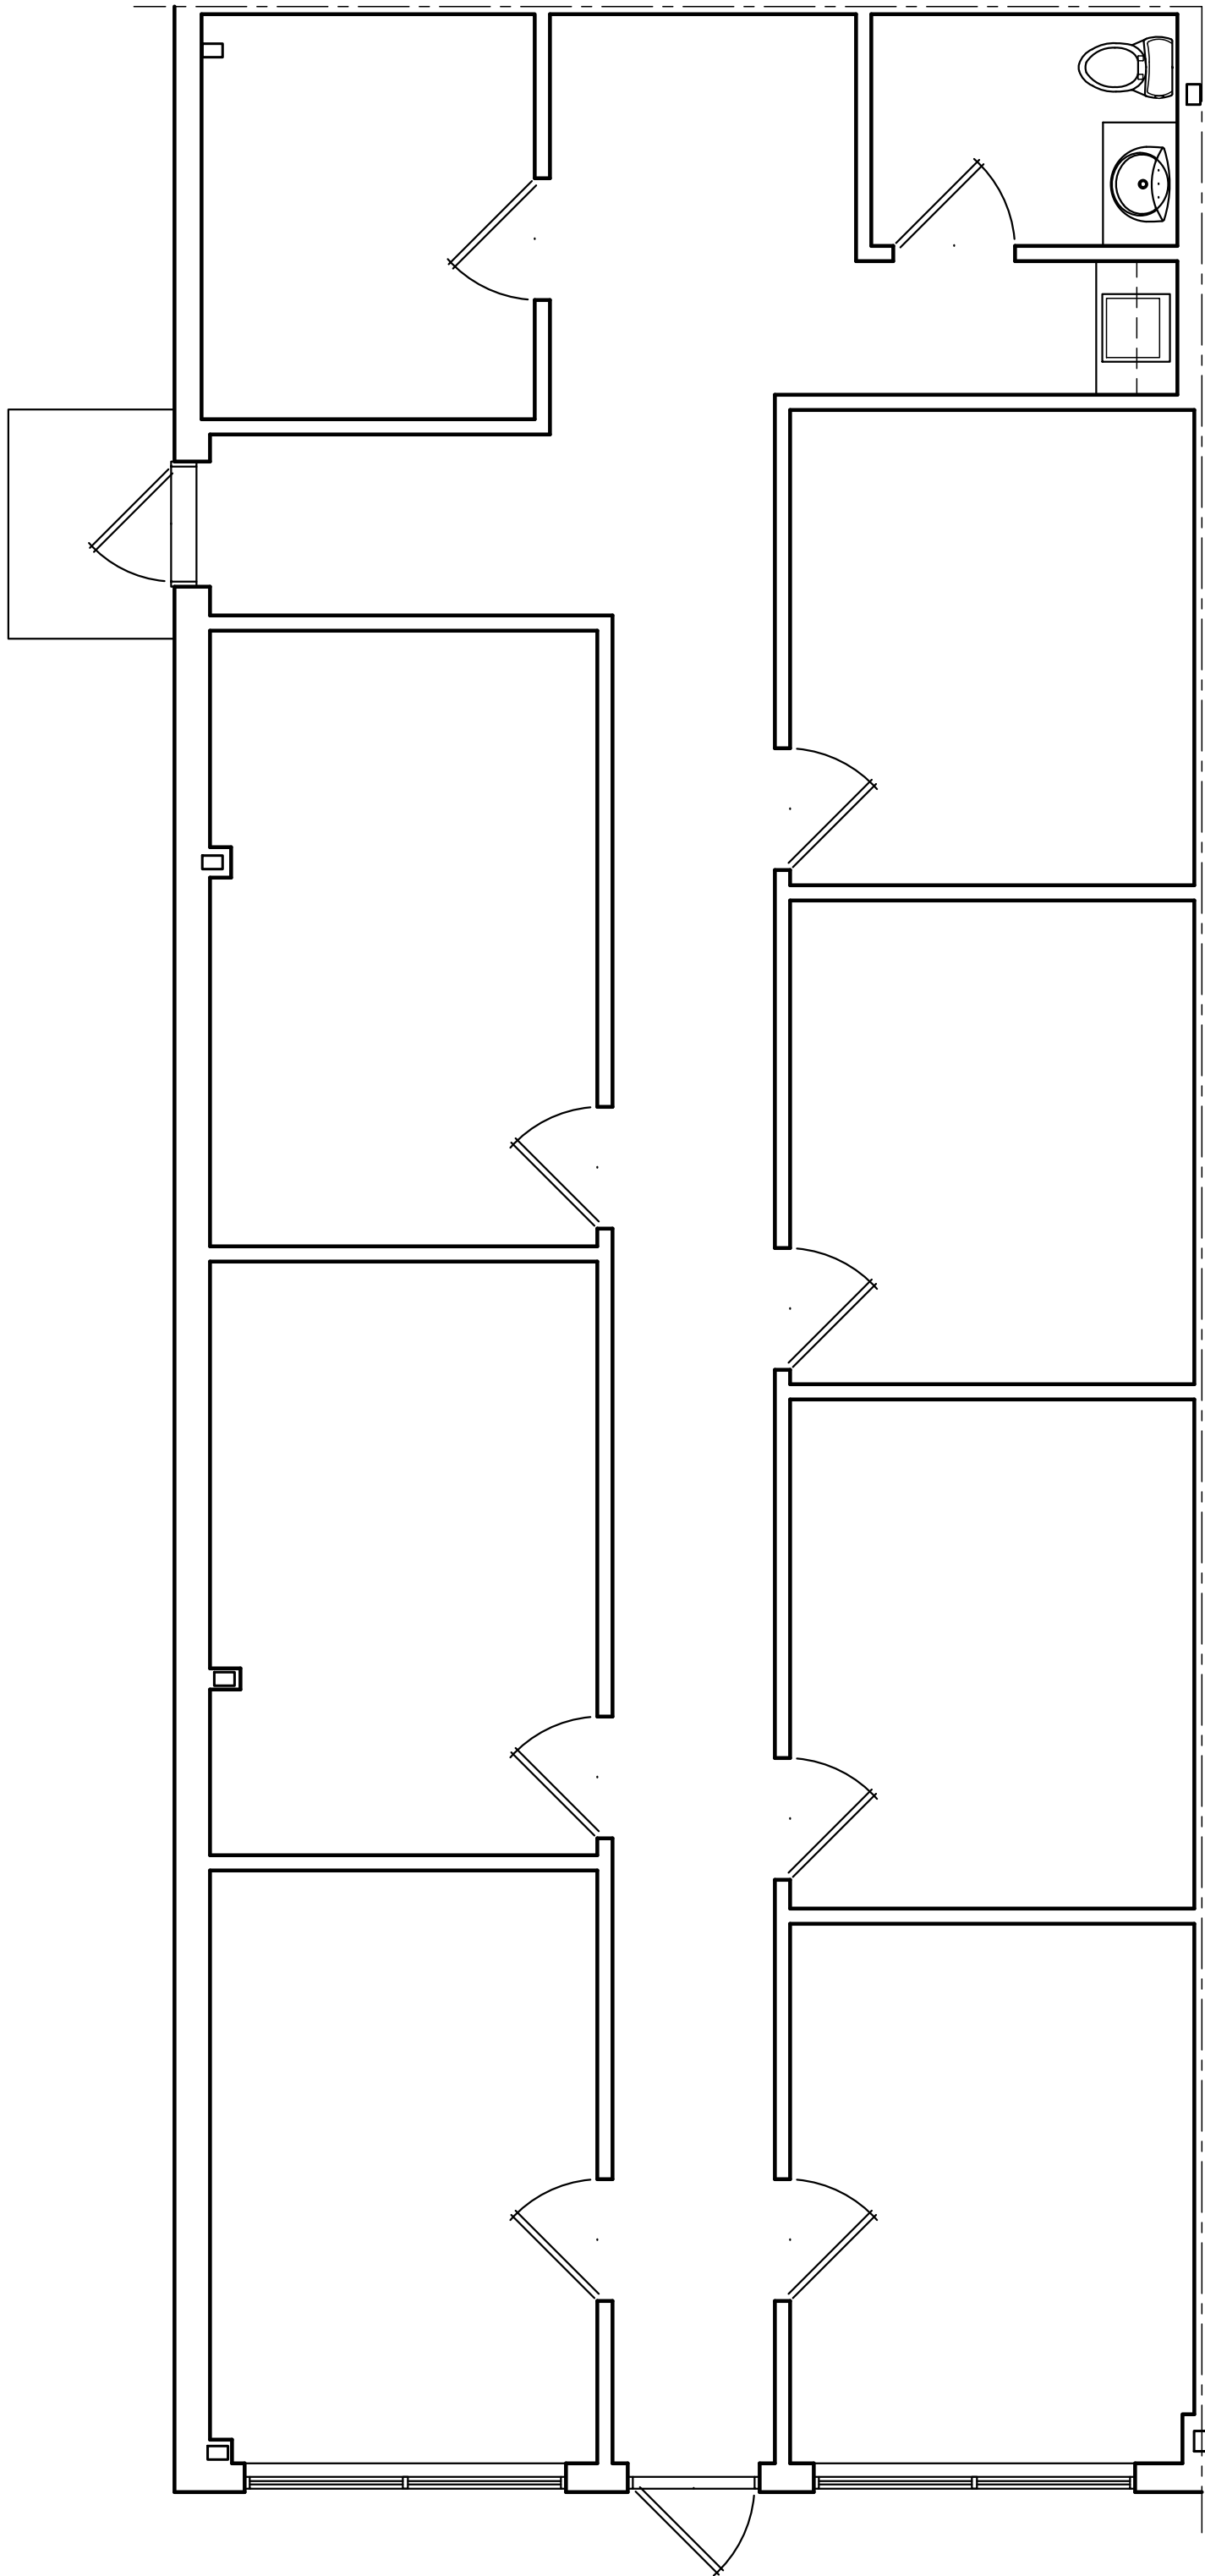

SUITE 4 PLAN
SCALE: 1/4" = 1'-0"

BUILDING AREA
SUITE 4 - 1,550 SQ. FT.

SHEET TITLE		DRAWN	SEAL	West & Associates ARCHITECTS		DATE	REV. NO.	DESCRIPTION
SUITE 4 PLAN & REFLECTED CEILING PLAN		CHECKED		4389 SHELDORNE DRIVE, DUNWOODY, GEORGIA 30338-6615 (770) 457-4495				
PROJECT NAME AS-BUILT SURVEY FOR 120 CLOSTER RD. - LAWRENCEVILLE, GA		APPROVED						
REPRODUCTION RESTRICTION This drawing is the property of the Architect and may not be copied or reproduced without the written permission of the Architect.		PROJECT NO. 2012110.00		DATE 6 JUNE 2012				
SHEET NO.		A-4						