

CCP 100


6031 UNIVERSITY BLVD ELLICOTT CITY, MD 21043
SUITE 300

TOTAL SF AVAILABLE -11,300 RSF (16%)

Click to access **CADD file**



Key Plan

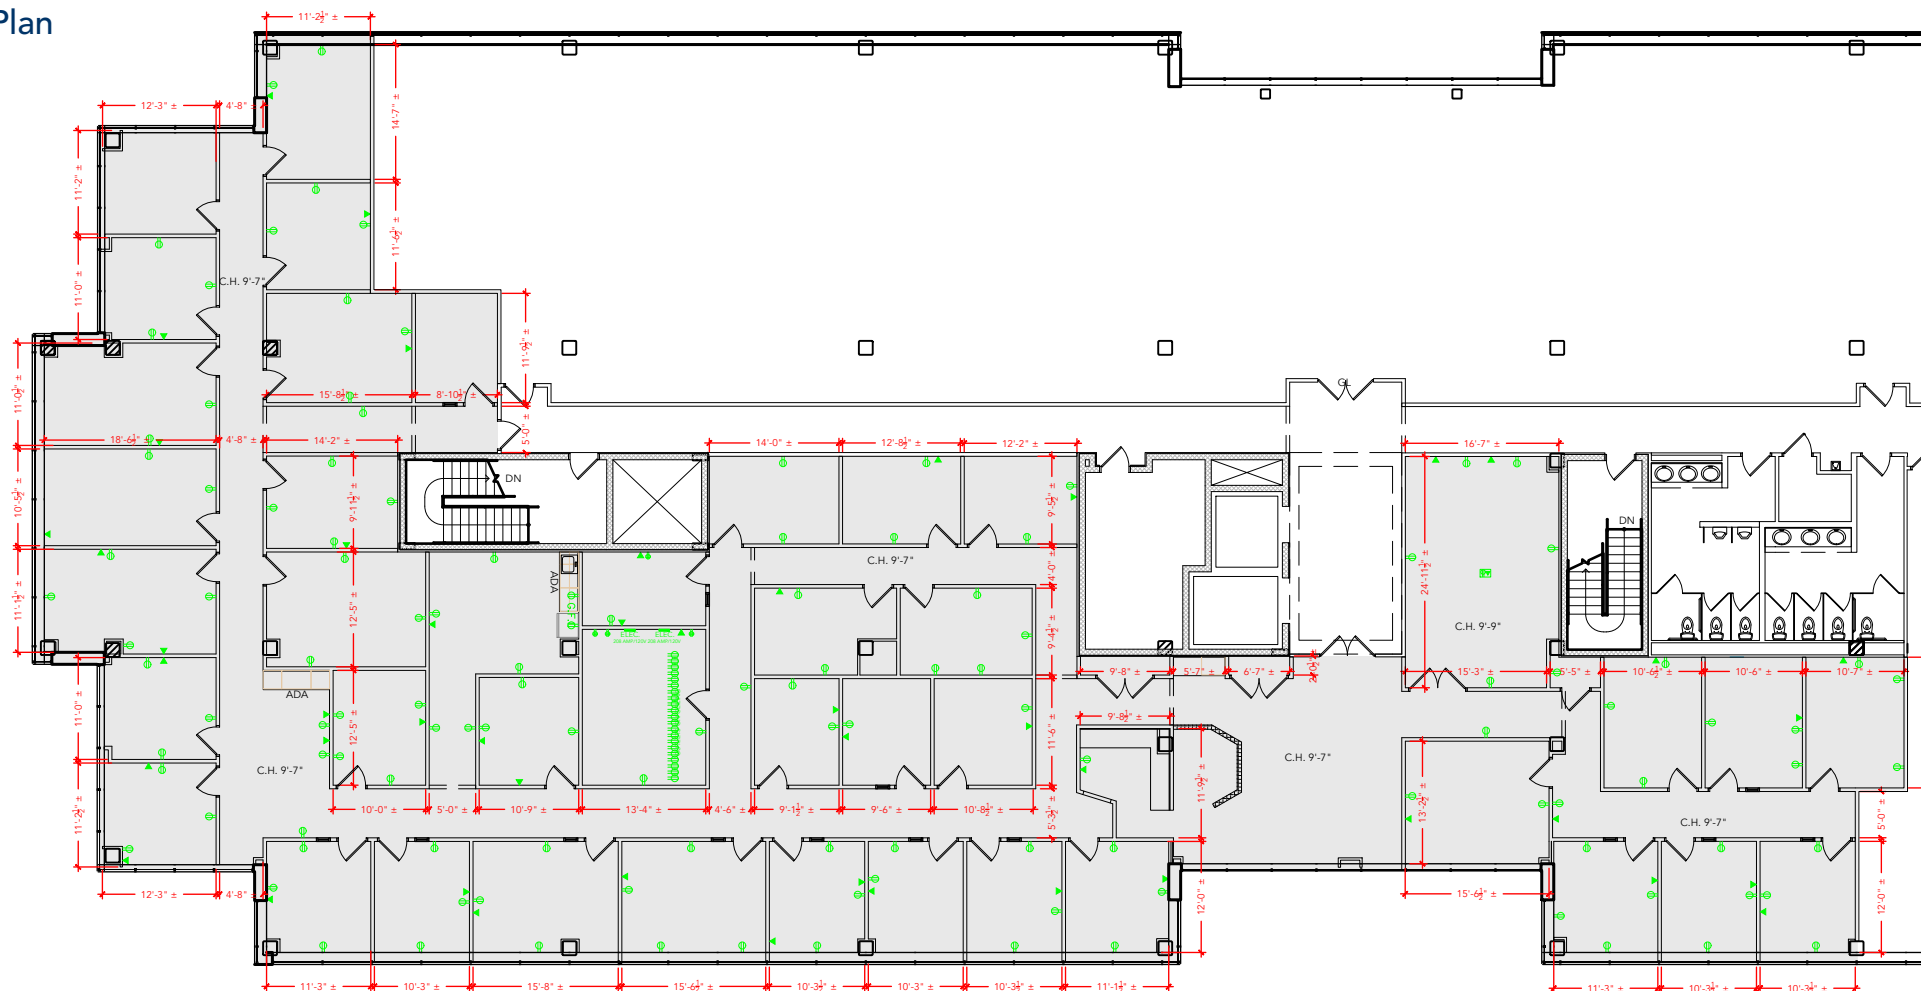

Floor Plan

PLAN NOT TO SCALE - THIS IS NOT A CONSTRUCTION DOCUMENT

DRAWING #: HF4-300-325 ASBUILT DATE: 09.30.2024