


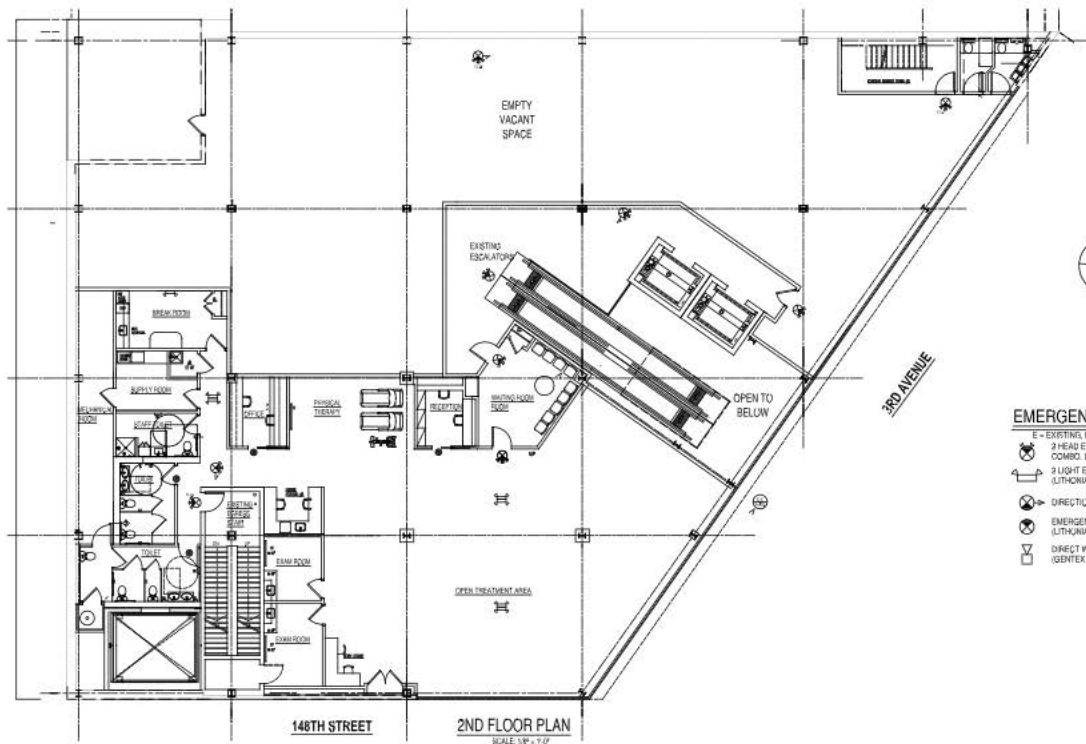

EMERGENCY LIGHTING LEGEND

- E = EXISTING, N = NEW, D = DEMOLISH, R = RELOCATED
- 2 HEAD EMERGENCY EXIT SIGN & LIGHT (8" HIGH LETTERS COMBO UNIT LITONIA LIGHTING LHB080R 120V)
 - 2 LIGHT EMERGENCY BATTERY PACK LIGHT 120V (LITONIA LIGHTING ELMD SURFACE / WALL MOUNTED)
 - DIRECTIONAL EXIT SIGN
 - EMERGENCY EXIT SIGN W/ BATTERY PACK LIGHT 120V (LITONIA LIGHTING ELMD)
 - DIRECT WIRE PHOTOELECTRIC SMOKE ALARM W/ STROBE (GENTEX CORP. MW 7100CS-W)

ENERGY CODE COMPLIANCE

ALL EXTERIOR WALL, WINDOW AND DOORWAYS SHALL COMPLY WITH THE NEW YORK CITY ENERGY CONSERVATION CODE.

ENERGY ANALYSIS
RENDERING OFFICES
OUTDOOR AIR TREATMENT OF EXISTING BUSINESS SPACE
ESTIMATE JUNE 4
APPROVAL NO. 12044

COMPONENT	PROPOSED DESIGN VALUE	CODE-PRESUMED VALUE & CITATION
EXTERIOR WALL ROOF/DOOR ENVELOPE	N/A	6.10 (4-ACTOR)
WINDOW TYPE I	N/A	6.10 (4-ACTOR)
LIGHTING	N/A	LFD = 0.7 WATTS/FT ² (TABLE 6A.1.1)
HEATING & COOLING	N/A	N/A

NOTE: PRODUCTS SHOWN CAN BE REPLACED WITH AN EQUAL PRODUCT. ALL REPLACEMENTS MUST MEET RECENTS CODE REQUIREMENTS. ALL REPLACEMENT PRODUCTS MUST BE SUBMITTED WITH R-9-A-1.1. (5-ACTOR SPECIFICATIONS FOR ARCHITECT REVIEW AND APPROVAL BEFORE ORDERING)

SPECIAL INSPECTIONS

1 FINAL INSPECTION

NYS ENERGY CONSERVATION NOTE:
TO THE BEST OF MY KNOWLEDGE, BELIEF AND PROFESSIONAL JUDGMENT,
THESE PLANS AND SPECIFICATIONS ARE IN COMPLIANCE WITH THE NEW YORK CITY ENERGY CONSERVATION CODE OF 2014.

NOTE:
I HEREBY STATE THAT I HAVE EXERCISED A PROFESSIONAL STANDARD OF CARE IN CERTIFYING THAT THE FILES APPLICATION IS COMPLETE AND IN ACCORDANCE WITH APPLICABLE LAWS AS OF THIS DATE. I AM AWARE THE COMMISSIONER WILL RELY UPON THE TRUTH AND ACCURACY OF THIS STATEMENT. IF NON-COMPLIANCE IS DISCLOSED I AGREE TO NOTIFY THE OWNER OF REMEDIAL MEASURES WHICH MUST BE TAKEN TO MEET DEPARTMENT OF BUILDING REQUIREMENTS.

ELIDEX REALTY
2823 THIRD AVENUE
BRONX, N.Y.

AS-BUILT SECOND FLOOR PLAN

DATE: 07/01/2016
JOB #: 16-25
DRAWN BY: H.P.
CHECKED BY:
DATE: 07/01/2016

SCALE: 1/8" = 1'-0"

PAGE NO.



16-25

16-25

