
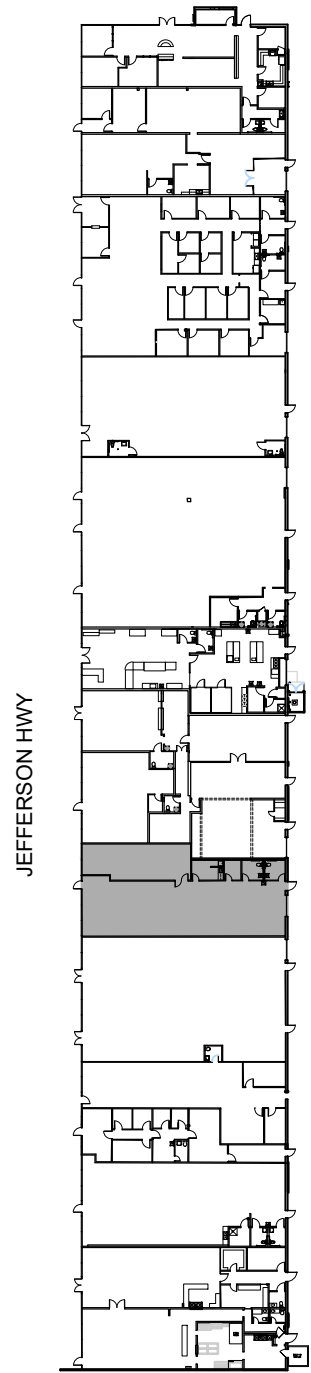


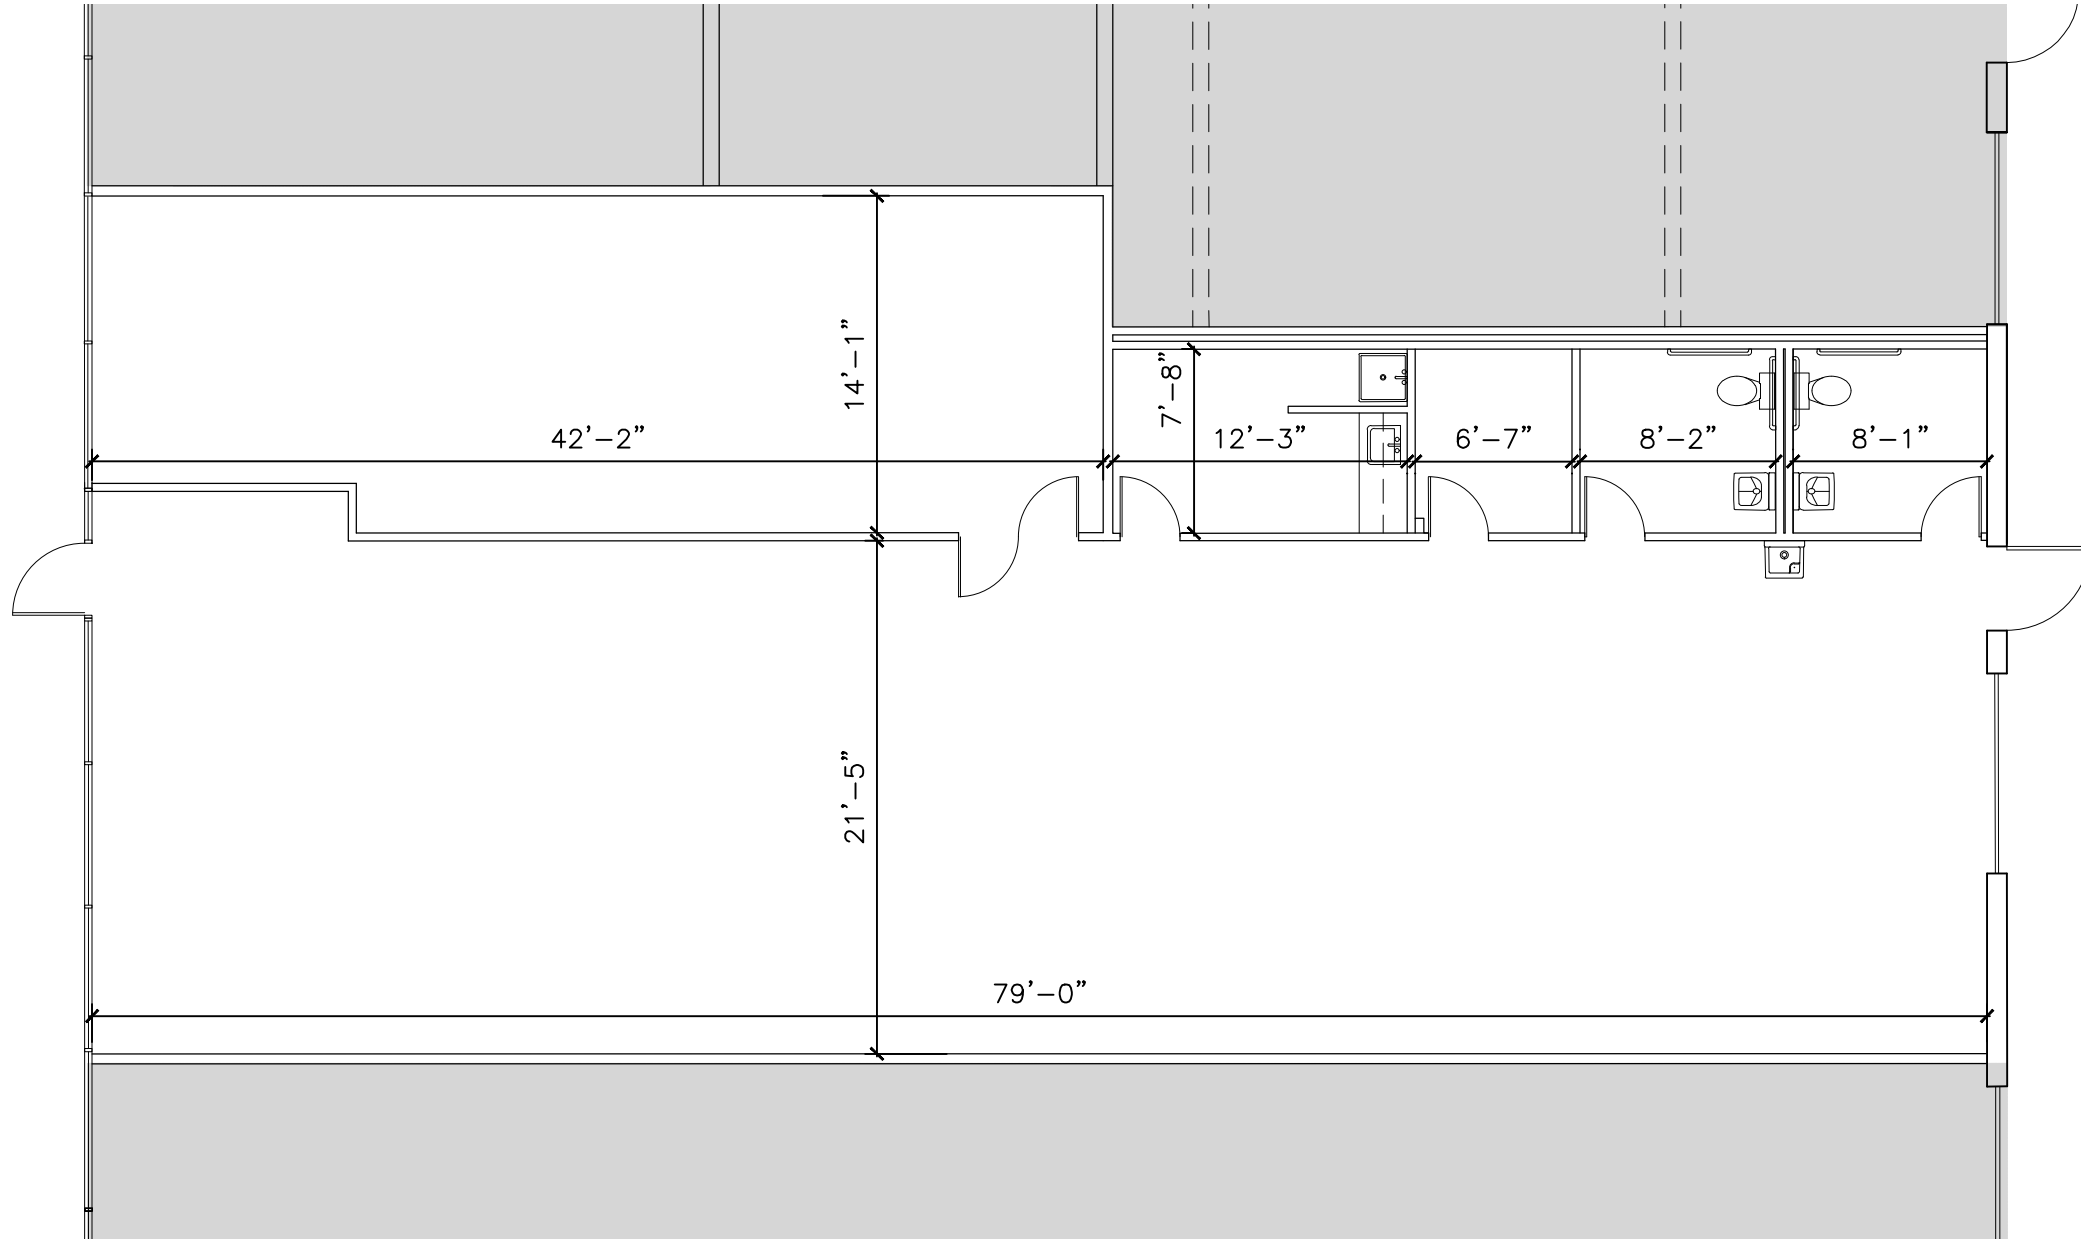

KEY PLAN

1
AB


AS BUILT

SUITE 5626

2,672 USF

SCALE: 1/8" = 1'-0"

PROJECT	SUITE 5626				DATE	08-08-23
	ELMWOOD DISTRIBUTION CENTER				DATE	08-04-23
5600 JEFFERSON HIGHWAY				FLOOR	1	SHEET
				TASK NO.	11033	
				DRAWN BY	MMH	
				CHECKED BY	RHT	
						AB

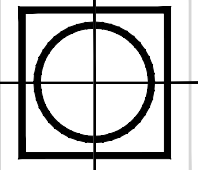

AGL
COMMERCIAL INTERIORS
433 METAIRE ROAD
SUITE 208
METAIRE, LA 70005
504.888.9077

AGLDESIGNS.COM

JEFFERSON HWY