

1035 GODFREY AVE

As-Builts

1035 Godfrey Ave NW, Grand Rapids, MI 49503

SHEET INDEX:

ARCHITECTURAL

T TITLE SHEET & OVERALL PLAN

A1.1 ENLARGED FLOOR PLAN A

A1.2 ENLARGED FLOOR PLAN B

A1.3 ENLARGED FLOOR PLAN C

A1.4 SECOND FLOOR PLAN A

A1.5 SECOND FLOOR PLAN B AND BASEMENT PLAN




124 e. fulton st. ste. 400
grand rapids | michigan
616.451.3041
postassociates.com

1035 GODFREY AVE
As-Builts
1035 Godfrey Ave
Grand Rapids, MI 49503

date	issued for
07-26-2023	REVIEW
file no.	23-31

23-31
sheet no.

A1.1

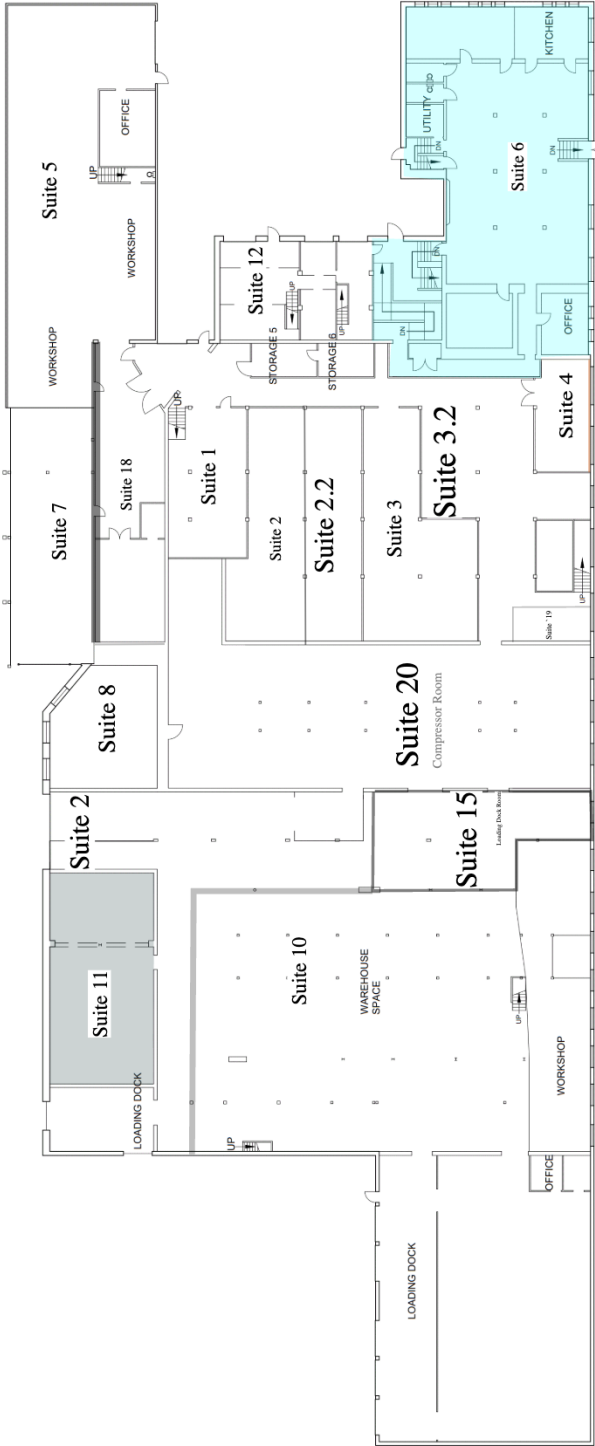

FIRST FLOOR PLAN OVERALL
SCALE: 1/8" = 1'-0"