



## DOCUMENTATION & DETAILING

Plan A Services Corp.

70 Gilbert Street  
Monroe NY 10950

718.219.4749

info@planaservices.com  
planaservices.com

# Project

349 Kent Ave Brooklyn NY 11249

# Drawing

As-built Basement Plan



As-built  
Basement Plan

# A - 001


Area 866 SF

Scale 3/8"=1'-0"

Date 28/12/2021

Drawn By G.R.

Notes AS NOTED

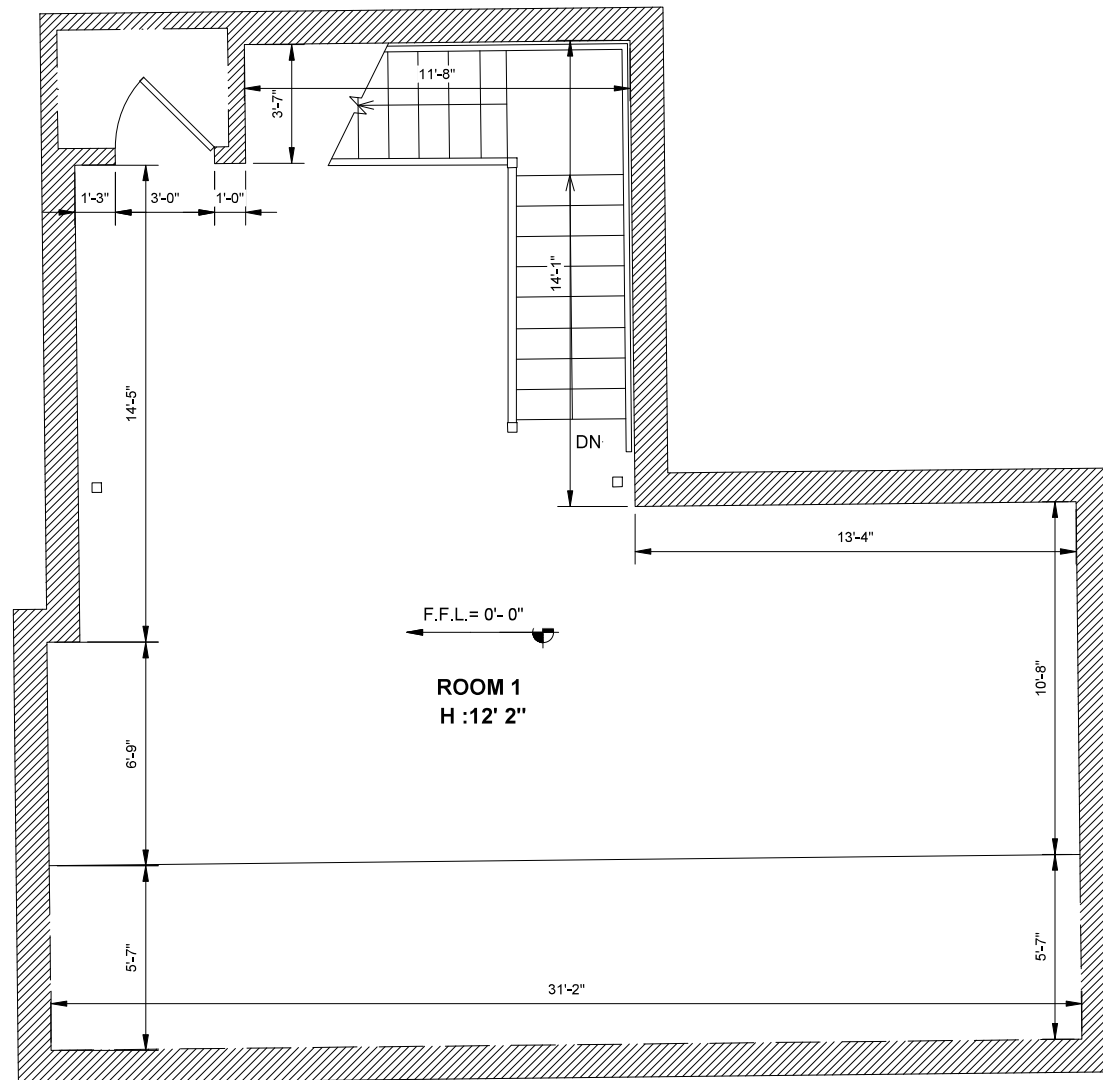

1 Basement

3/8" = 1'-0"

Gross Area = 866 SF  
Net Area= 739 SF




info@planaservices.com  
planaservices.com

349 Kent Ave Brooklyn NY 11249

## As-built Ground Floor Plan

**As-built  
Ground Floor Plan**

|       |          |
|-------|----------|
| Notes | AS NOTED |
|-------|----------|

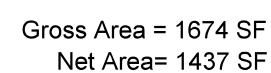

2 Ground Floor  
3/8" = 1'-0"