


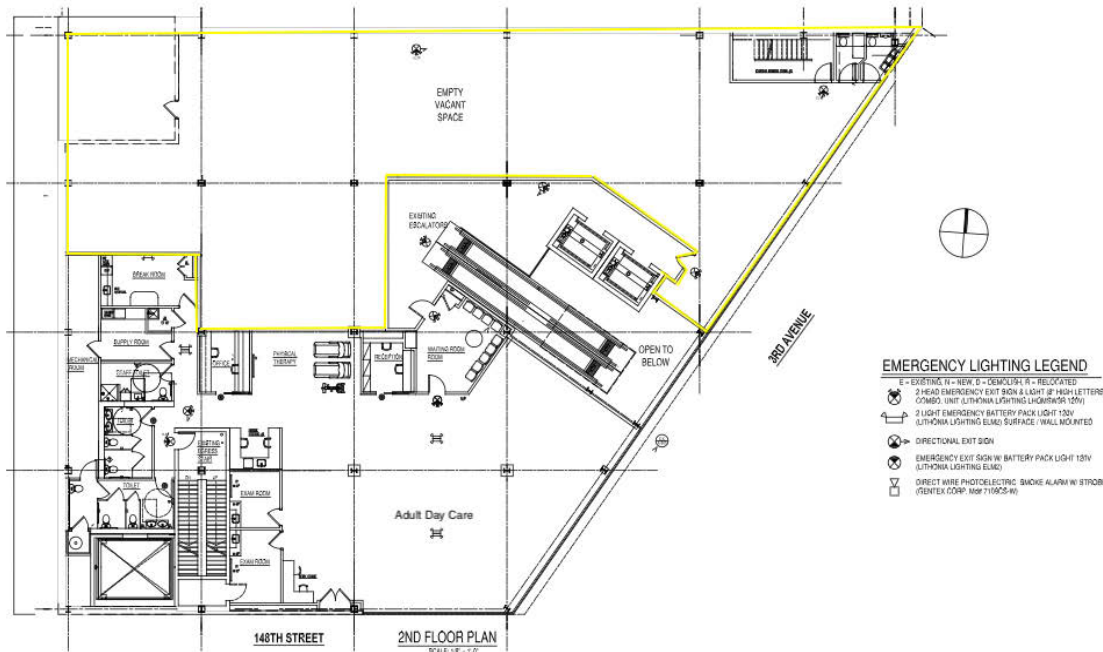

EMERGENCY LIGHTING LEGEND

- EXISTING (E) - NEW (N) - DEMOLISH (D) - RELOCATE (R)
- 2 HEAD EMERGENCY EXIT SIGN & LIGHT (IF HIGH LETTERS COMING UNIT LITHONIA LIGHTING LIGHTRON 120V)
- 2 LIGHT EMERGENCY BATTERY PACK LIGHT 120V (LITHONIA LIGHTING ELMD SURFACE / WALL MOUNTED)
- DIRECTIONAL EXIT SIGN
- EMERGENCY EXIT SIGN W/ BATTERY PACK LIGHT 120V (LITHONIA LIGHTING ELMD)
- DIRECT WIRE PHOTOELECTRIC (SMOKE ALARM W/ STROBE) (FIRETEX CORP. MRP 110025-40)

ENERGY CODE COMPLIANCE

ALL EXISTING WALL, FLOORING AND WINDOW WALL SYSTEMS WITH THE NEW YORK CITY & NEW YORK STATE ENERGY CONSERVATION CODE.

ENERGY ANALYSIS
REQUIREMENTS FOR
INTERIOR ALTERNATION OF EXISTING BUILDING SPACE
AS REQUIRED BY THE
ENERGY CONSERVATION CODE

COMPONENT	PROPOSED DESIGN VALUE	CODE PRESCRIBED VALUE & CITATION
EXTERIOR WALL ROOF TOP ENCLOSURE	N/A	0.31 U-F-FACTOR
WINDOW TYPE 1	N/A	0.31 U-F-FACTOR
LIGHTING	N/A	LPH = 0.7 WATT/FT ² (TABLE 90.1)
HEATING & COOLING	N/A	N/A

NOTE: PRODUCTS SHOWN CAN BE REPLACED WITH AS EQUAL PRODUCTS. ALL REPLACEMENTS MUST MEET ENERGY CODE REQUIREMENTS. ALL REPLACEMENT PRODUCTS MUST BE SUBMITTED WITH A WALL U-F-FACTOR SPECIFICATIONS FOR ARCHITECT REVIEW AND APPROVAL BEFORE ORDERING.

SPECIAL INSPECTIONS

1. FINAL INSPECTION

NOT ENERGY CONSERVATION NOTE
TO THE BEST OF MY KNOWLEDGE, BELIEF AND PROFESSIONAL JUDGMENT
THESE PLANS AND SPECIFICATIONS ARE IN COMPLIANCE WITH THE NEW YORK CITY ENERGY CONSERVATION CODE OF 2016.

NOTE:
I HEREBY STATE THAT I HAVE EXERCISED A PROFESSIONAL STANDARD OF CARE IN CERTIFYING THAT THE FILE APPLICATION IS COMPLETE AND IN ACCORDANCE WITH APPLICABLE LAWS AND OF THIS DATE. I AM AWARE THE COMMISSIONER WILL RELY UPON THE TRUTH AND ACCURACY OF THIS STATEMENT. IF NON-COMPLIANCE IS DISCLOSED I AGREE TO NOTIFY THE OWNER OF REMEDIAL MEASURES WHICH MUST BE TAKEN TO MEET DEPARTMENT OF BUILDING REQUIREMENTS.

nego associates
architects / planners
NEW YORK, NY
TEL 212 463 2540 FAX 212 463 4467 WEB MAIL: CONNOR@NEGOCORP.COM



PLAN ARCHITECTURE AND INTERIOR DESIGNER
NEW YORK, NY
ARCHITECT
NEW YORK, NY
ARCHITECT
NEW YORK, NY
ARCHITECT

ELIDEX REALTY 2823 THIRD AVENUE BRONX, N.Y.	
AS-BUILT SECOND FLOOR PLAN	
DATE:	07/01/2018
JOIN N:	16-25
DRAWN BY:	K.P.
CHECKED BY:	
CHG. NO.	
A 200	01
DATE:	PAGE NO.