



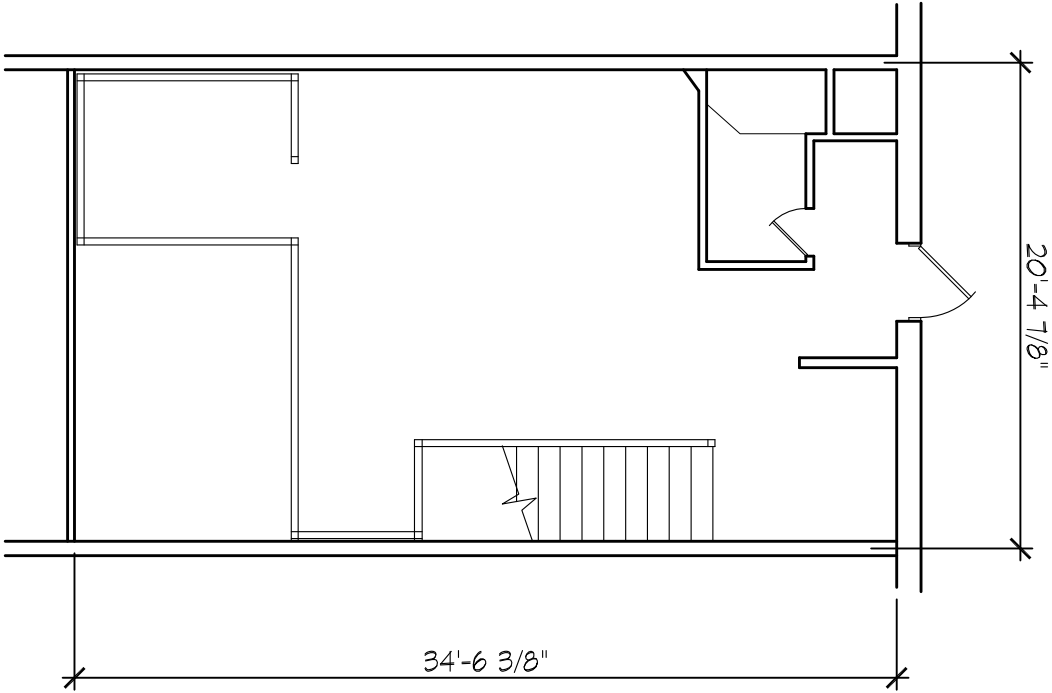

AS BUILT UPPER LEVEL FLOOR PLAN

5892 LEESBURG PIKE
FALLS CHURCH, VIRGINIA
725 s.f.

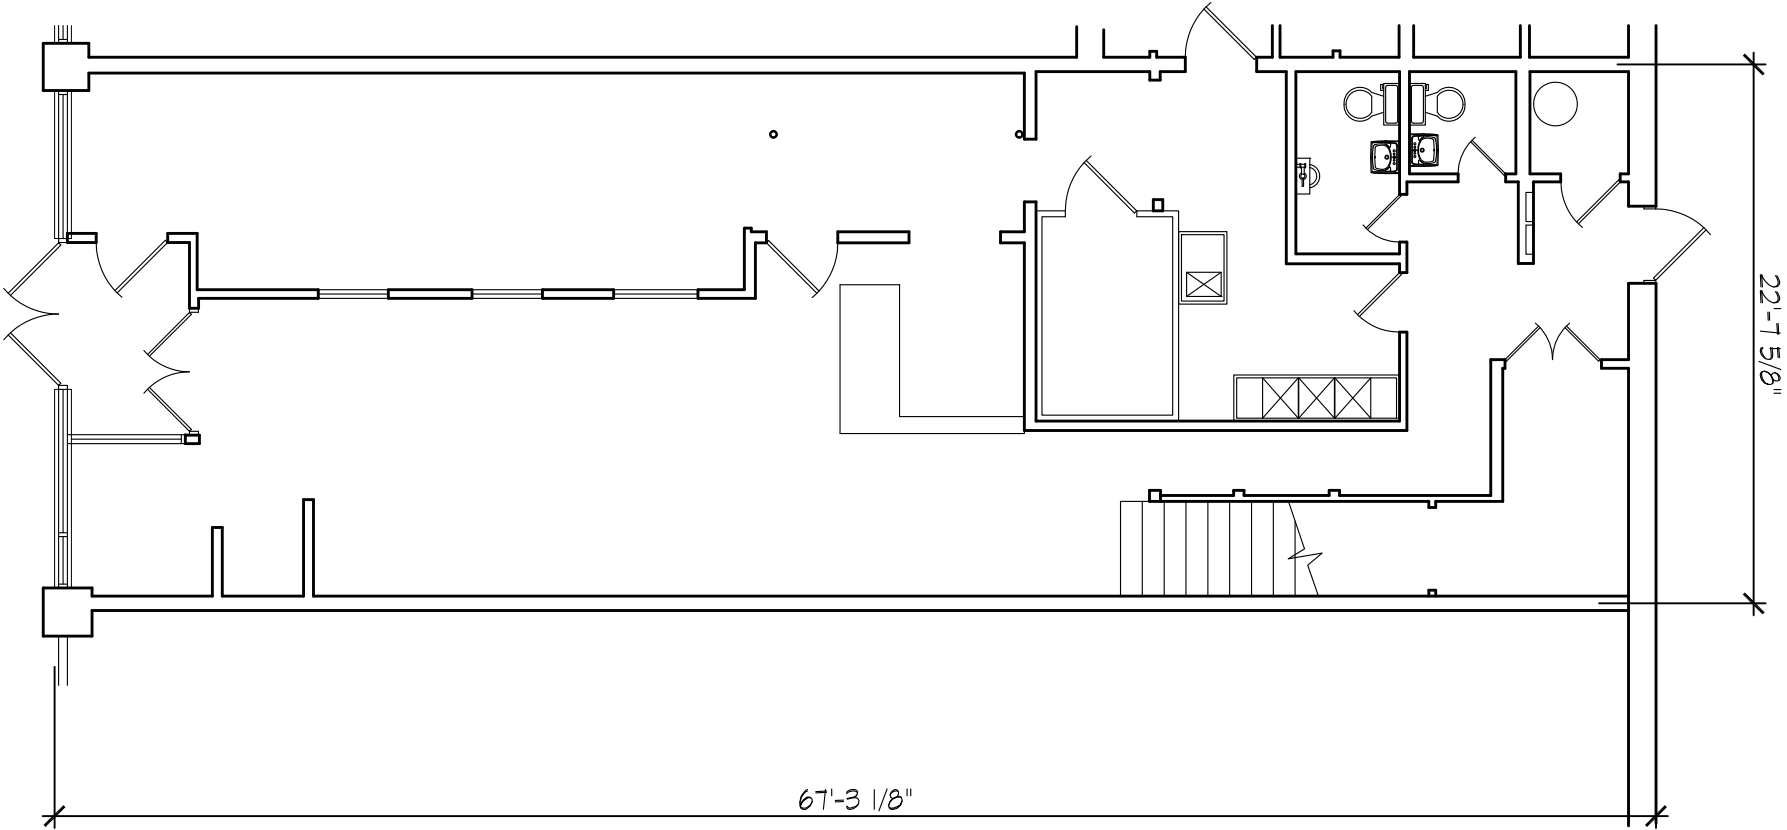

AS BUILT GROUND FLOOR PLAN

5892 LEESBURG PIKE
FALLS CHURCH, VIRGINIA
1,523 s.f.