




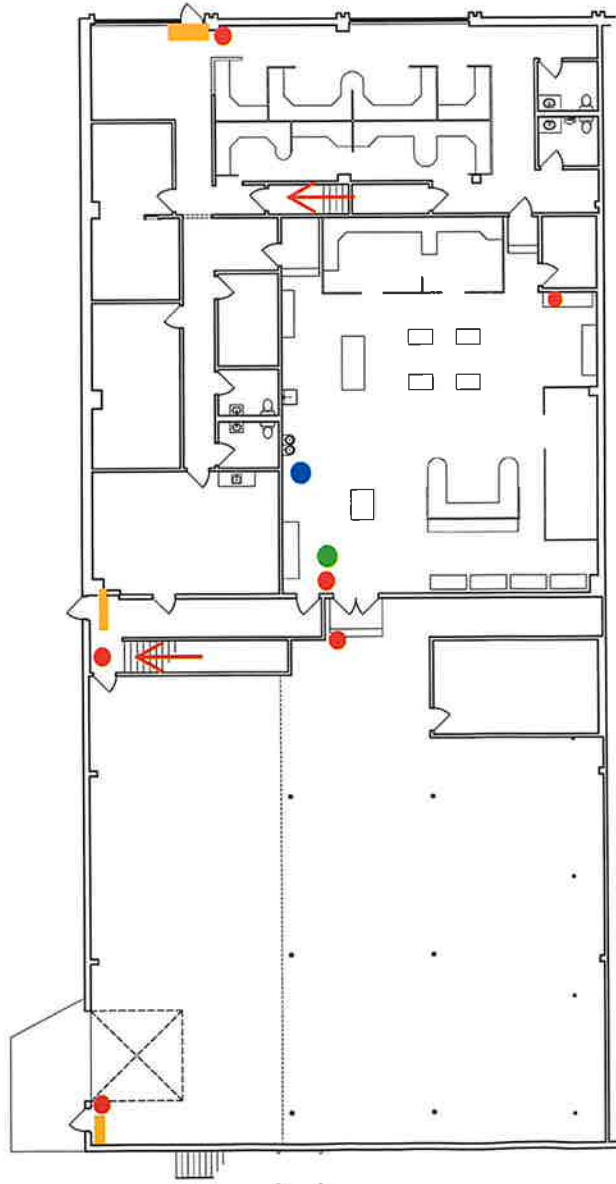


GROUND FLOOR

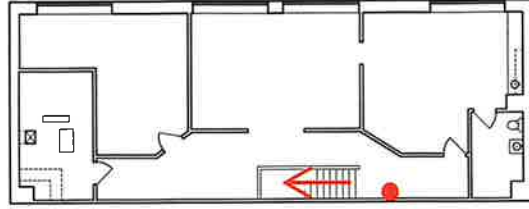

SECOND FLOOR—EAST

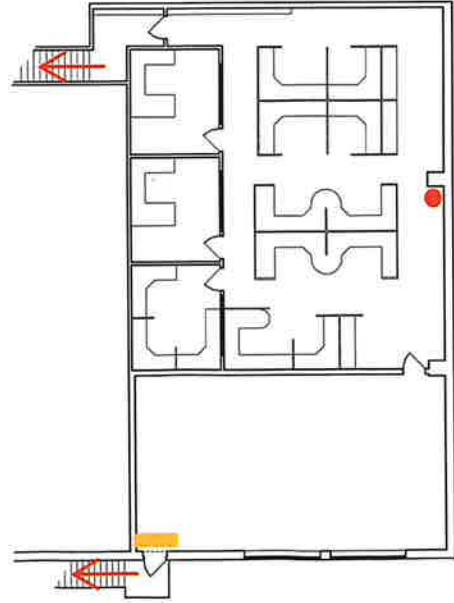

SECOND FLOOR—WEST

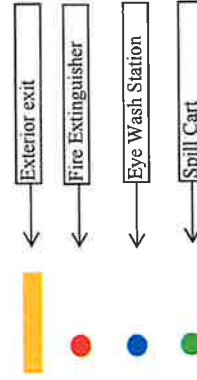

NOTES

1. ALL CALCULATIONS INDICATE "GROSS RETAIL" AREA AS PER "BOMA" STANDARDS.
2. ALL FIXTURES INDICATED ARE BUILT-IN.
3. ALL FLOORS ARE CARPET UNLESS OTHERWISE INDICATED.
4. ALL CEILING HEIGHTS ARE 8'-0"
5. UNLESS OTHERWISE NOTED, ALL DIMENSIONS TO BE FIELD VERIFIED PRIOR TO ANY CONSTRUCTION.
6. ALL AREA CALCULATIONS EXCLUDE STAIRWELL PENETRATIONS.

AREA CALCULATIONS:

FIRST FLOOR AREA 10349.71 SQ. FT.
SECOND FLOOR AREA 5036.08 SQ. FT.

PROJECT: 6819 ACADEMY PARKWAY W. N.E.		DESCRIPTION: AS-BUILT DRAWING		CLIENT: RELIOS INC.				YCD DESIGNS 505-899-1199	
SHEET # 01		OF 01		MEASURED BY P.M.		DESIGNED BY N.A.		DRAFTED BY P.M.	
				CHECKED BY M.G.		REVISED: 05/10/13		DATE 11/24/10	
SCALE 1/16"=1'-0"									