



Unit 223

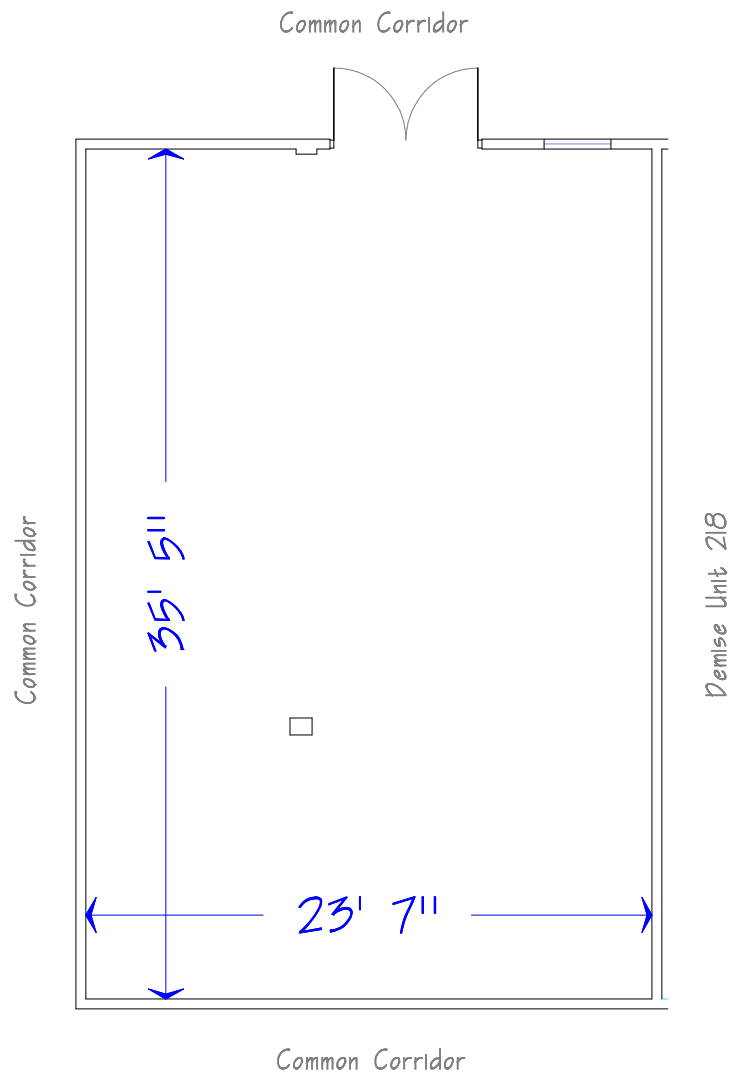

Unit 223
2770 Dufferin St
Toronto, Ontario

as measured April 19, 2024

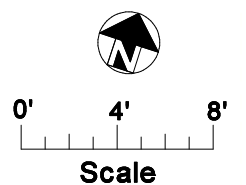

measured
as built
(416) 465-4554