


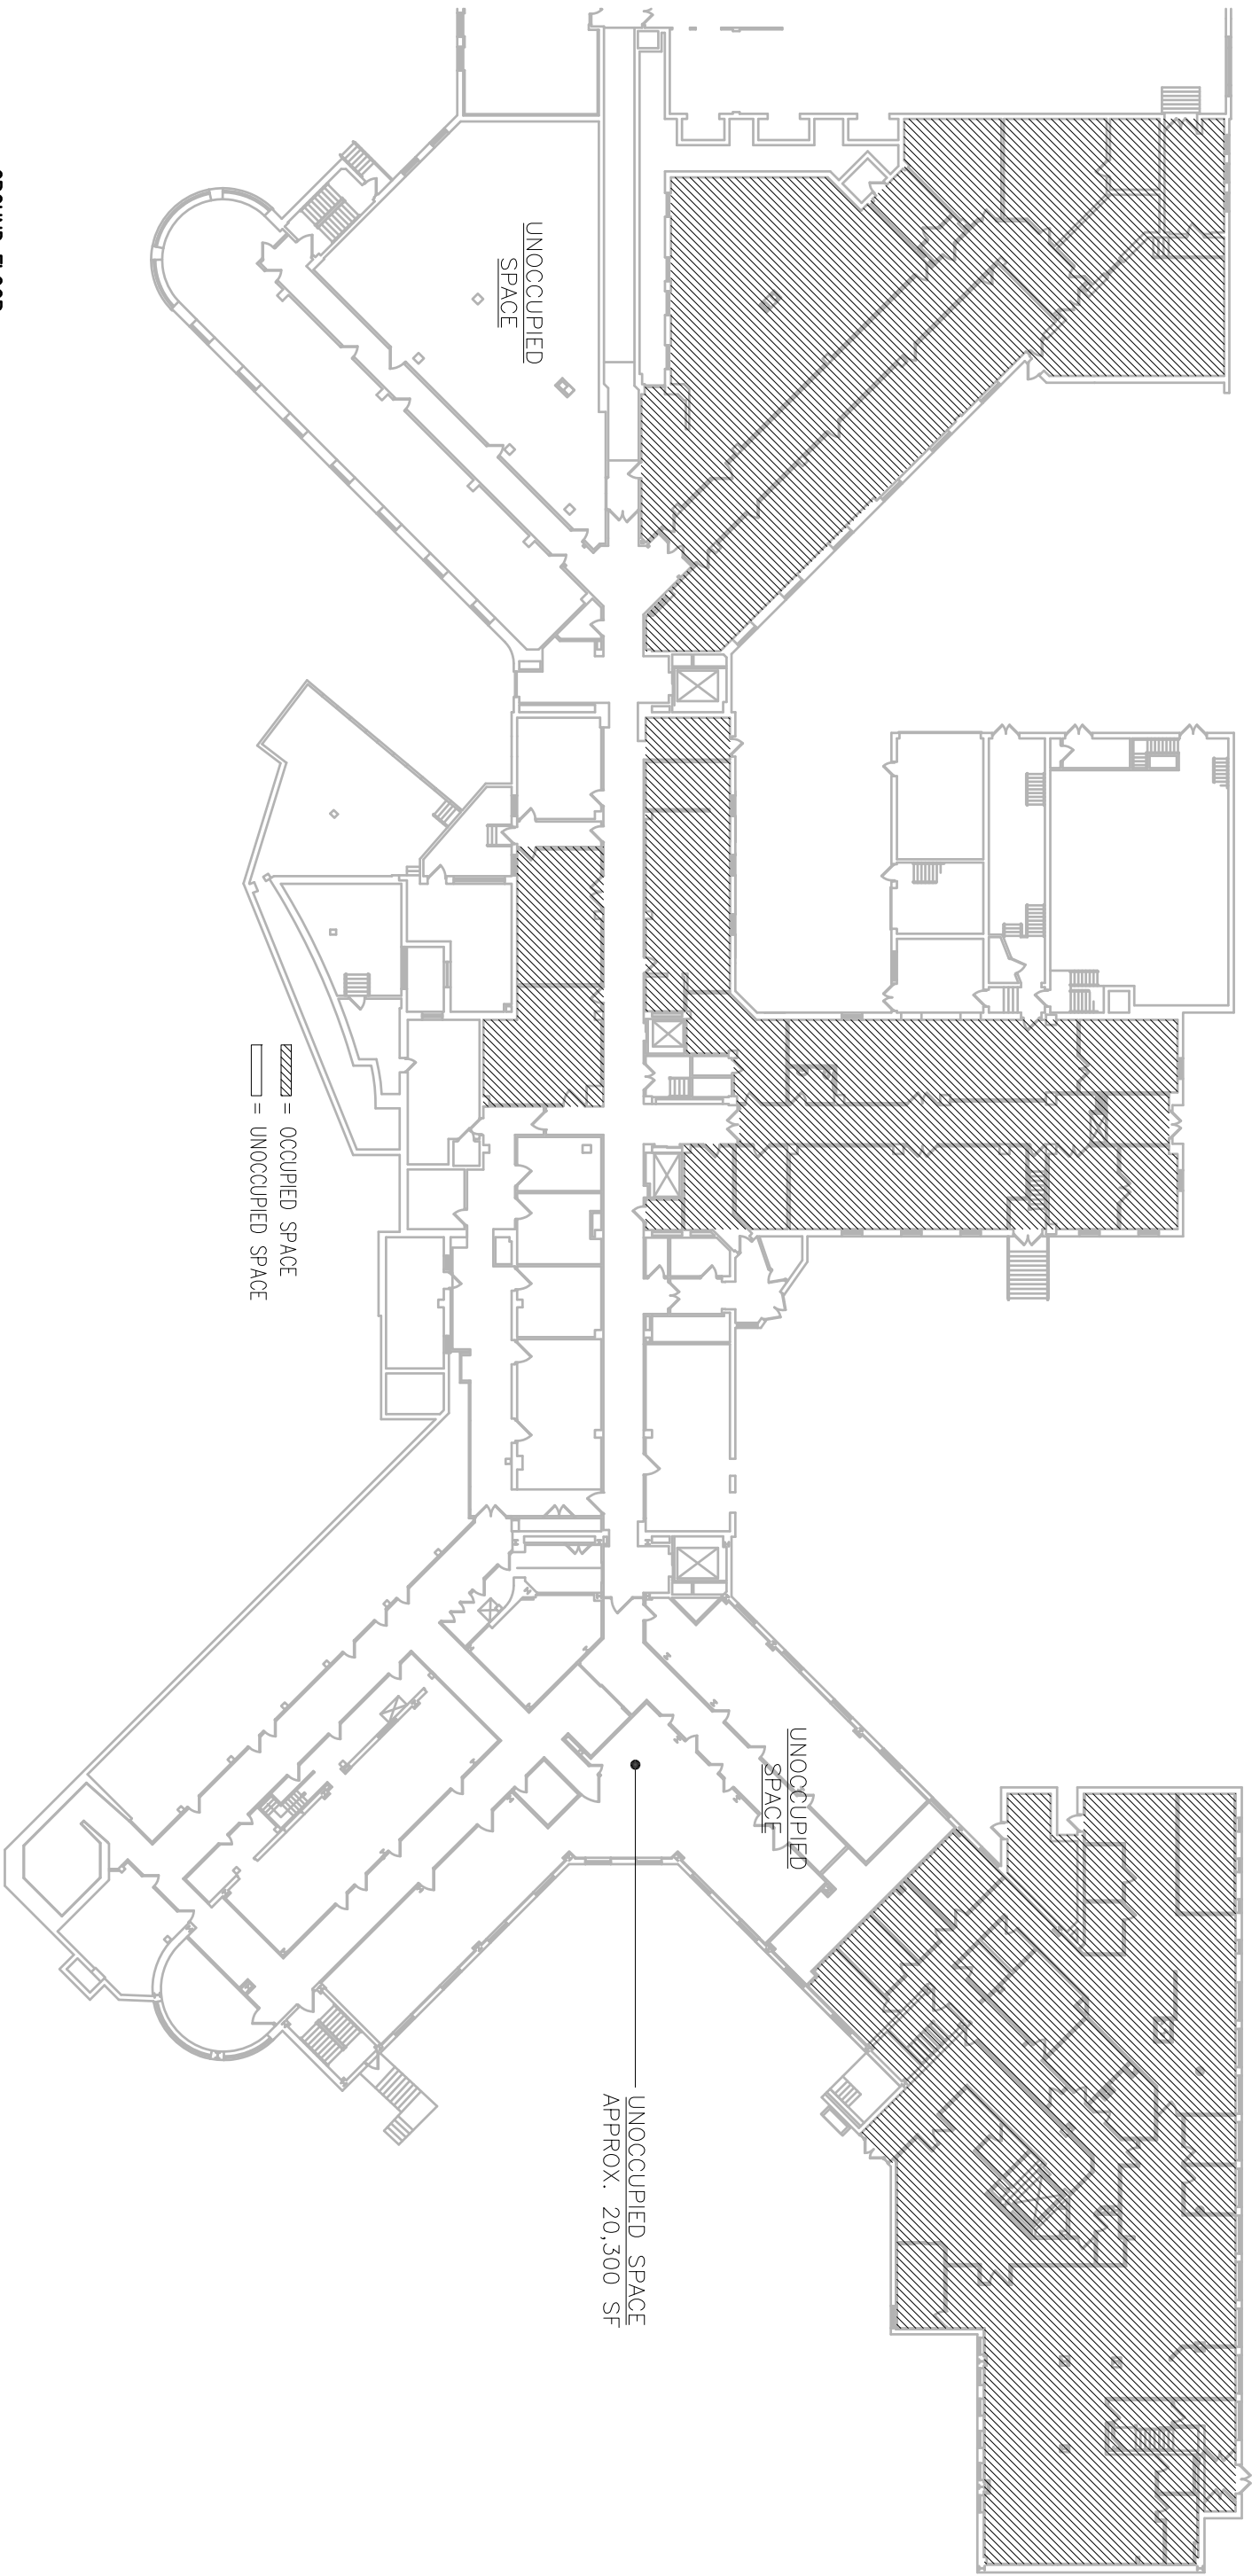

UNOCCUPIED
SPACE

UNOCCUPIED
SPACE

UNOCCUPIED SPACE
APPROX. 20,300 SF

===== OCCUPIED SPACE
===== UNOCCUPIED SPACE

GROUND FLOOR
SCALE: 1/16" = 1'-0"

DRAWING TITLE

ONE PENN CENTER
for
PENN CENTER HARRISBURG, LP.
WORKING AS-BUILT PLANS

2601 North Third Street Harrisburg PA 17110

Darrell F. Sunday Associates, Inc.
Architecture, Planning & Design

ONE PENN CENTER
2601 North 3rd Street Suite 501 Harrisburg, PA 17110
tel.: 717-232-2270 fax: 717-232-2747

DATE 08.28.10


REVISION

DRAWN BY: SJS

PROJECT NUMBER: 08-006

DRAWING NUMBER

A-1.0

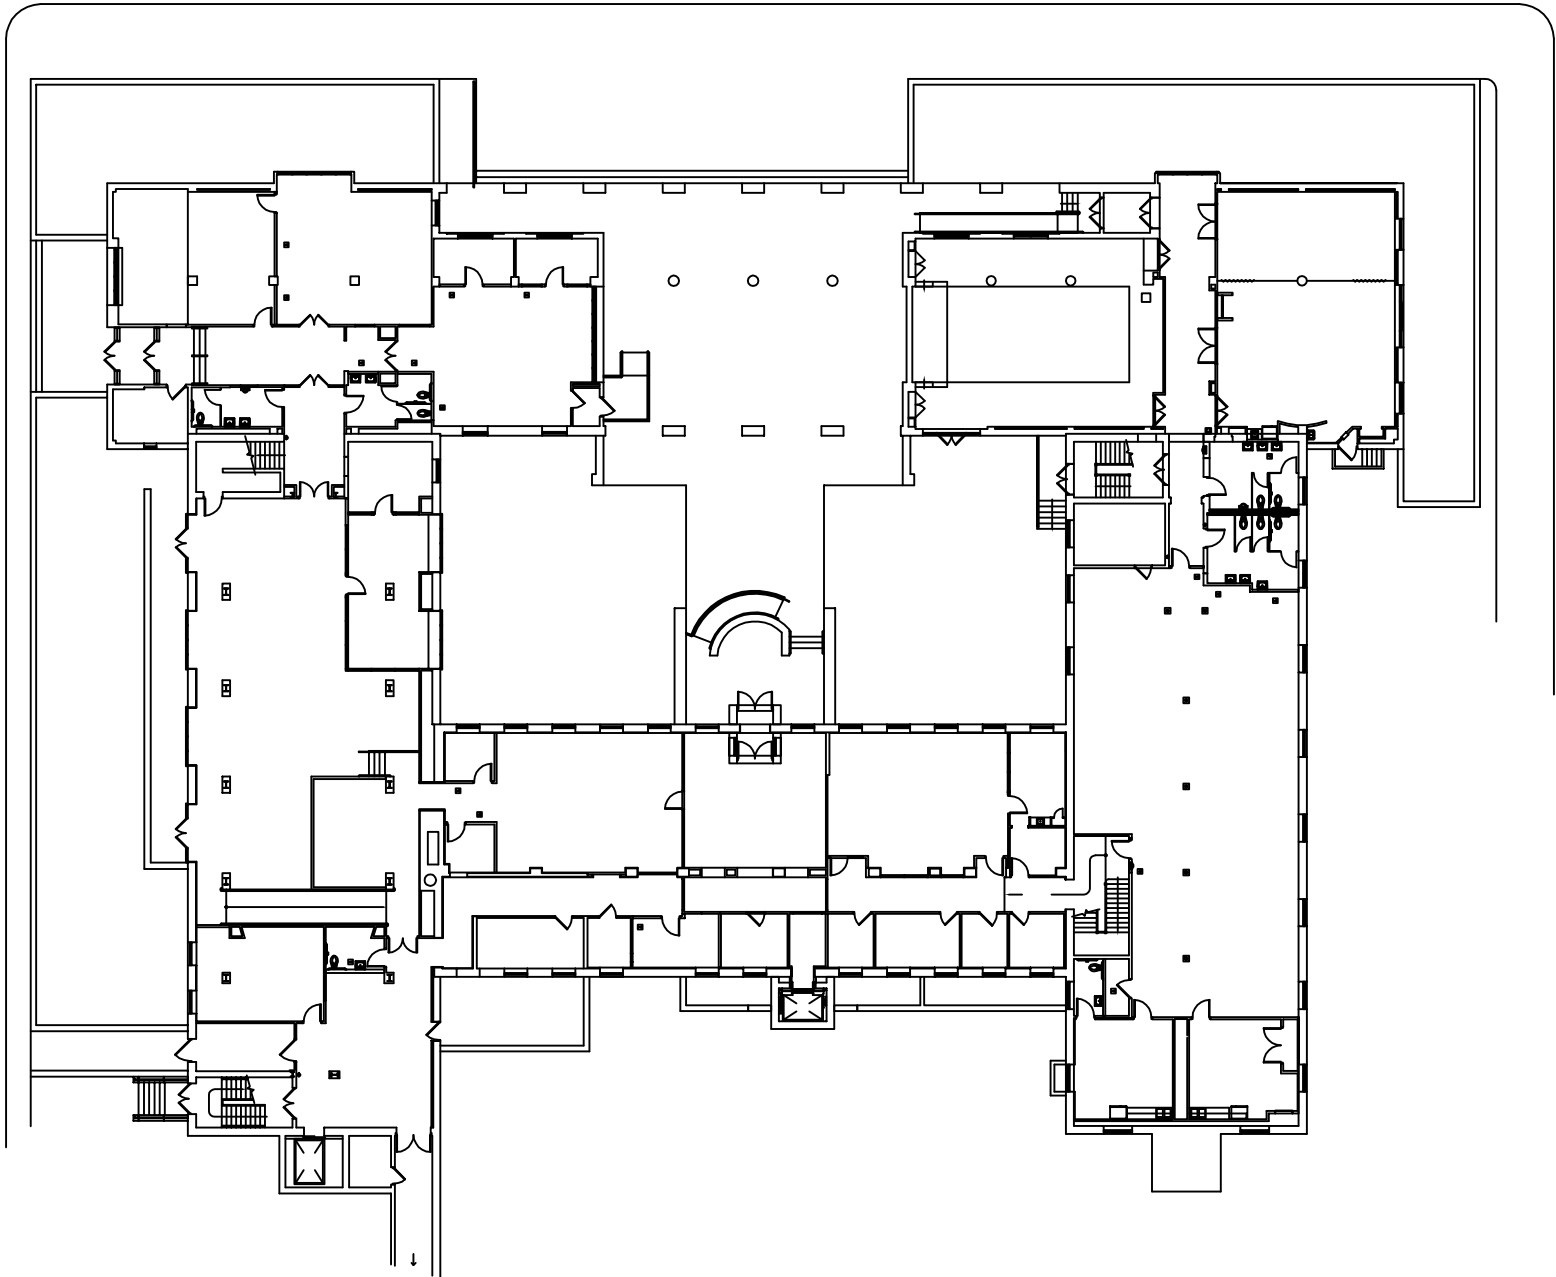

FIRST FLOOR PLAN
SCALE: 1/8" = 1'-0"

DRAWING TITLE
FIRST FLOOR PLAN

DATE 4/20/2010

REVISION

DRAWN BY: SJS

PROJECT NUMBER: 08-006

DRAWING NUMBER


THREE PENN CENTER
for
PENN CENTER, HARRISBURG LP.
WORKING AS-BUILT PLANS

349 Wiconisco Street Harrisburg PA 17601

Darrell F. Sunday Associates, Inc.
Architecture, Planning & Design

ONE PENN CENTER

2601 North 3rd Street Suite 501 Harrisburg, PA 17110
tel.: 717-232-2270 fax: 717-232-2747

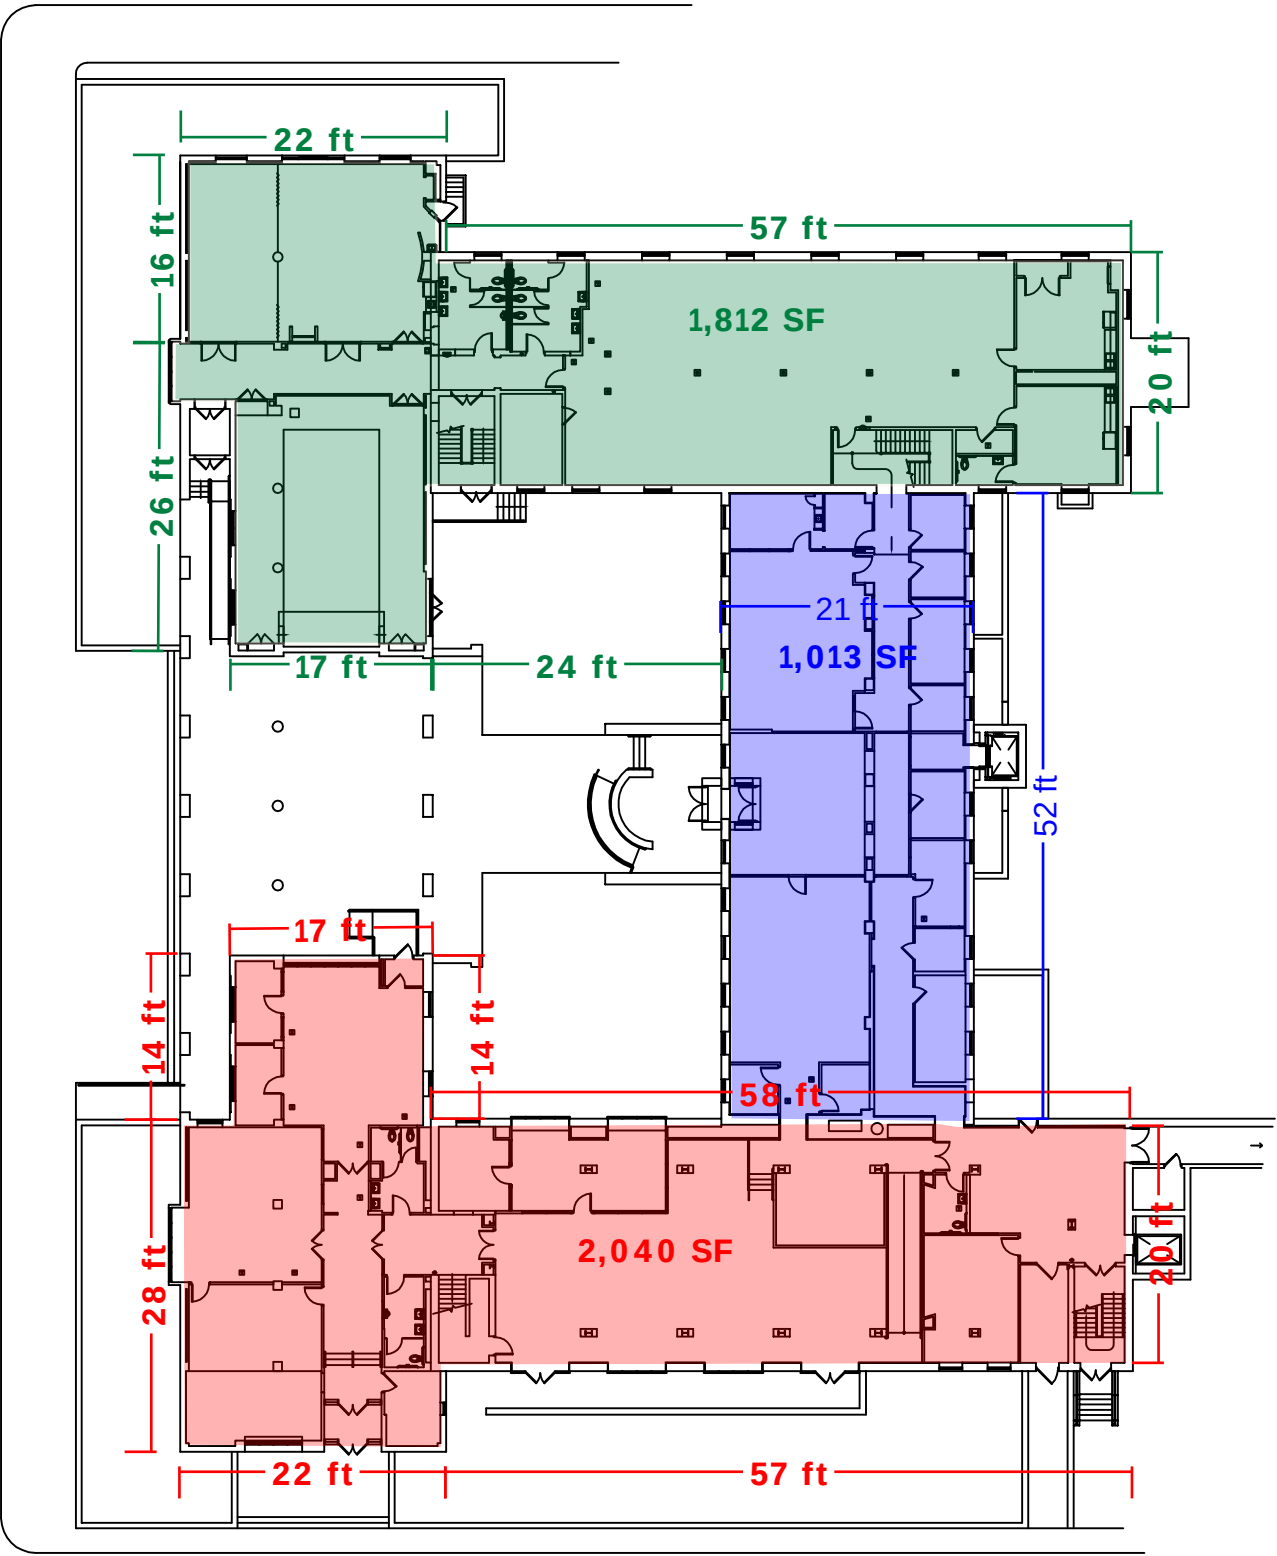


FIRST FLOOR PLAN
SCALE: 1/16" = 1'-0"

Darrell F. Sunday Associates, Inc.
Architecture, Planning & Design
ONE PENN CENTER
2601 North 3rd Street Suite 501 Harrisburg, PA 17110
tel.: 717-232-2270 fax: 717-232-2747

THREE PENN CENTER
for
PENN CENTER, HARRISBURG LP.
WORKING AS-BUILT PLANS
349 Wiconisco Street Harrisburg PA 17601

DRAWING TITLE	FIRST FLOOR PLAN
DATE	4/20/2010
REVISION	
DRAWN BY: SMS	
PROJECT NUMBER	08-006
DRAWING NUMBER	

A-1.0

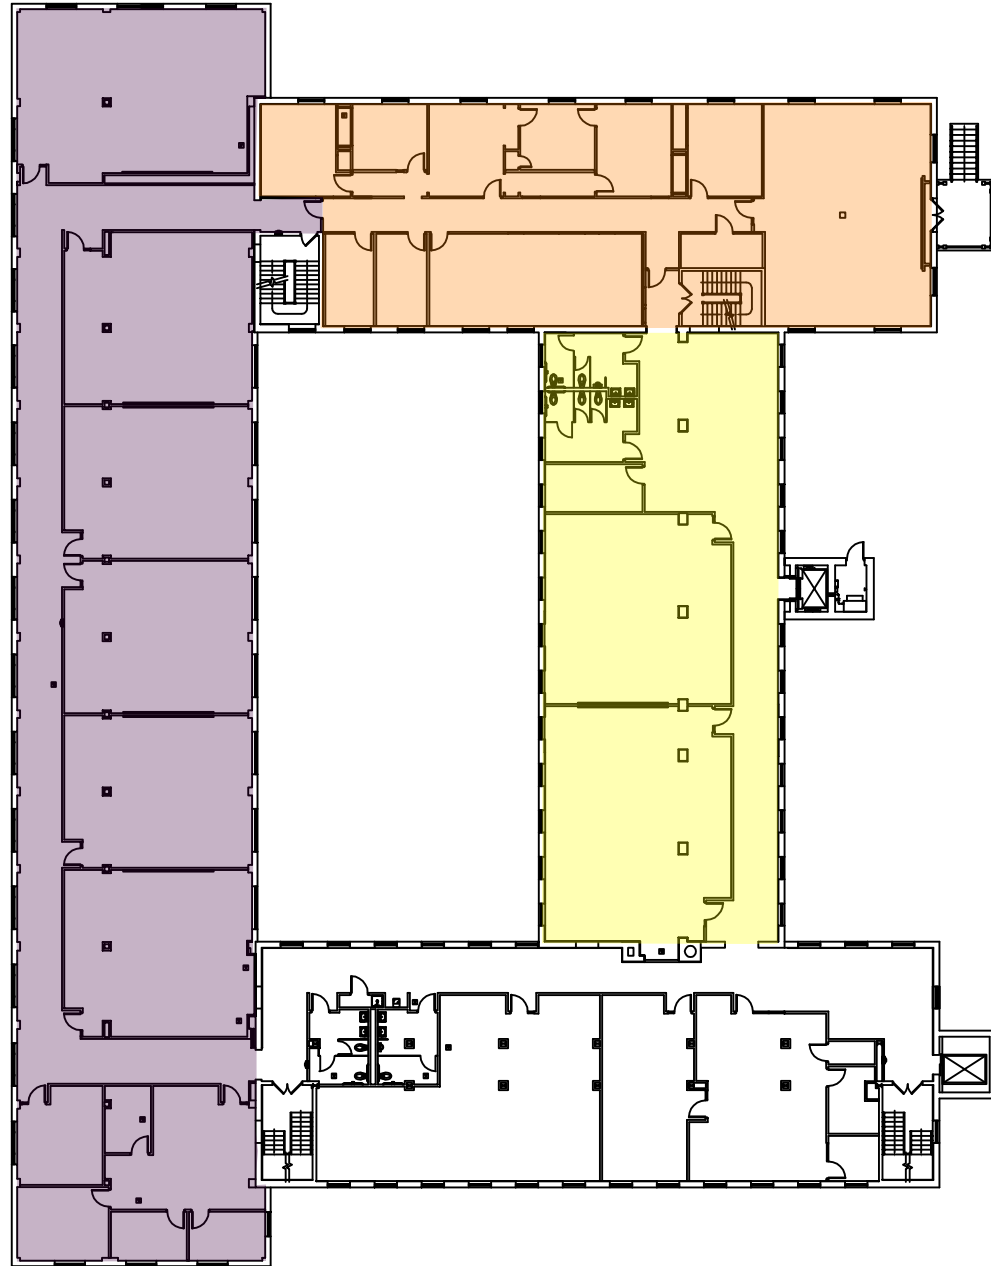


SECOND FLOOR PLAN
SCALE: 1/16" = 1'-0"

DRAWING TITLE
SECOND FLOOR PLAN
DATE 4/20/2010
REVISION
DRAWN BY: SMS
PROJECT NUMBER 08-006
DRAWING NUMBER

THREE PENN CENTER
for
PENN CENTER, HARRISBURG LP.
WORKING AS-BUILT PLANS

Darrell F. Sunday Associates, Inc.
Architecture, Planning & Design
ONE PENN CENTER
2601 North 3rd Street Suite 501 Harrisburg, PA 17110
tel: 717-232-2270 fax: 717-232-2747

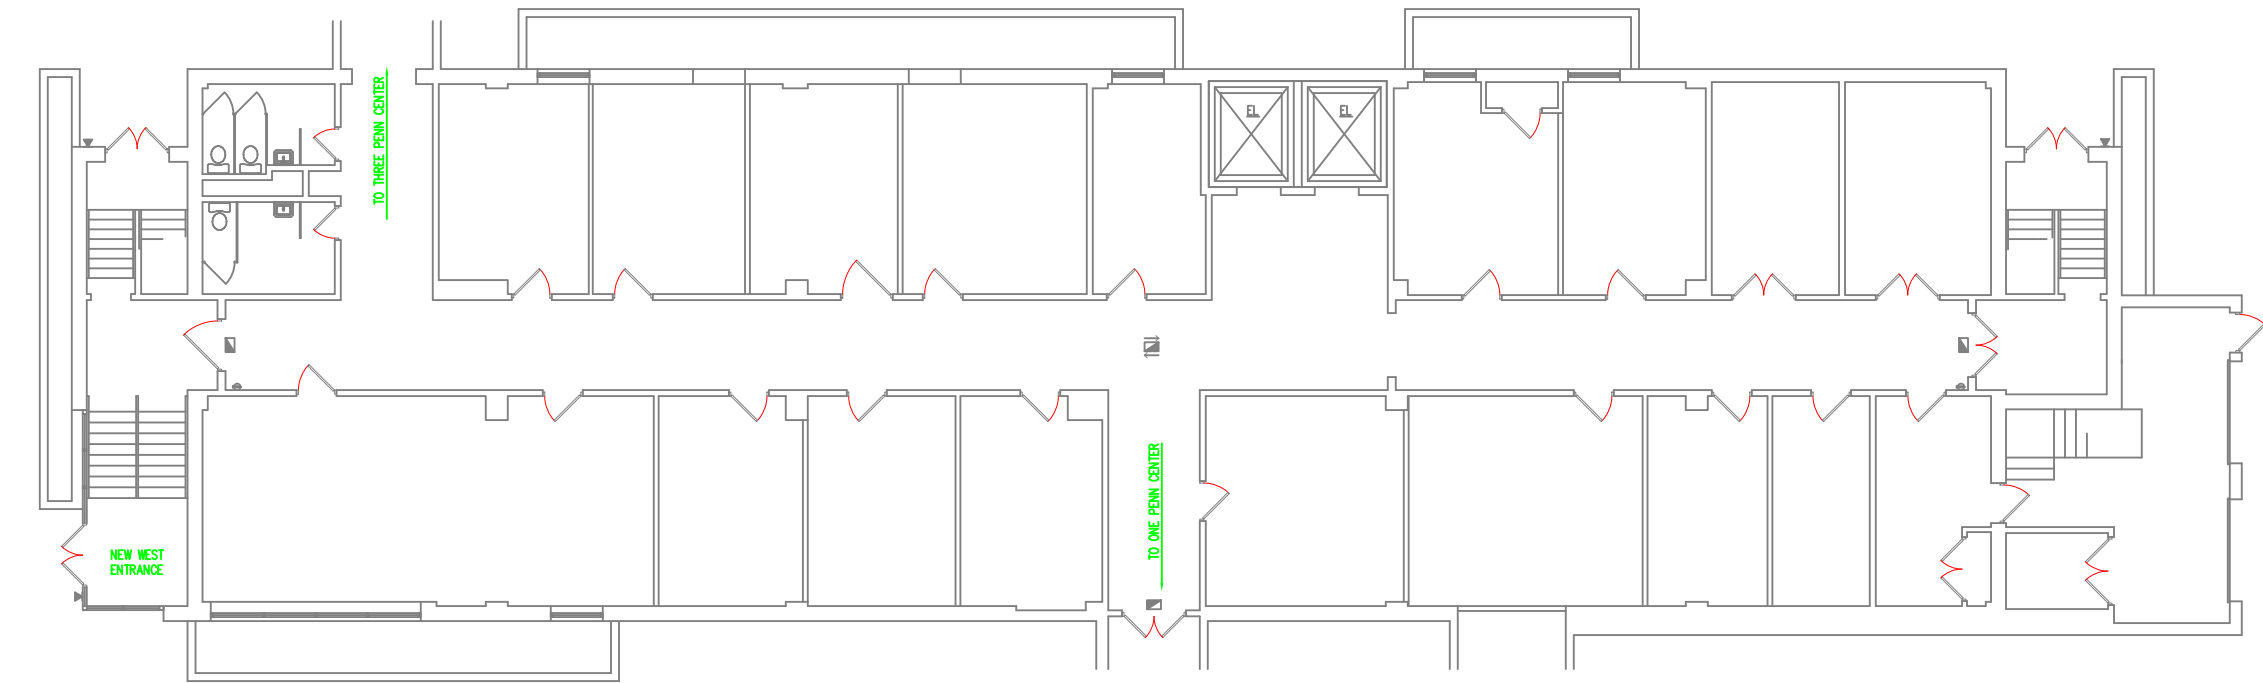

FIRST FLOOR PLAN
SCALE: 1/16" = 1'-0"

PENN CENTER HARRISBURG
TWO PENN CENTER
2643 NORTH THIRD STREET
HARRISBURG PENNSYLVANIA 17110

Darrell F. Sunday Associates, Inc.
Architecture, Planning & Design
ONE PENN CENTER
2601 North 3rd Street Suite 501 Harrisburg, PA 17110
tel.: 717-232-2270 fax: 717-232-2747

DRAWING TITLE
FIRST FLOOR PLAN

DATE 08-11-09


REVISION

DRAWN BY SMS

PROJECT NUMBER

DRAWING NUMBER

A1

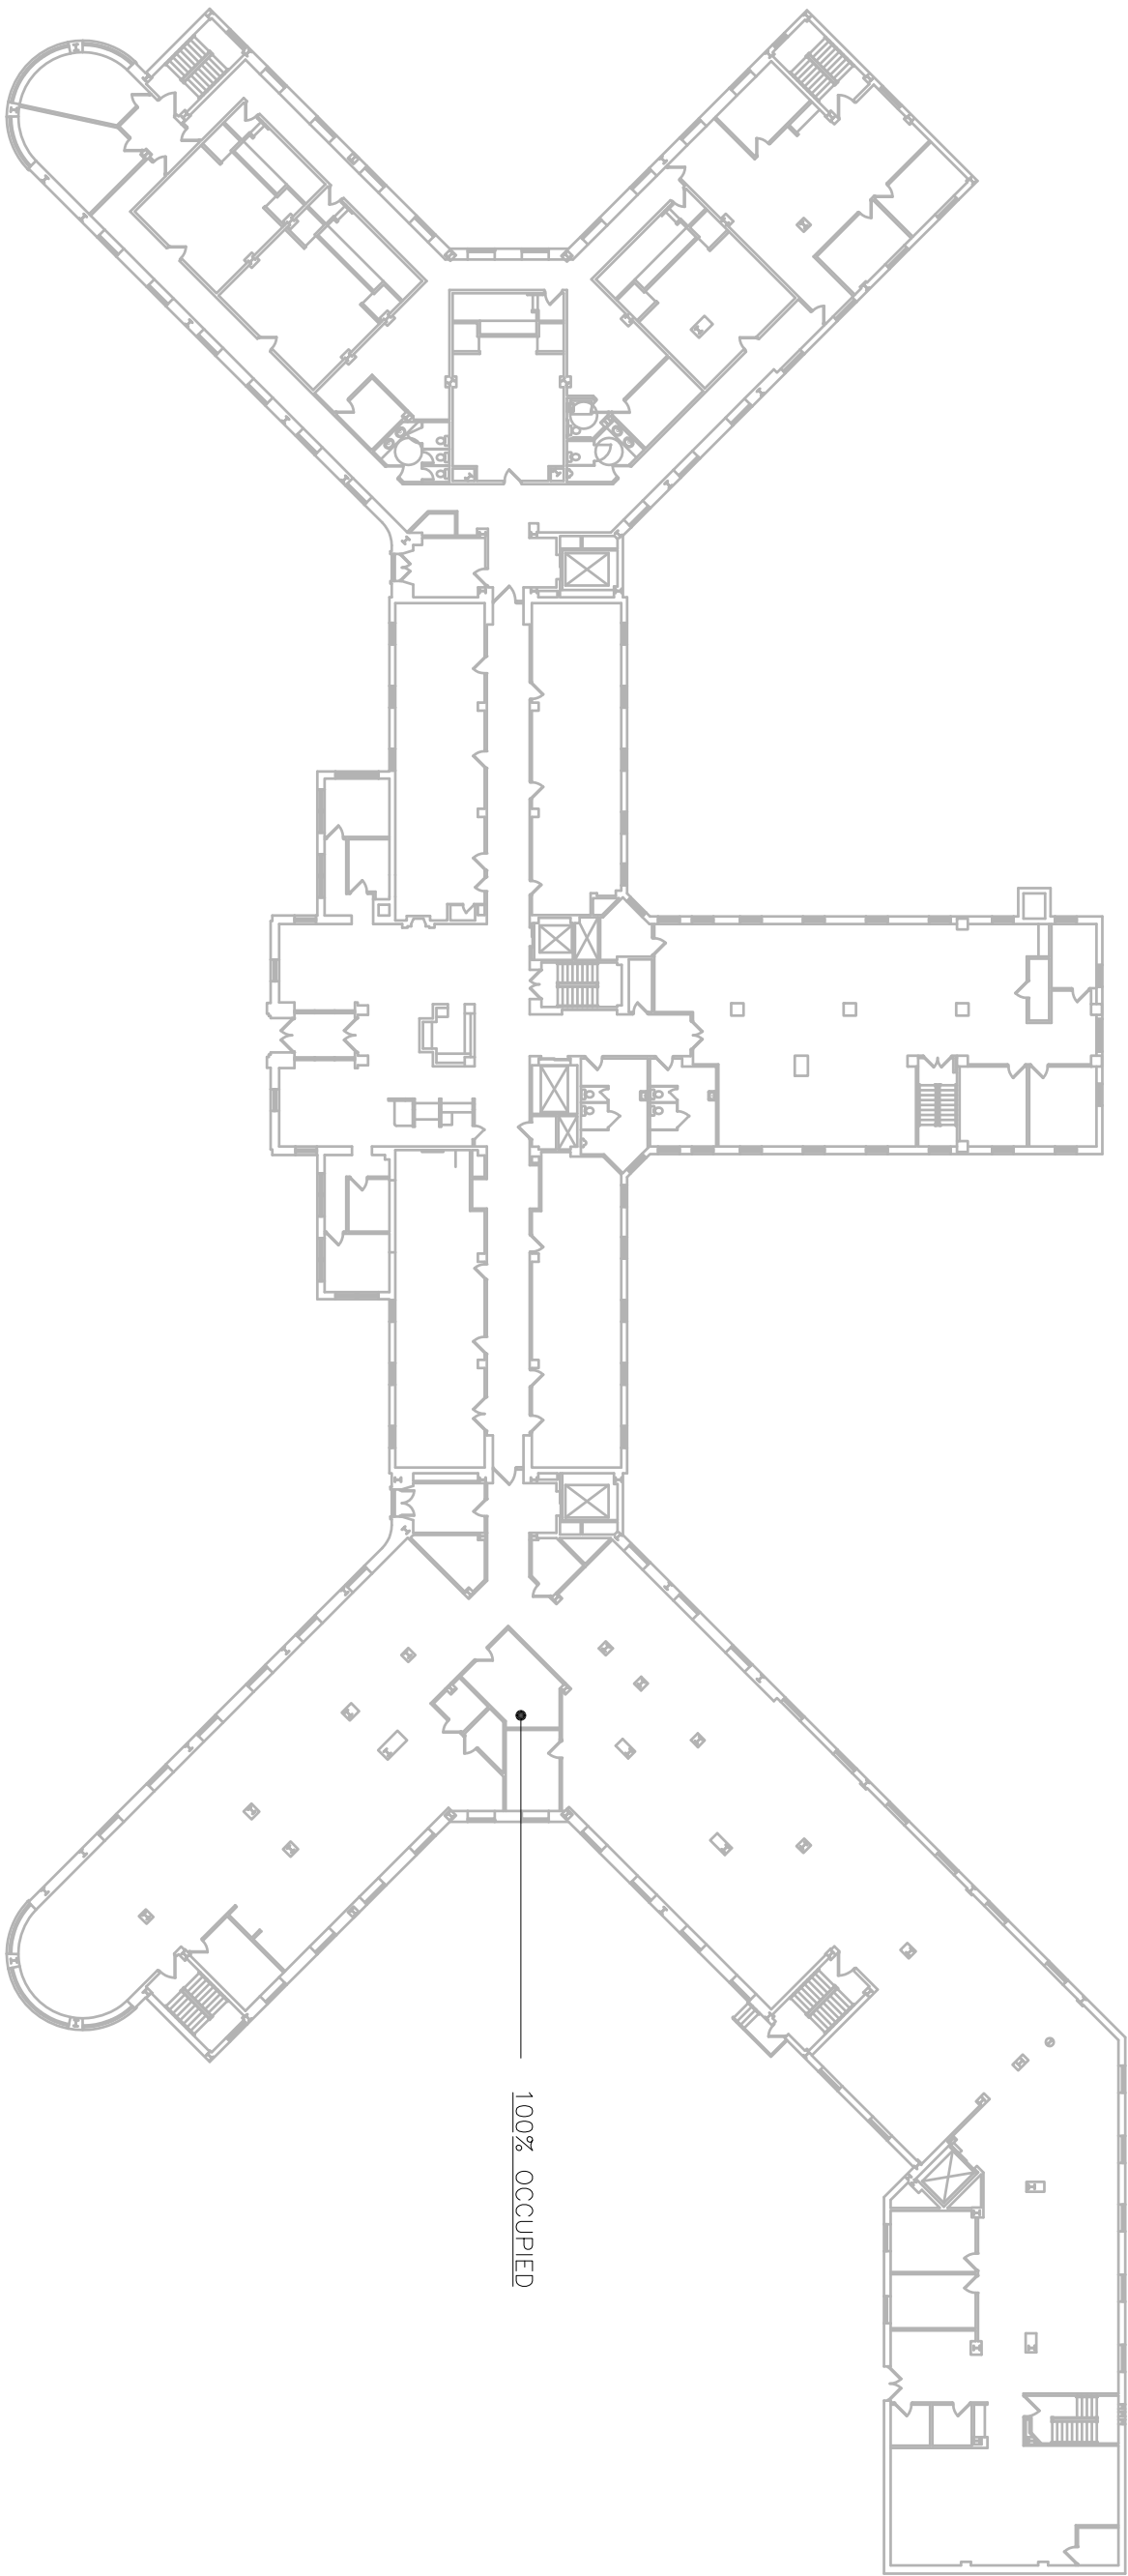

SECOND FLOOR / MAIN LOBBY
SCALE: 1/8" = 1'-0"

100% OCCUPIED

ONE PENN CENTER
for
PENN CENTER HARRISBURG, LP.
WORKING AS-BUILT PLANS

2601 North Third Street Harrisburg PA 17110

Darrell F. Sunday Associates, Inc.
Architecture, Planning & Design

ONE PENN CENTER
2601 North 3rd Street Suite 501 Harrisburg, PA 17110
tel.: 717-232-2270 fax: 717-232-2747

DRAWING TITLE

DATE: 08-28-10

DESIGNER

CHECKED

PROJECT NUMBER: 08-006


DRAWN BY: SJS

PROJECT NUMBER: 08-006

DRAWING NUMBER

A-2.0

SECOND FLOOR PLAN
SCALE: 1/8" = 1'-0"

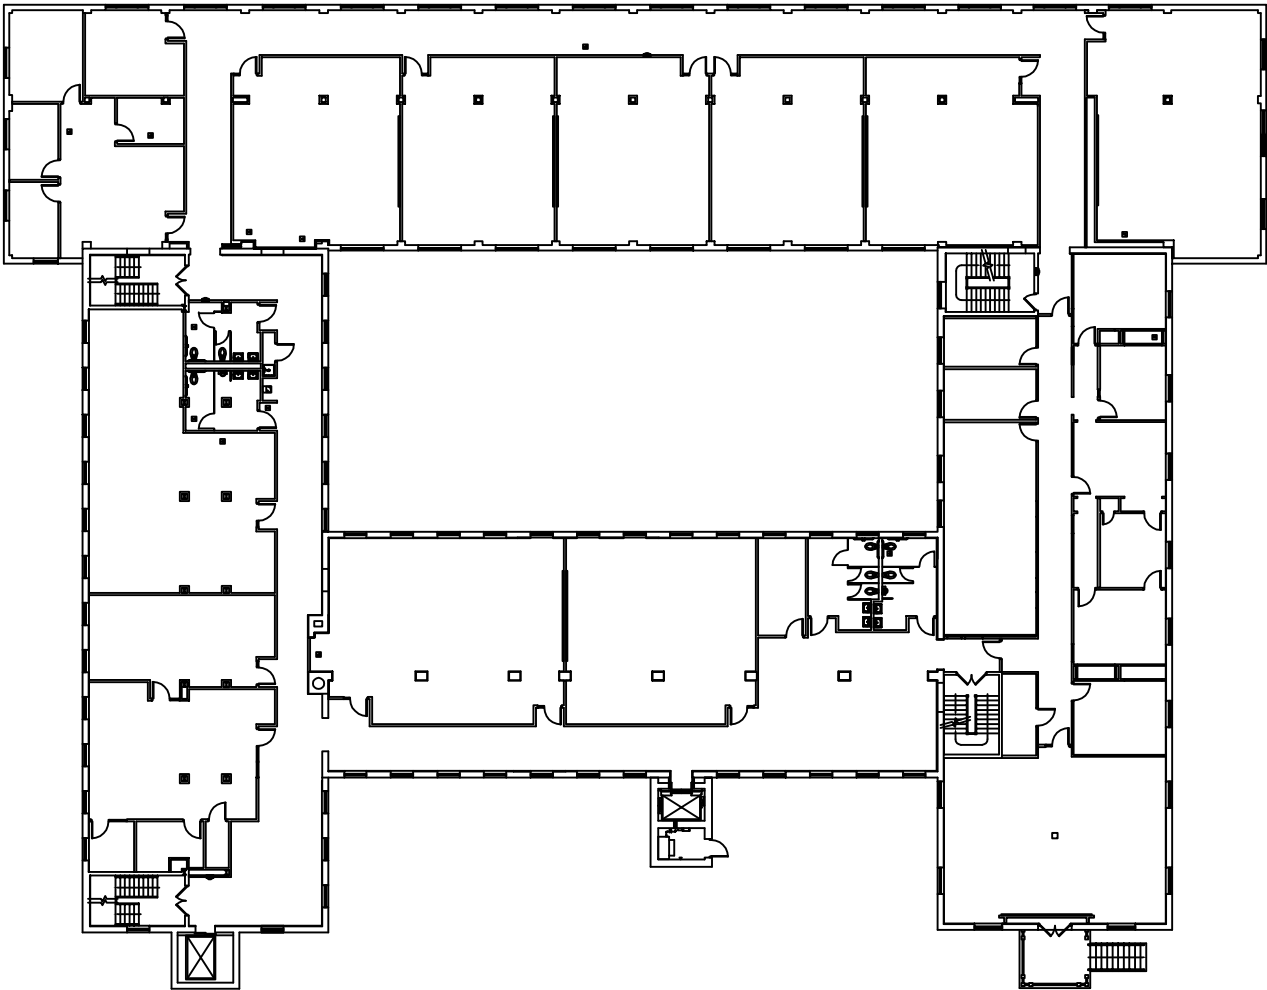

DRAWING TITLE
SECOND FLOOR PLAN

DATE: 4/20/2010


REVISION

DRAWN BY: SMS
PROJECT NUMBER: 08-006
DRAWING NUMBER

A-2.0

THREE PENN CENTER
for
PENN CENTER, HARRISBURG LP.
WORKING AS-BUILT PLANS
349 Wiconisco Street Harrisburg PA 17601

Darrell F. Sunday Associates, Inc.
Architecture, Planning & Design
ONE PENN CENTER
2601 North 3rd Street Suite 501 Harrisburg, PA 17110
tel.: 717-232-2270 fax: 717-232-2747

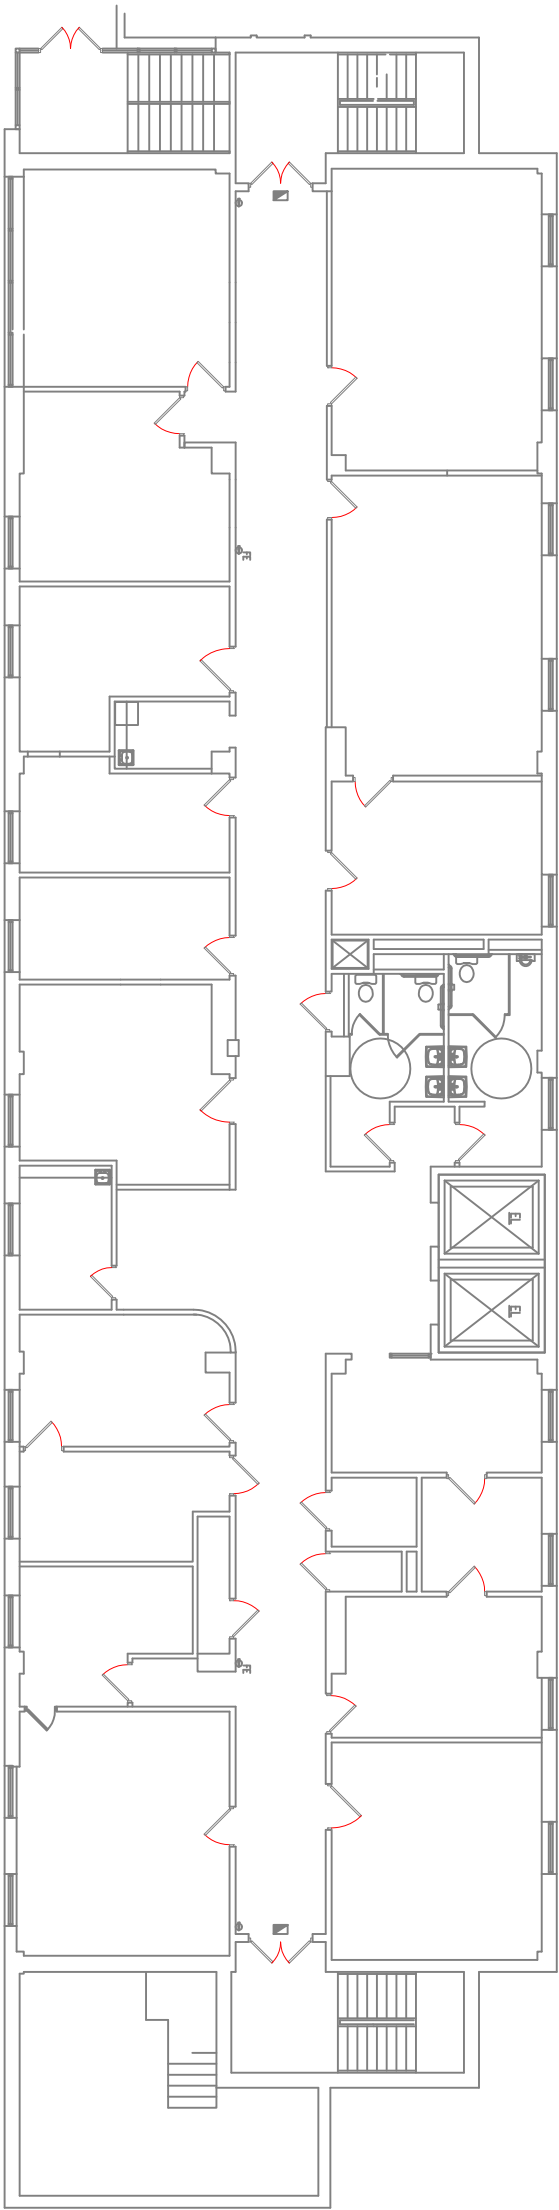

SECOND FLOOR PLAN

SCALE: 1/16" = 1'-0"

Darrell F. Sunday Associates, Inc.
Architecture, Planning & Design

ONE PENN CENTER

2601 North 3rd Street Suite 501 Harrisburg, PA 17110
tel.: 717-232-2270 fax: 717-232-2747

PENN CENTER HARRISBURG
TWO PENN CENTER
2643 NORTH THIRD STREET
HARRISBURG PENNSYLVANIA 17110

SECOND FLOOR PLAN

DATE: 05/11/02

DESIGNER:


DRAWN BY: SLS

PROJECT NUMBER:

Drawing Number:

A2

THIRD FLOOR
SCALE: 1/8" = 1'-0"

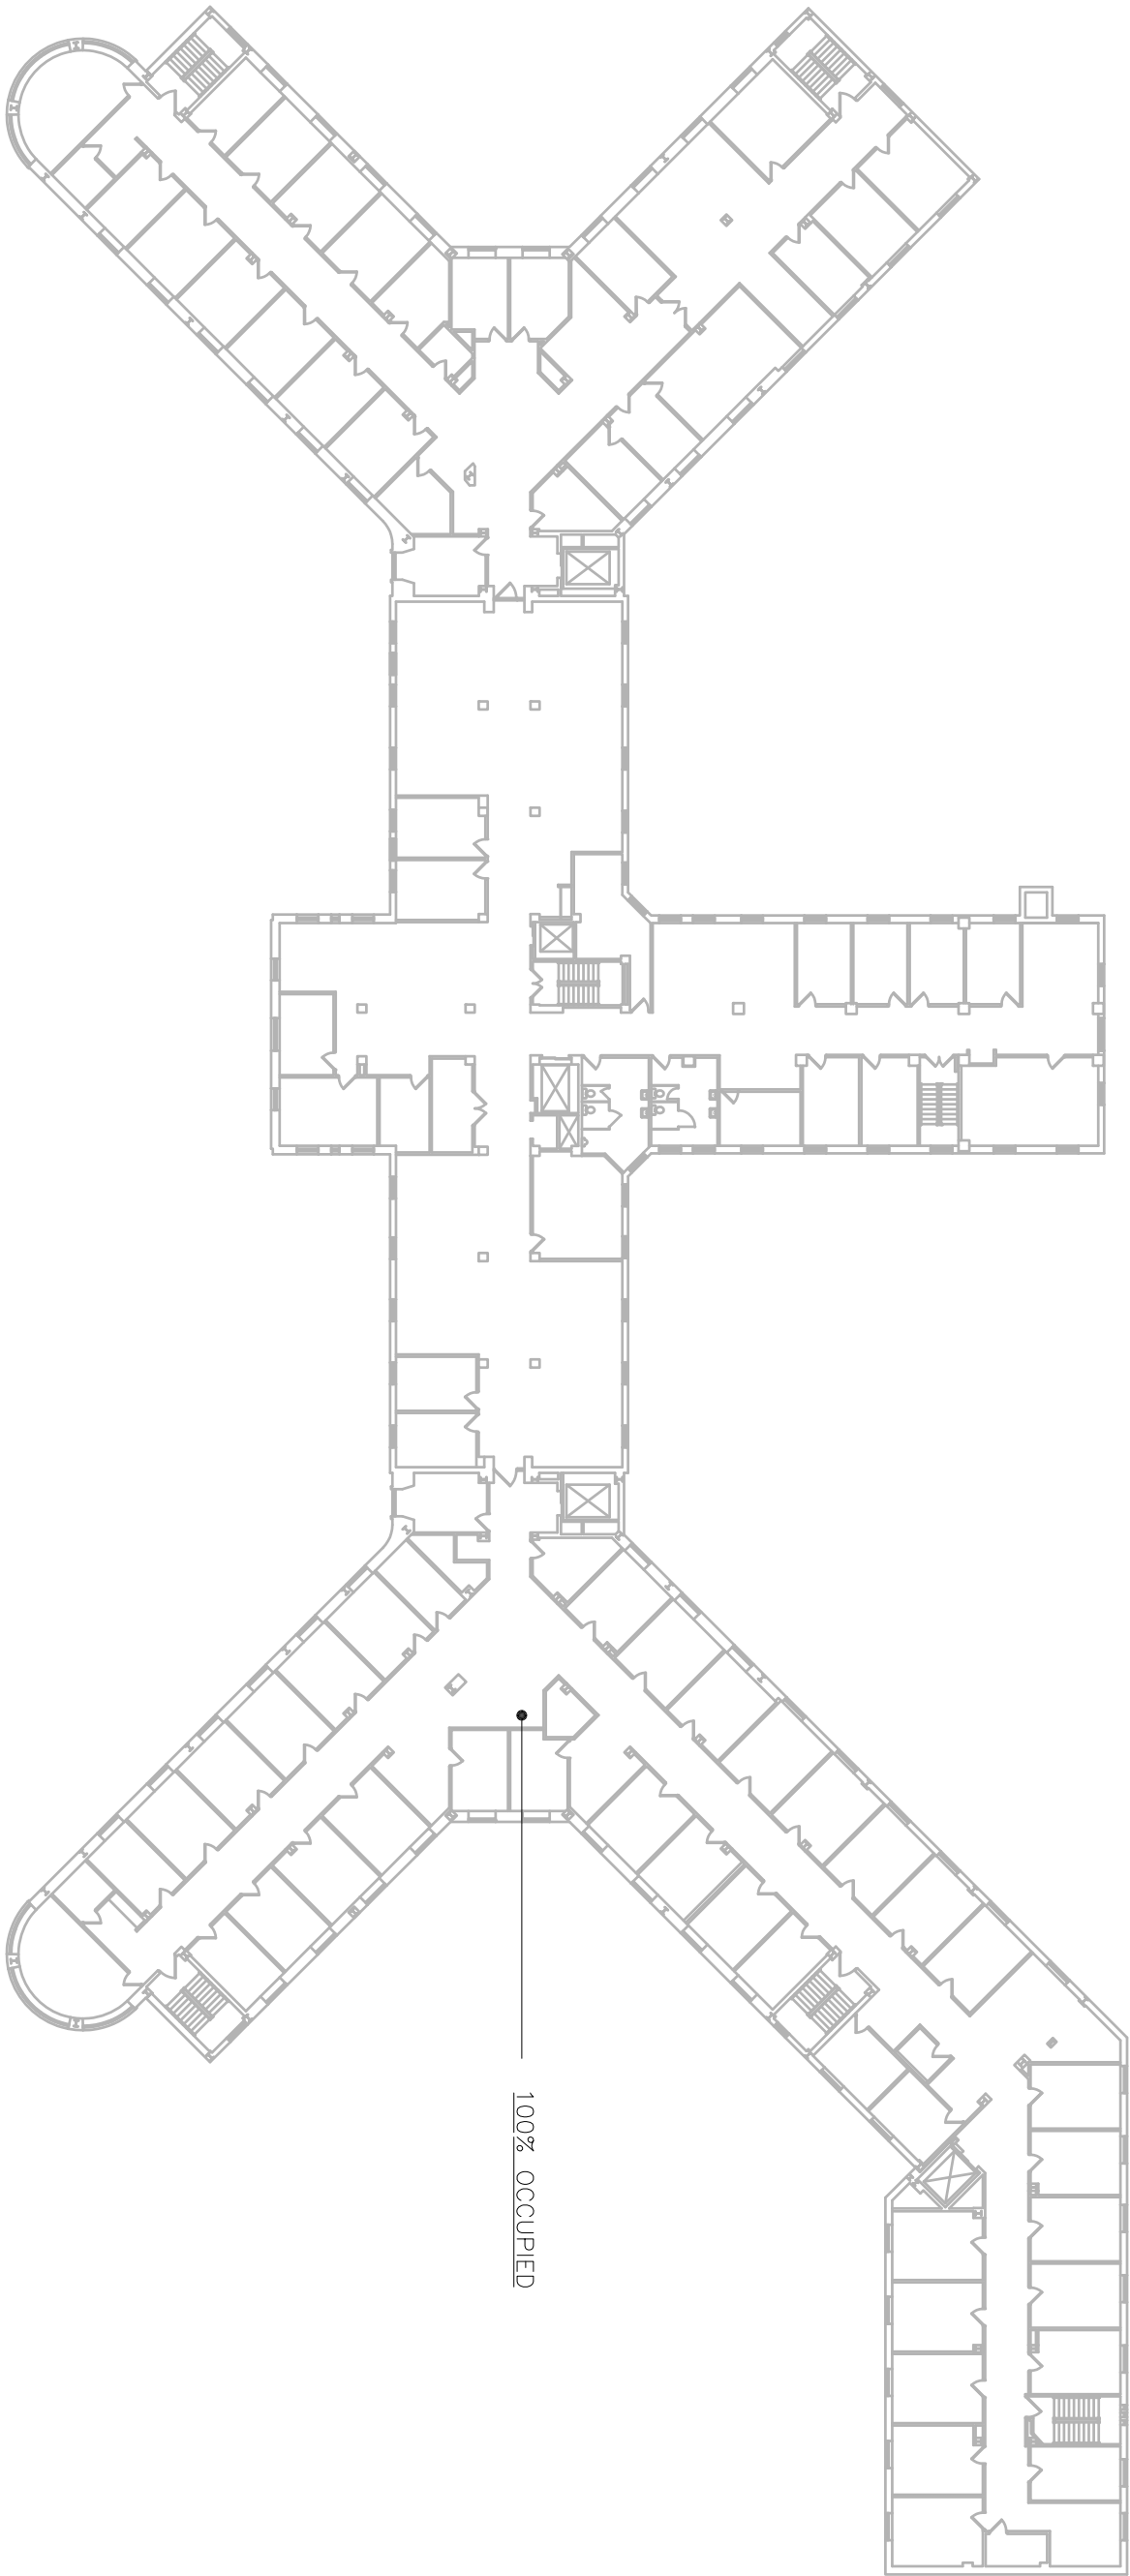

DRAWING TITLE

ONE PENN CENTER
for
PENN CENTER HARRISBURG, LP.
WORKING AS-BUILT PLANS

2601 North Third Street Harrisburg PA 17110

Darrell F. Sunday Associates, Inc.
Architecture, Planning & Design

ONE PENN CENTER
2601 North 3rd Street Suite 501 Harrisburg, PA 17110
tel.: 717-232-2270 fax: 717-232-2747

DATE: 08-28-10


DESIGNER

DRAWN BY: SJS

PROJECT NUMBER: 08-006

DRAWING NUMBER

A-3.0

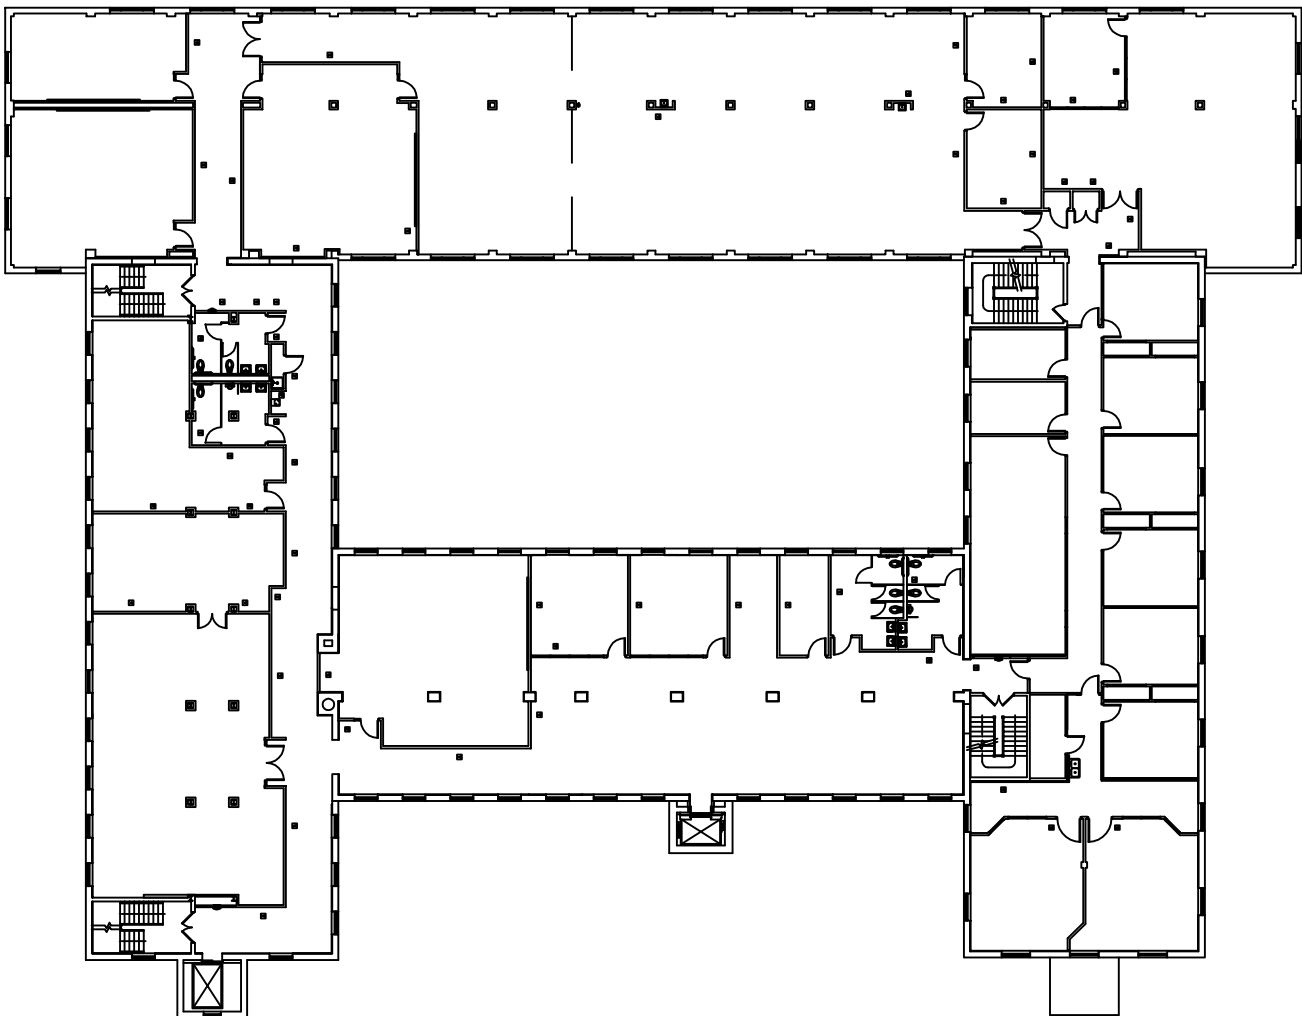

THIRD FLOOR PLAN
SCALE: 1/8" = 1'-0"

DRAWING TITLE
THIRD FLOOR PLAN

DATE 4/20/2010

REVISION

DRAWN BY: SMS

PROJECT NUMBER: 08-006

DRAWING NUMBER

THREE PENN CENTER
for
PENN CENTER, HARRISBURG LP.
WORKING AS-BUILT PLANS


349 Wiconisco Street Harrisburg PA 17601

Darrell F. Sunday Associates, Inc.
Architecture, Planning & Design

ONE PENN CENTER

2601 North 3rd Street Suite 501 Harrisburg, PA 17110
tel.: 717-232-2270 fax: 717-232-2747

A-3.0

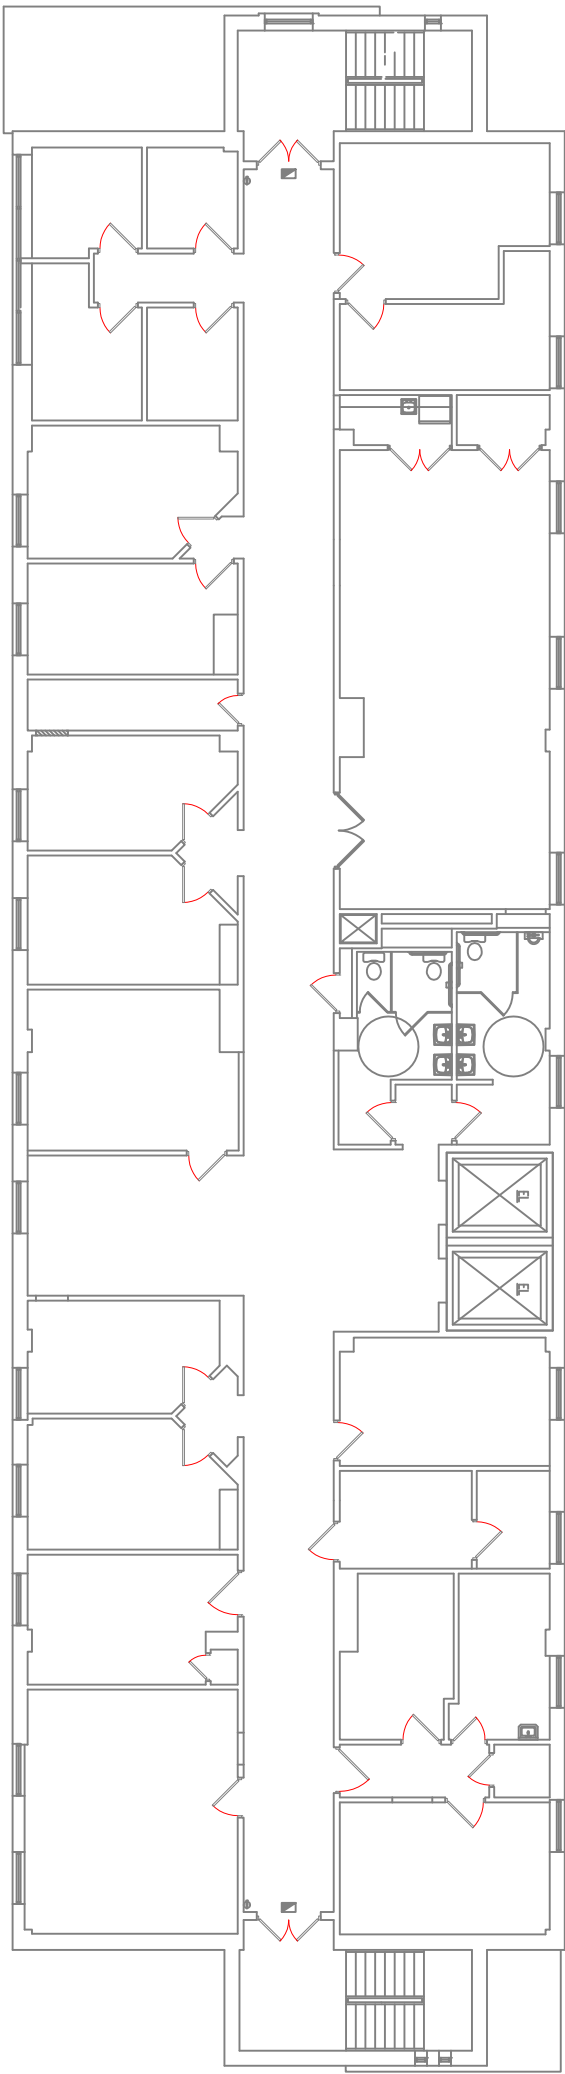


THIRD FLOOR PLAN
SCALE: 1/16" = 1'-0"

DATE: 05/11/03
THIRD FLOOR PLAN

PENN CENTER HARRISBURG
TWO PENN CENTER
2643 NORTH THIRD STREET
HARRISBURG PENNSYLVANIA 17110

Darrell F. Sunday Associates, Inc.
Architecture, Planning & Design
ONE PENN CENTER
2601 North 3rd Street Suite 501 Harrisburg, PA 17110
tel.: 717-232-2270 fax: 717-232-2747

FOURTH FLOOR
SCALE: 1/16" = 1'-0"

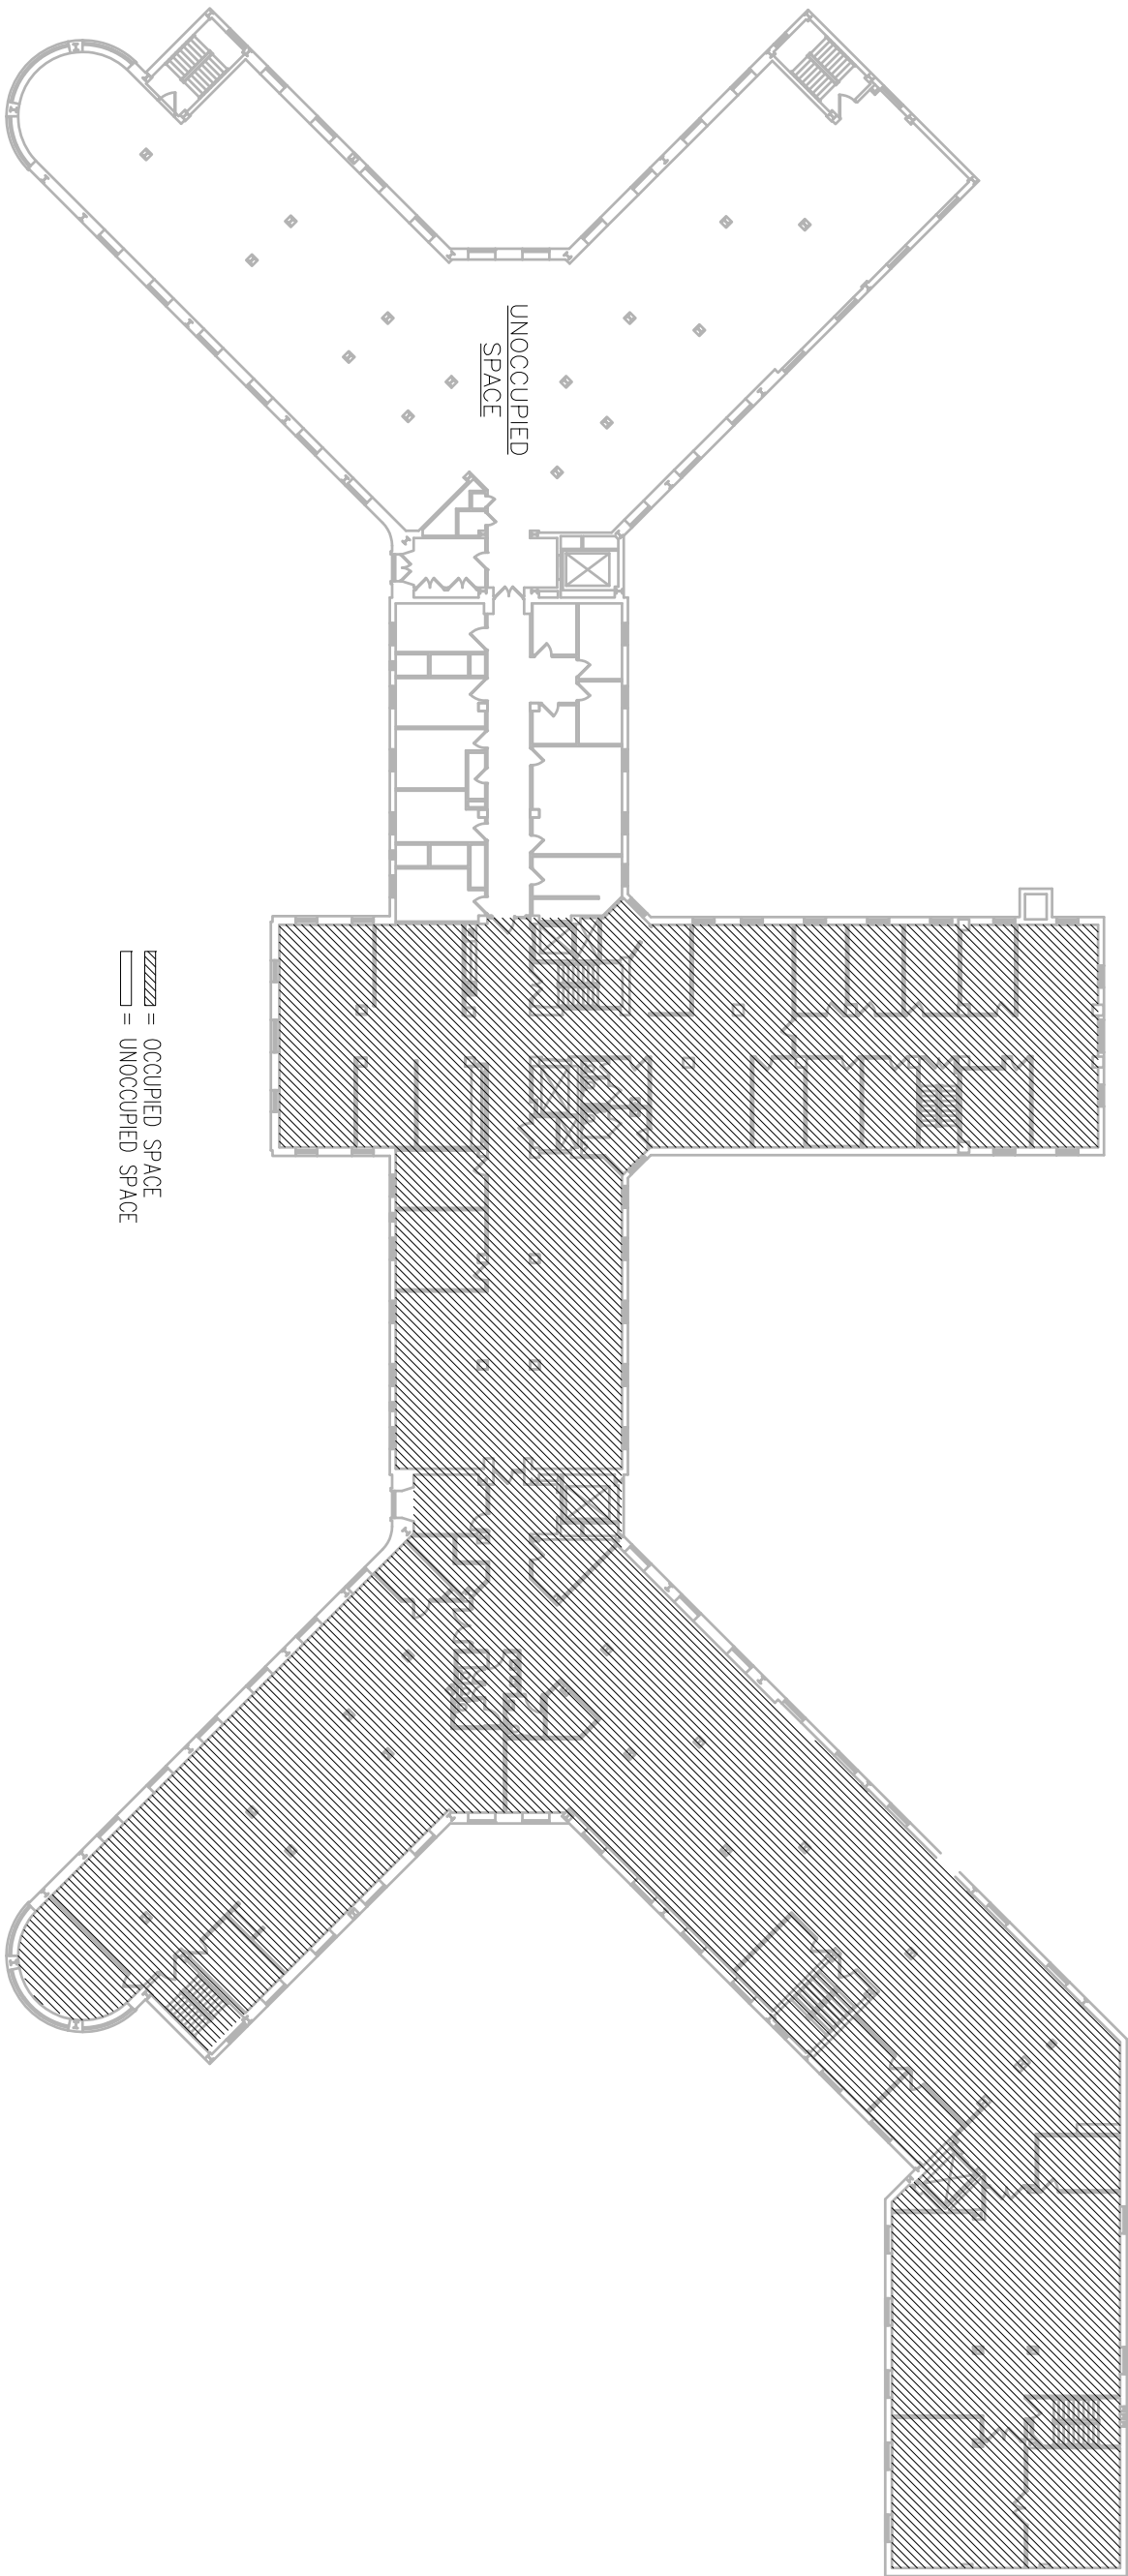

DRAWING TITLE

ONE PENN CENTER
for
PENN CENTER HARRISBURG, LP.
WORKING AS-BUILT PLANS

2601 North Third Street Harrisburg PA 17110

Darrell F. Sunday Associates, Inc.
Architecture, Planning & Design

ONE PENN CENTER
2601 North 3rd Street Suite 501 Harrisburg, PA 17110
tel.: 717-232-2270 fax: 717-232-2747

DATE: 08-28-10

DESIGNER


DRAWN BY: SJS

PROJECT NUMBER: 08-006

DRAWING NUMBER

08-006

A-4.0

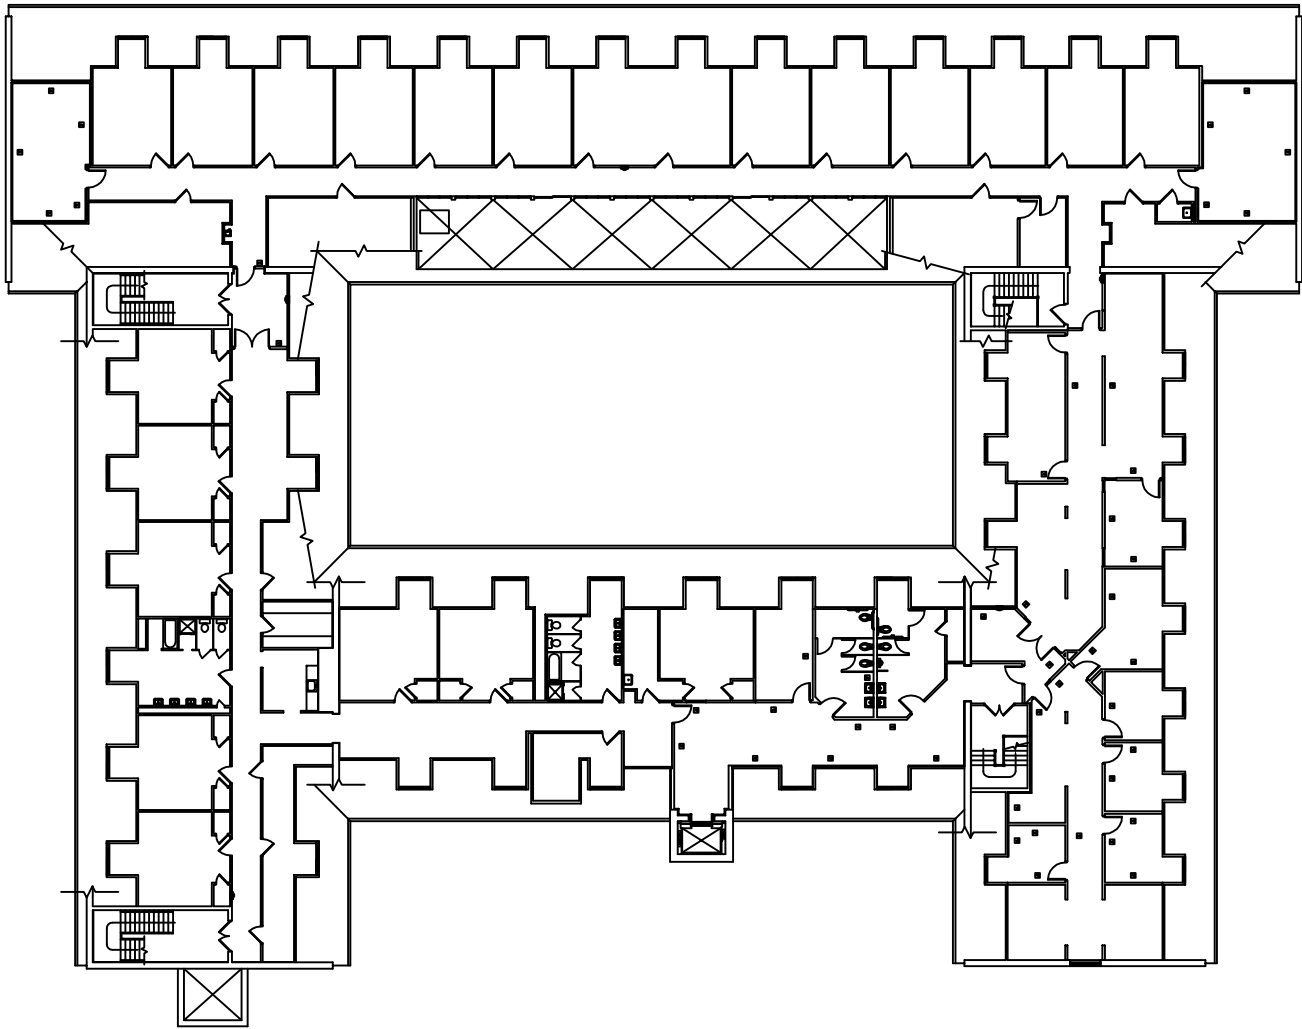

FOURTH FLOOR PLAN
SCALE: 1/8" = 1'-0"

DRAWING TITLE
FOURTH FLOOR PLAN

DATE 4/20/2010

REVISION

DRAWN BY: SMS
PROJECT NUMBER: 08-006
DRAWING NUMBER


THREE PENN CENTER
for
PENN CENTER, HARRISBURG LP.
WORKING AS-BUILT PLANS

349 Wiconisco Street Harrisburg PA 17601

Darrell F. Sunday Associates, Inc.
Architecture, Planning & Design

ONE PENN CENTER
2601 North 3rd Street Suite 501 Harrisburg, PA 17110
tel.: 717-232-2270 fax: 717-232-2747

A-4.0

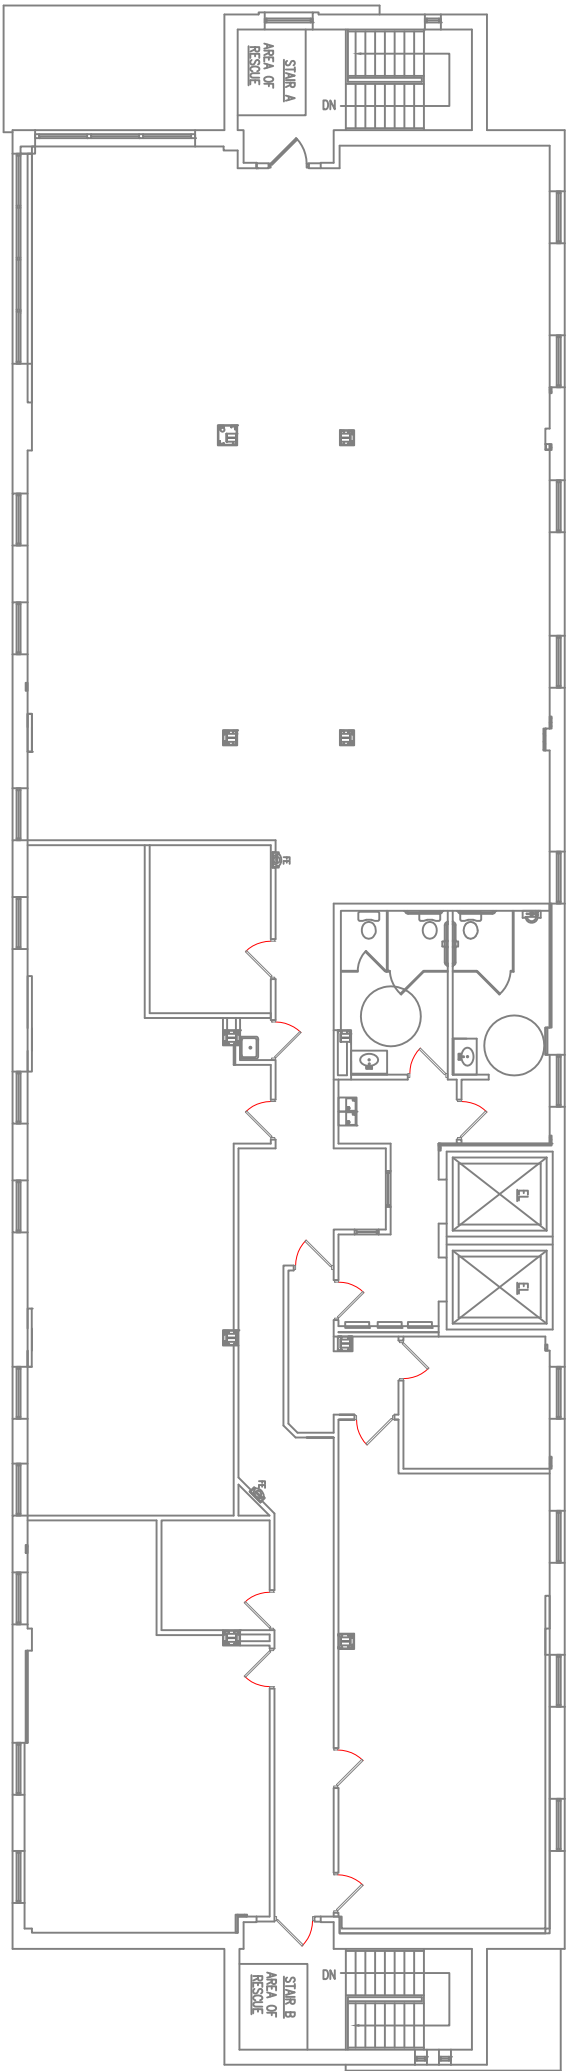

FOURTH FLOOR PLAN

SCALE: 1/16" = 1'-0"

DRAWING TITLE
FOURTH FLOOR PLAN


PENN CENTER HARRISBURG
TWO PENN CENTER
2643 NORTH THIRD STREET
HARRISBURG PENNSYLVANIA 17110

Darrell F. Sunday Associates, Inc.
Architecture, Planning & Design

ONE PENN CENTER
2601 North 3rd Street Suite 501 Harrisburg, PA 17110
tel.: 717-232-2270 fax: 717-232-2747

DATE: 02.11.20
DRAWN BY: SMD
PROJECT NUMBER:
DRAWING NUMBER:
A4

FIFTH FLOOR
SCALE: 1/8" = 1'-0"

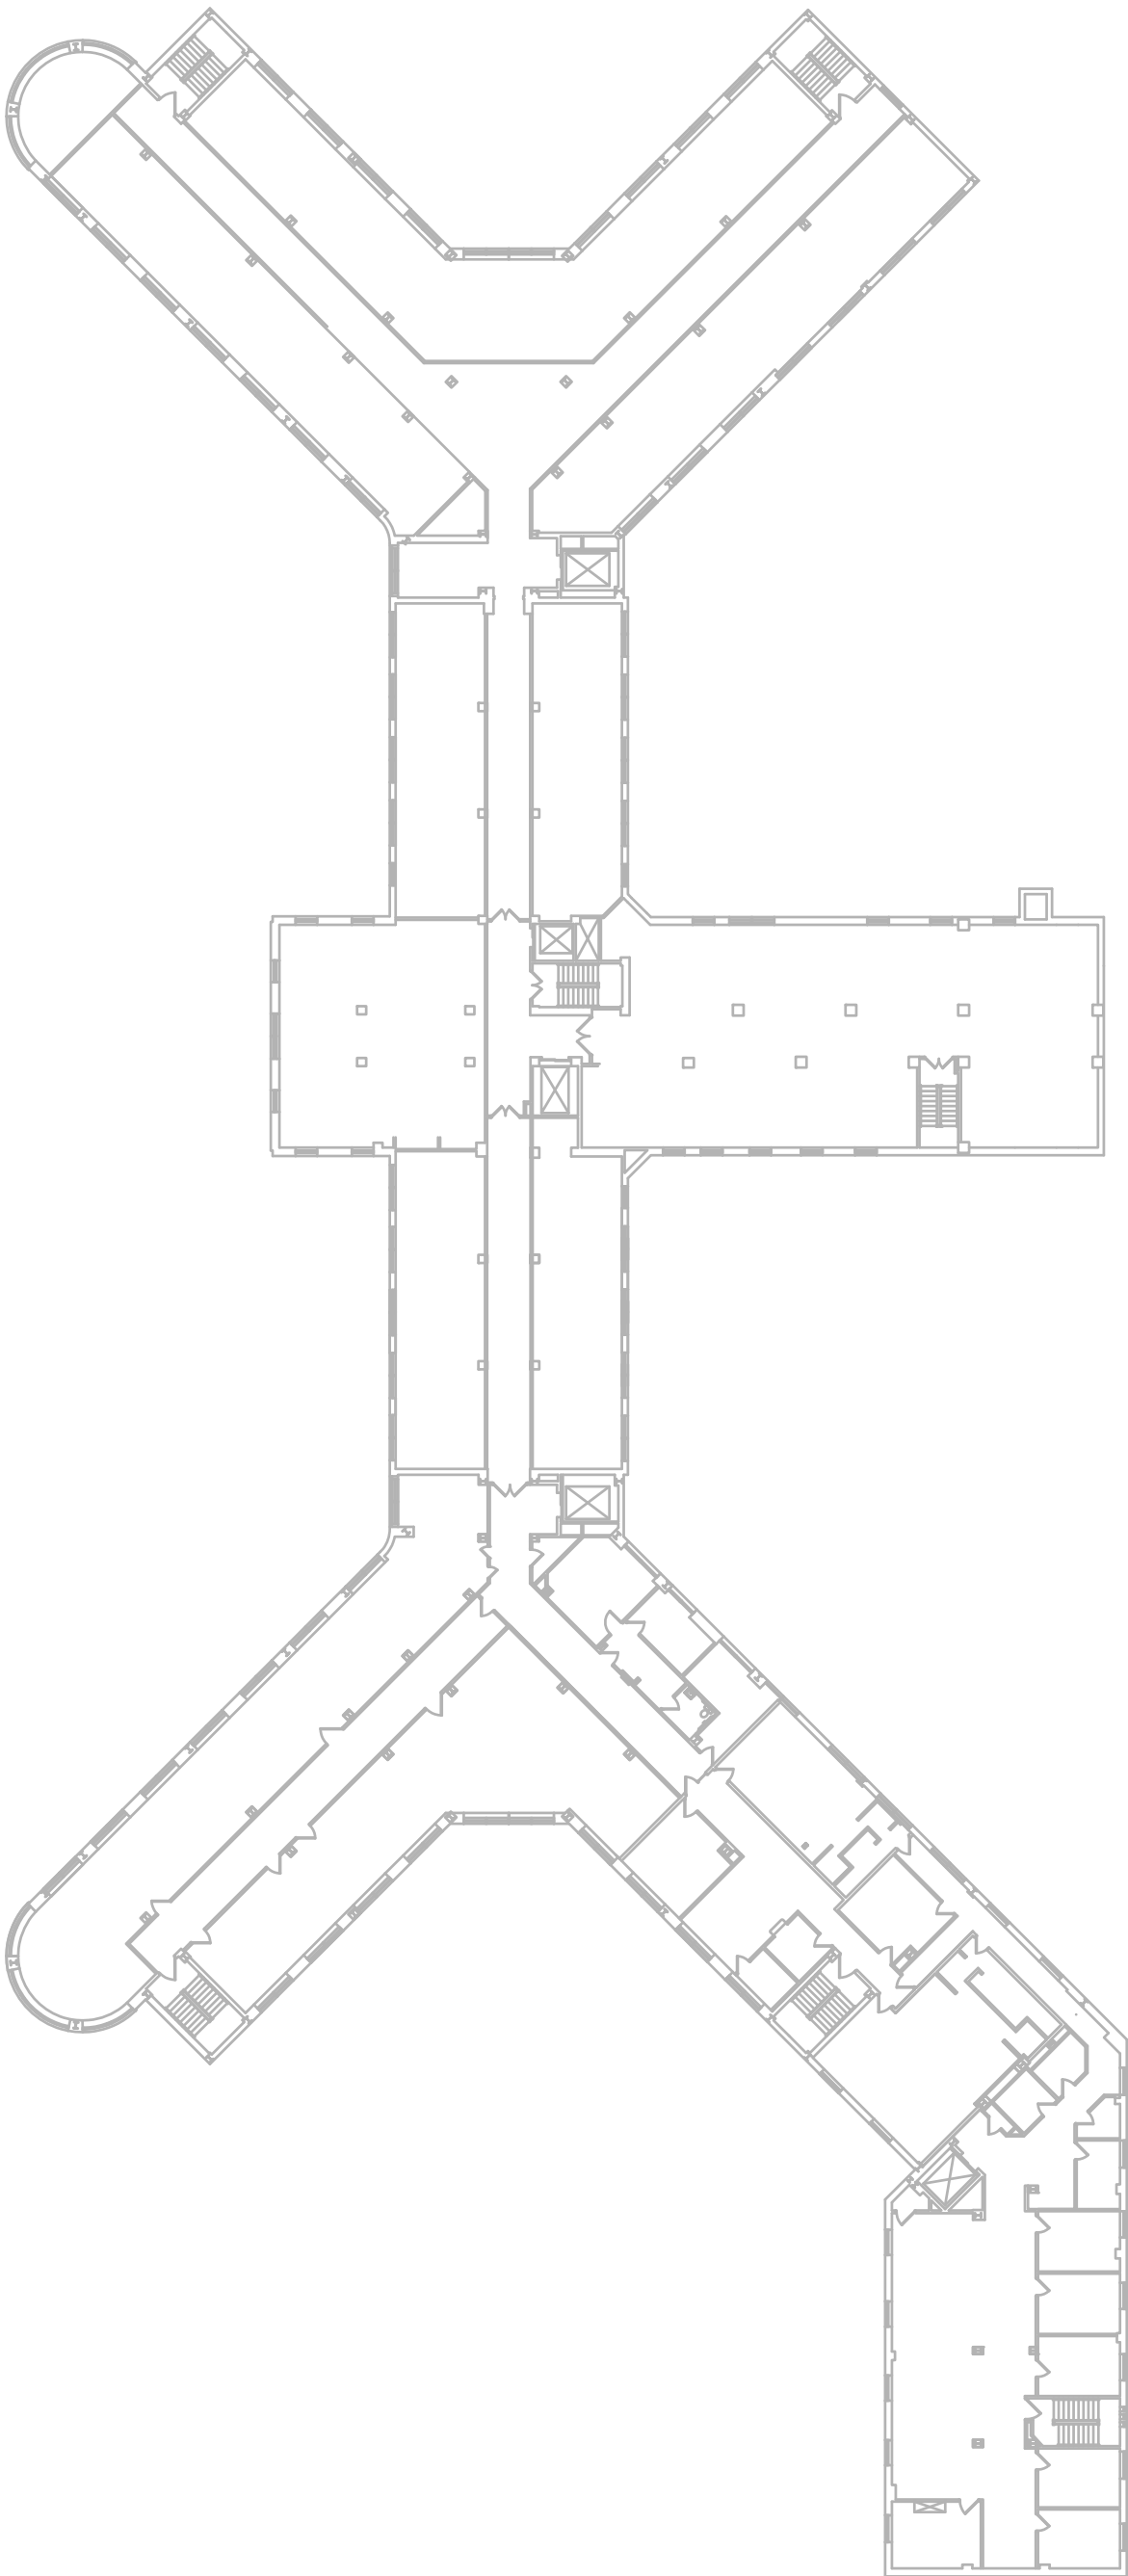

DRAWING TITLE

ONE PENN CENTER
for
PENN CENTER HARRISBURG, LP.
WORKING AS-BUILT PLANS

2601 North Third Street Harrisburg PA 17110

Darrell F. Sunday Associates, Inc.
Architecture, Planning & Design

ONE PENN CENTER
2601 North 3rd Street Suite 501 Harrisburg, PA 17110
tel.: 717-232-2270 fax: 717-232-2747

DATE: 08-28-10

DESIGNER

DRAWN BY: SJS

PROJECT NUMBER: 08-006

DRAWING NUMBER

A-5.0