



For Lease



Matterport View

Flex/R&D Availability • Property Highlights

4370 Varsity Drive | Ann Arbor, Michigan

- 24,553 SF Available for Lease
- Highly Desirable Combination of Office, Lab/R&D, and Storage Space
- Biosafety Level 2 lab in the Building
- Multiple Grade Level Doors and Dock Doors
- High Finished Office Ceilings
- Above Standard Electric
- 100% AC Throughout
- Generous Parking
- Available First Quarter 2024




John Fricke
Direct | 248 872 7820
john.fricke@colliers.com




Jonathan Loos
Direct | 248 787 8672
jonathan.loos@colliers.com

Aerial

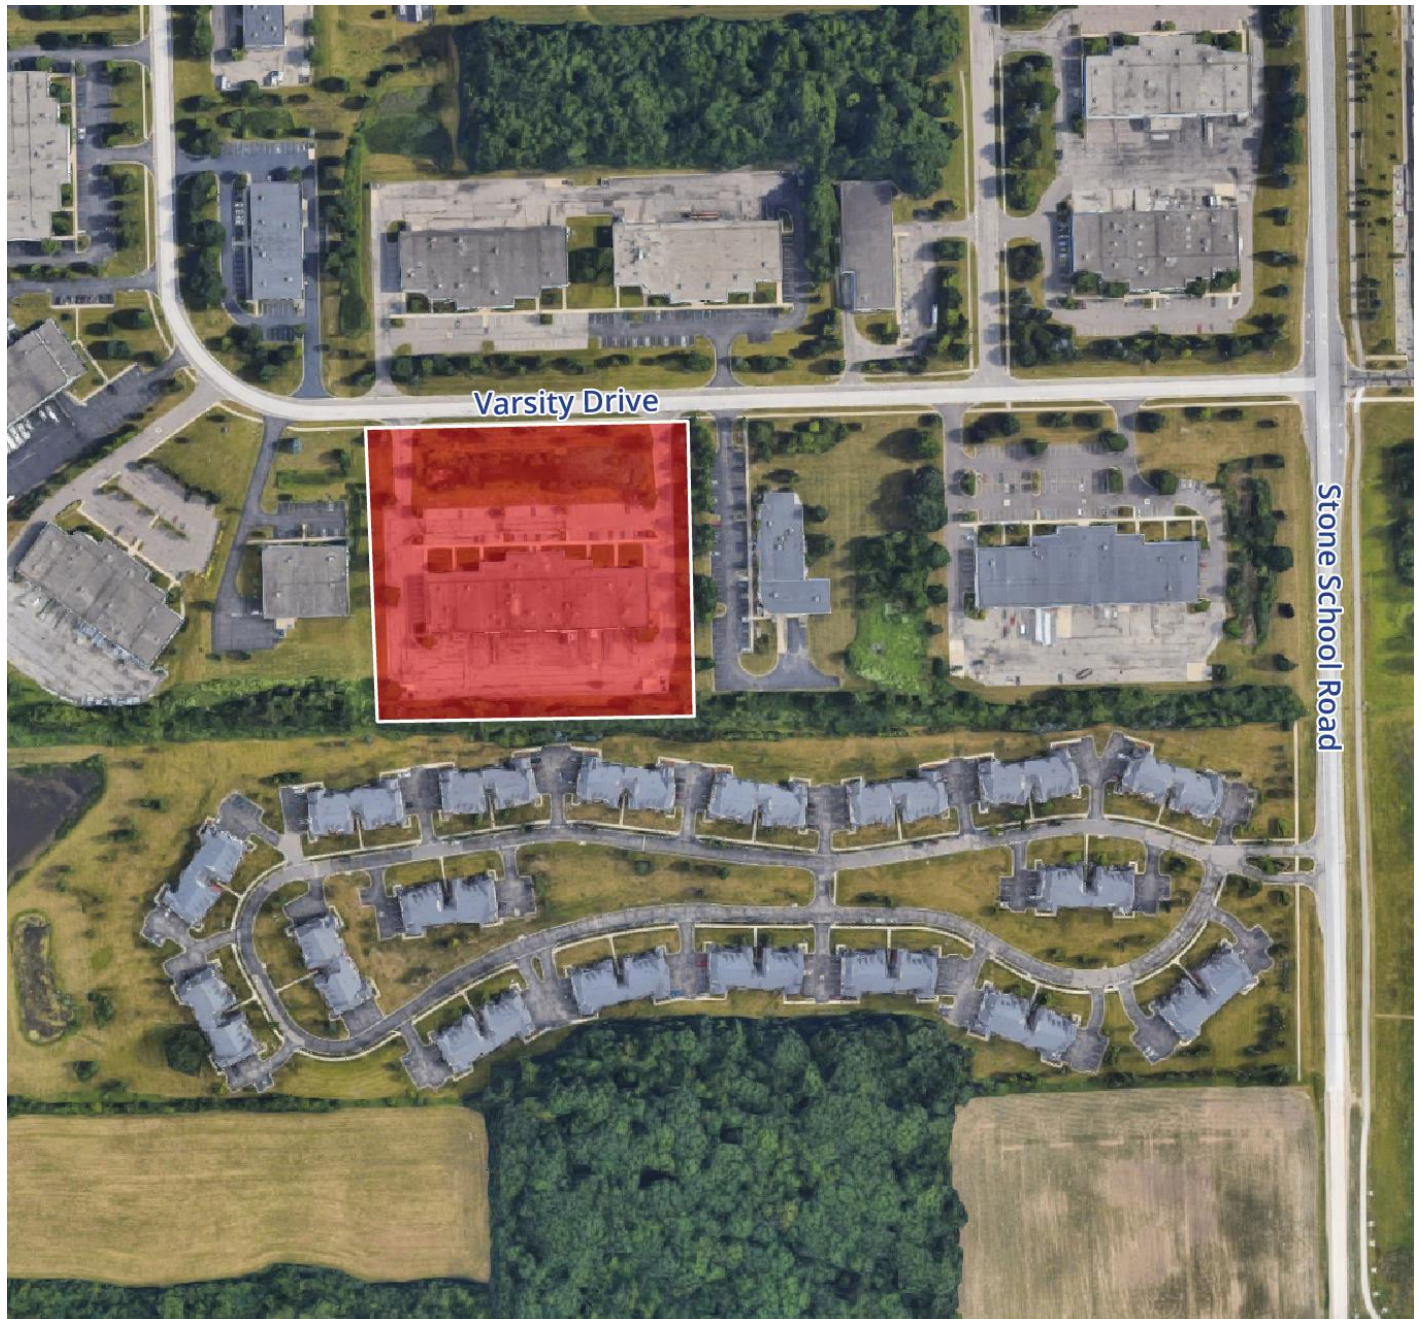


Floor Plan – 24,553 SF

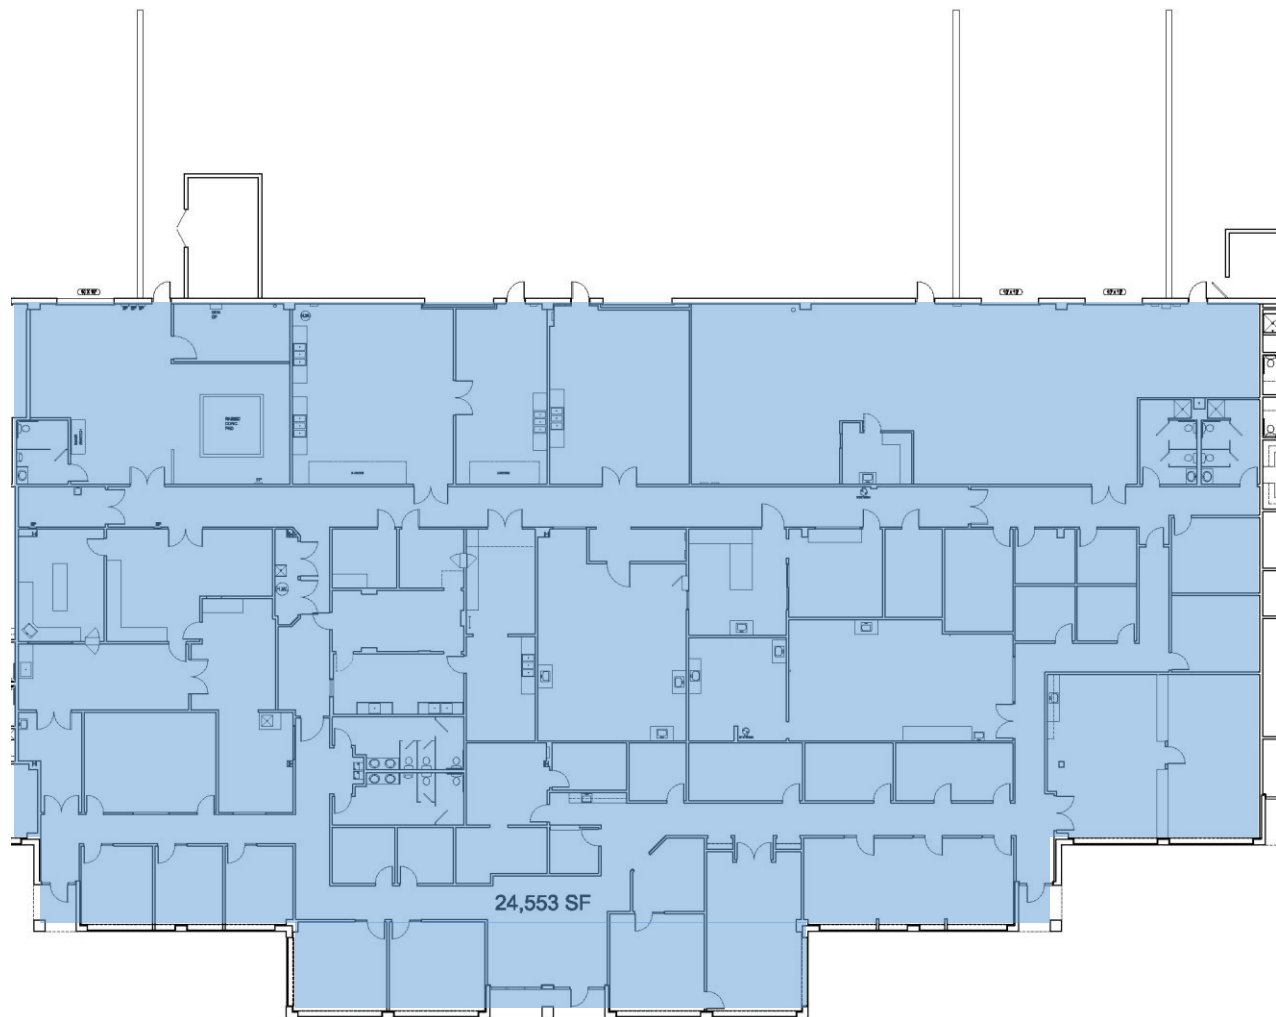

AS-BUILT FLOOR PLAN
4370 VARSITY DRIVE, ANN ARBOR, MI 48108
Scale: NTS

Location Map

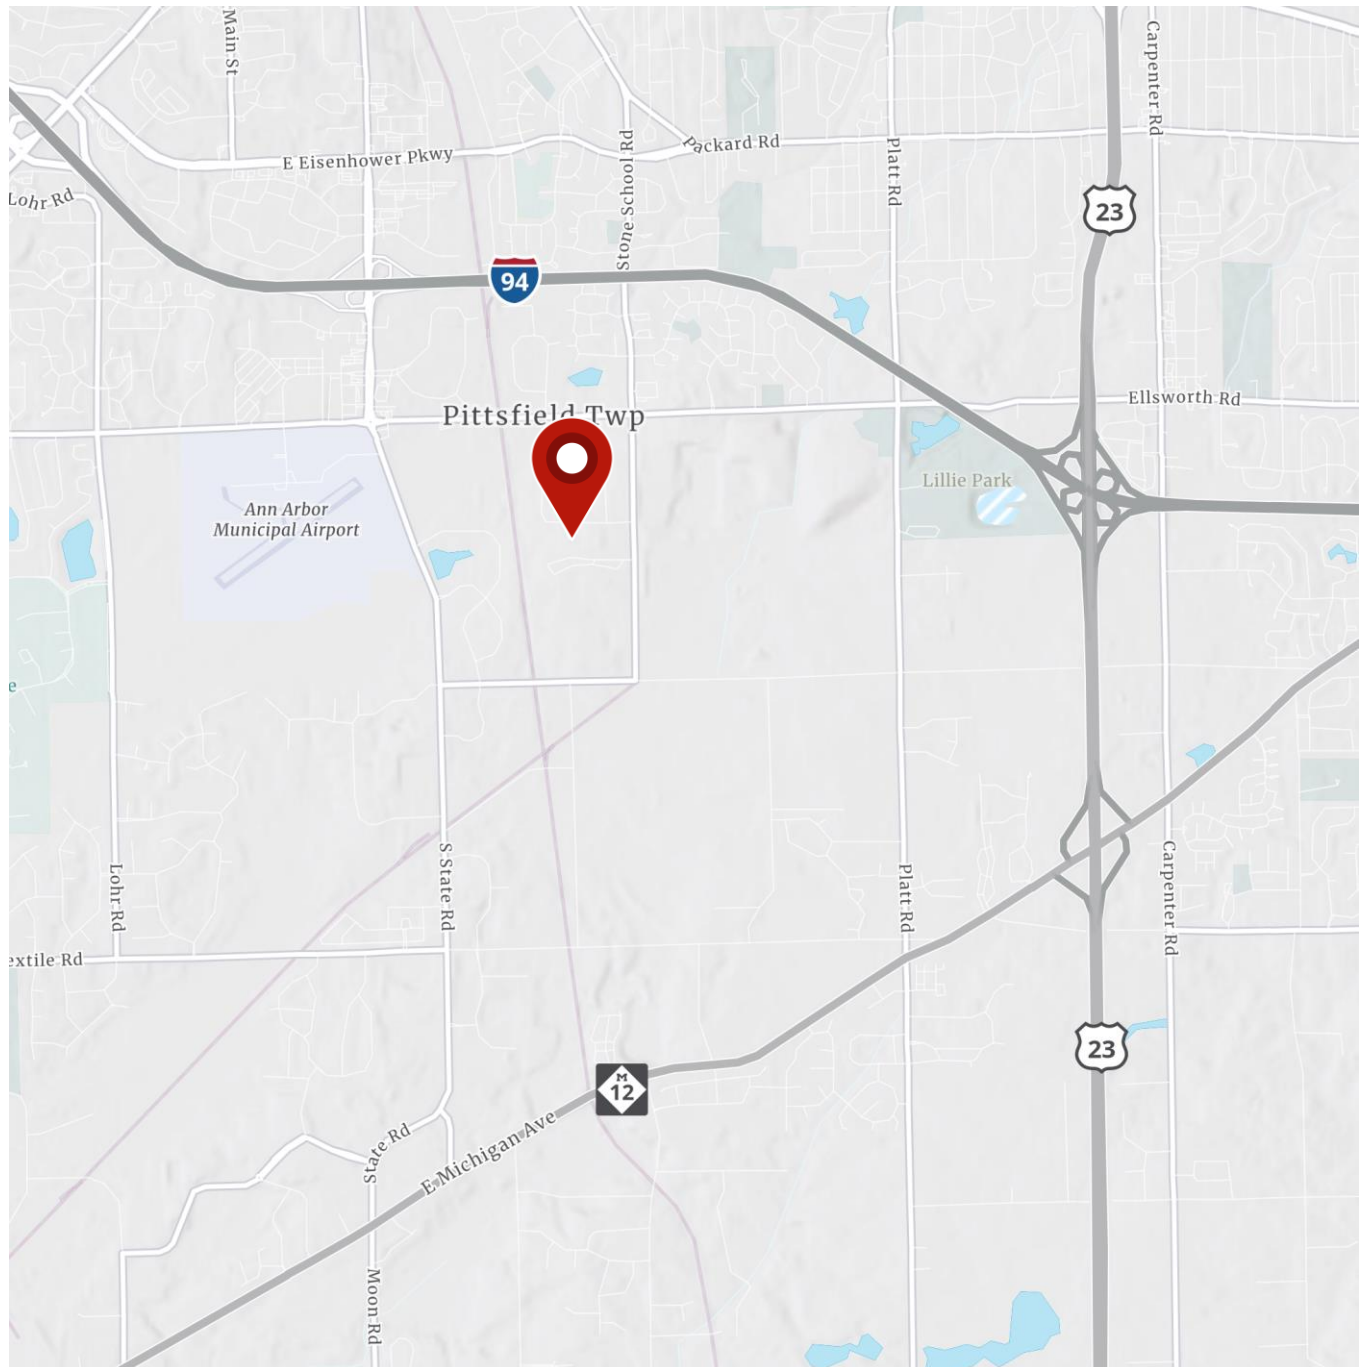

John Fricke
Direct | 248 872 7820
john.fricke@colliers.com



Jonathan Loos
Direct | 248 787 8672
jonathan.loos@colliers.com