


1550 Tower | Suite 425

Suite As-Built Plan
4,254 RSF

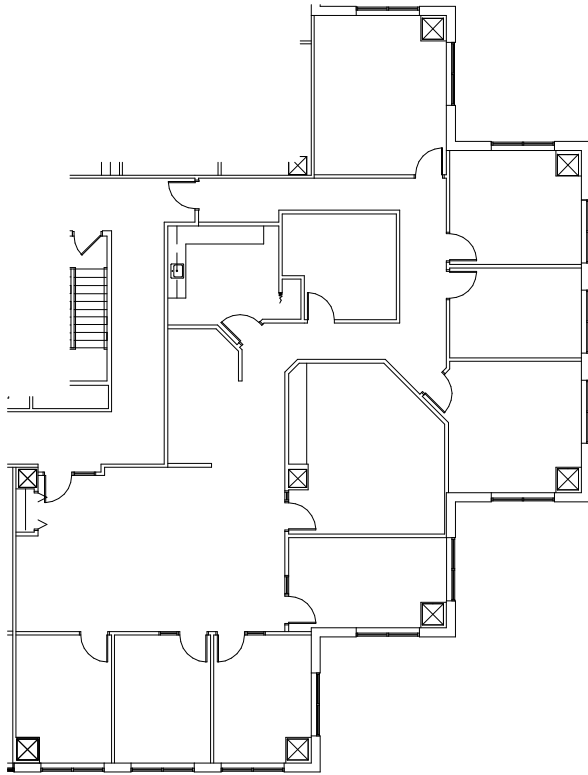

Leased by:

