


PRESTONWOOD TOWER



5151 BELT LINE | DALLAS, TX 75254

SUITE 347 | 1,374 RSF

SPEC DESIGN

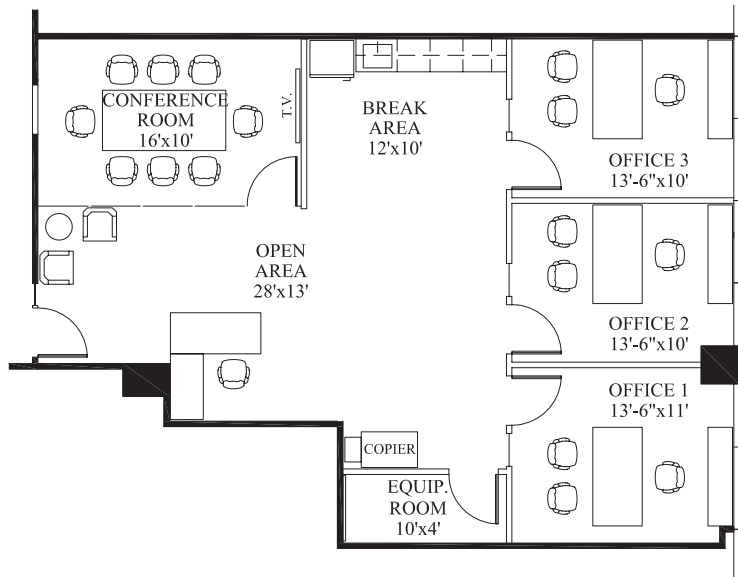

AS-BUILT

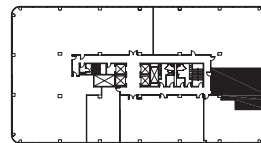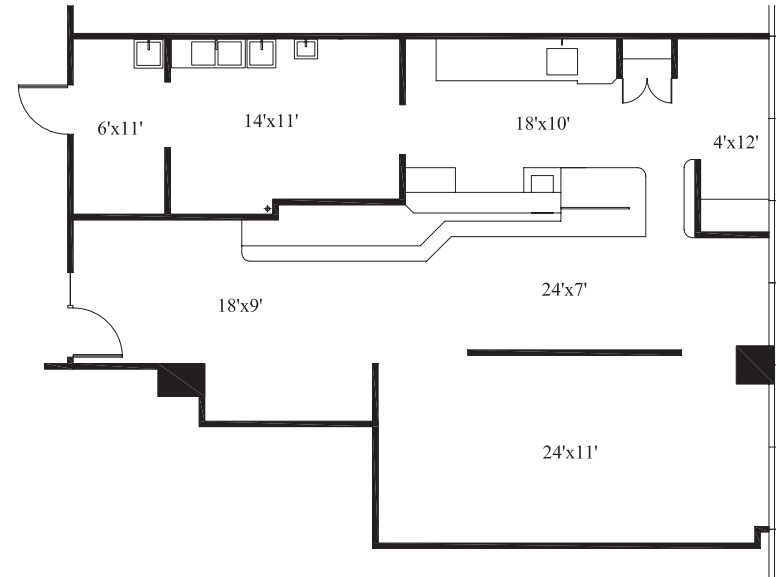

3RD FLOOR