[illegible]

1704-1710 Western Ave.
Las Vegas, NV 89102

SITE PLAN


DATE: 01/19/2026

DRAWN BY:



SCALE: AS NOTED

SHEET


A0.10

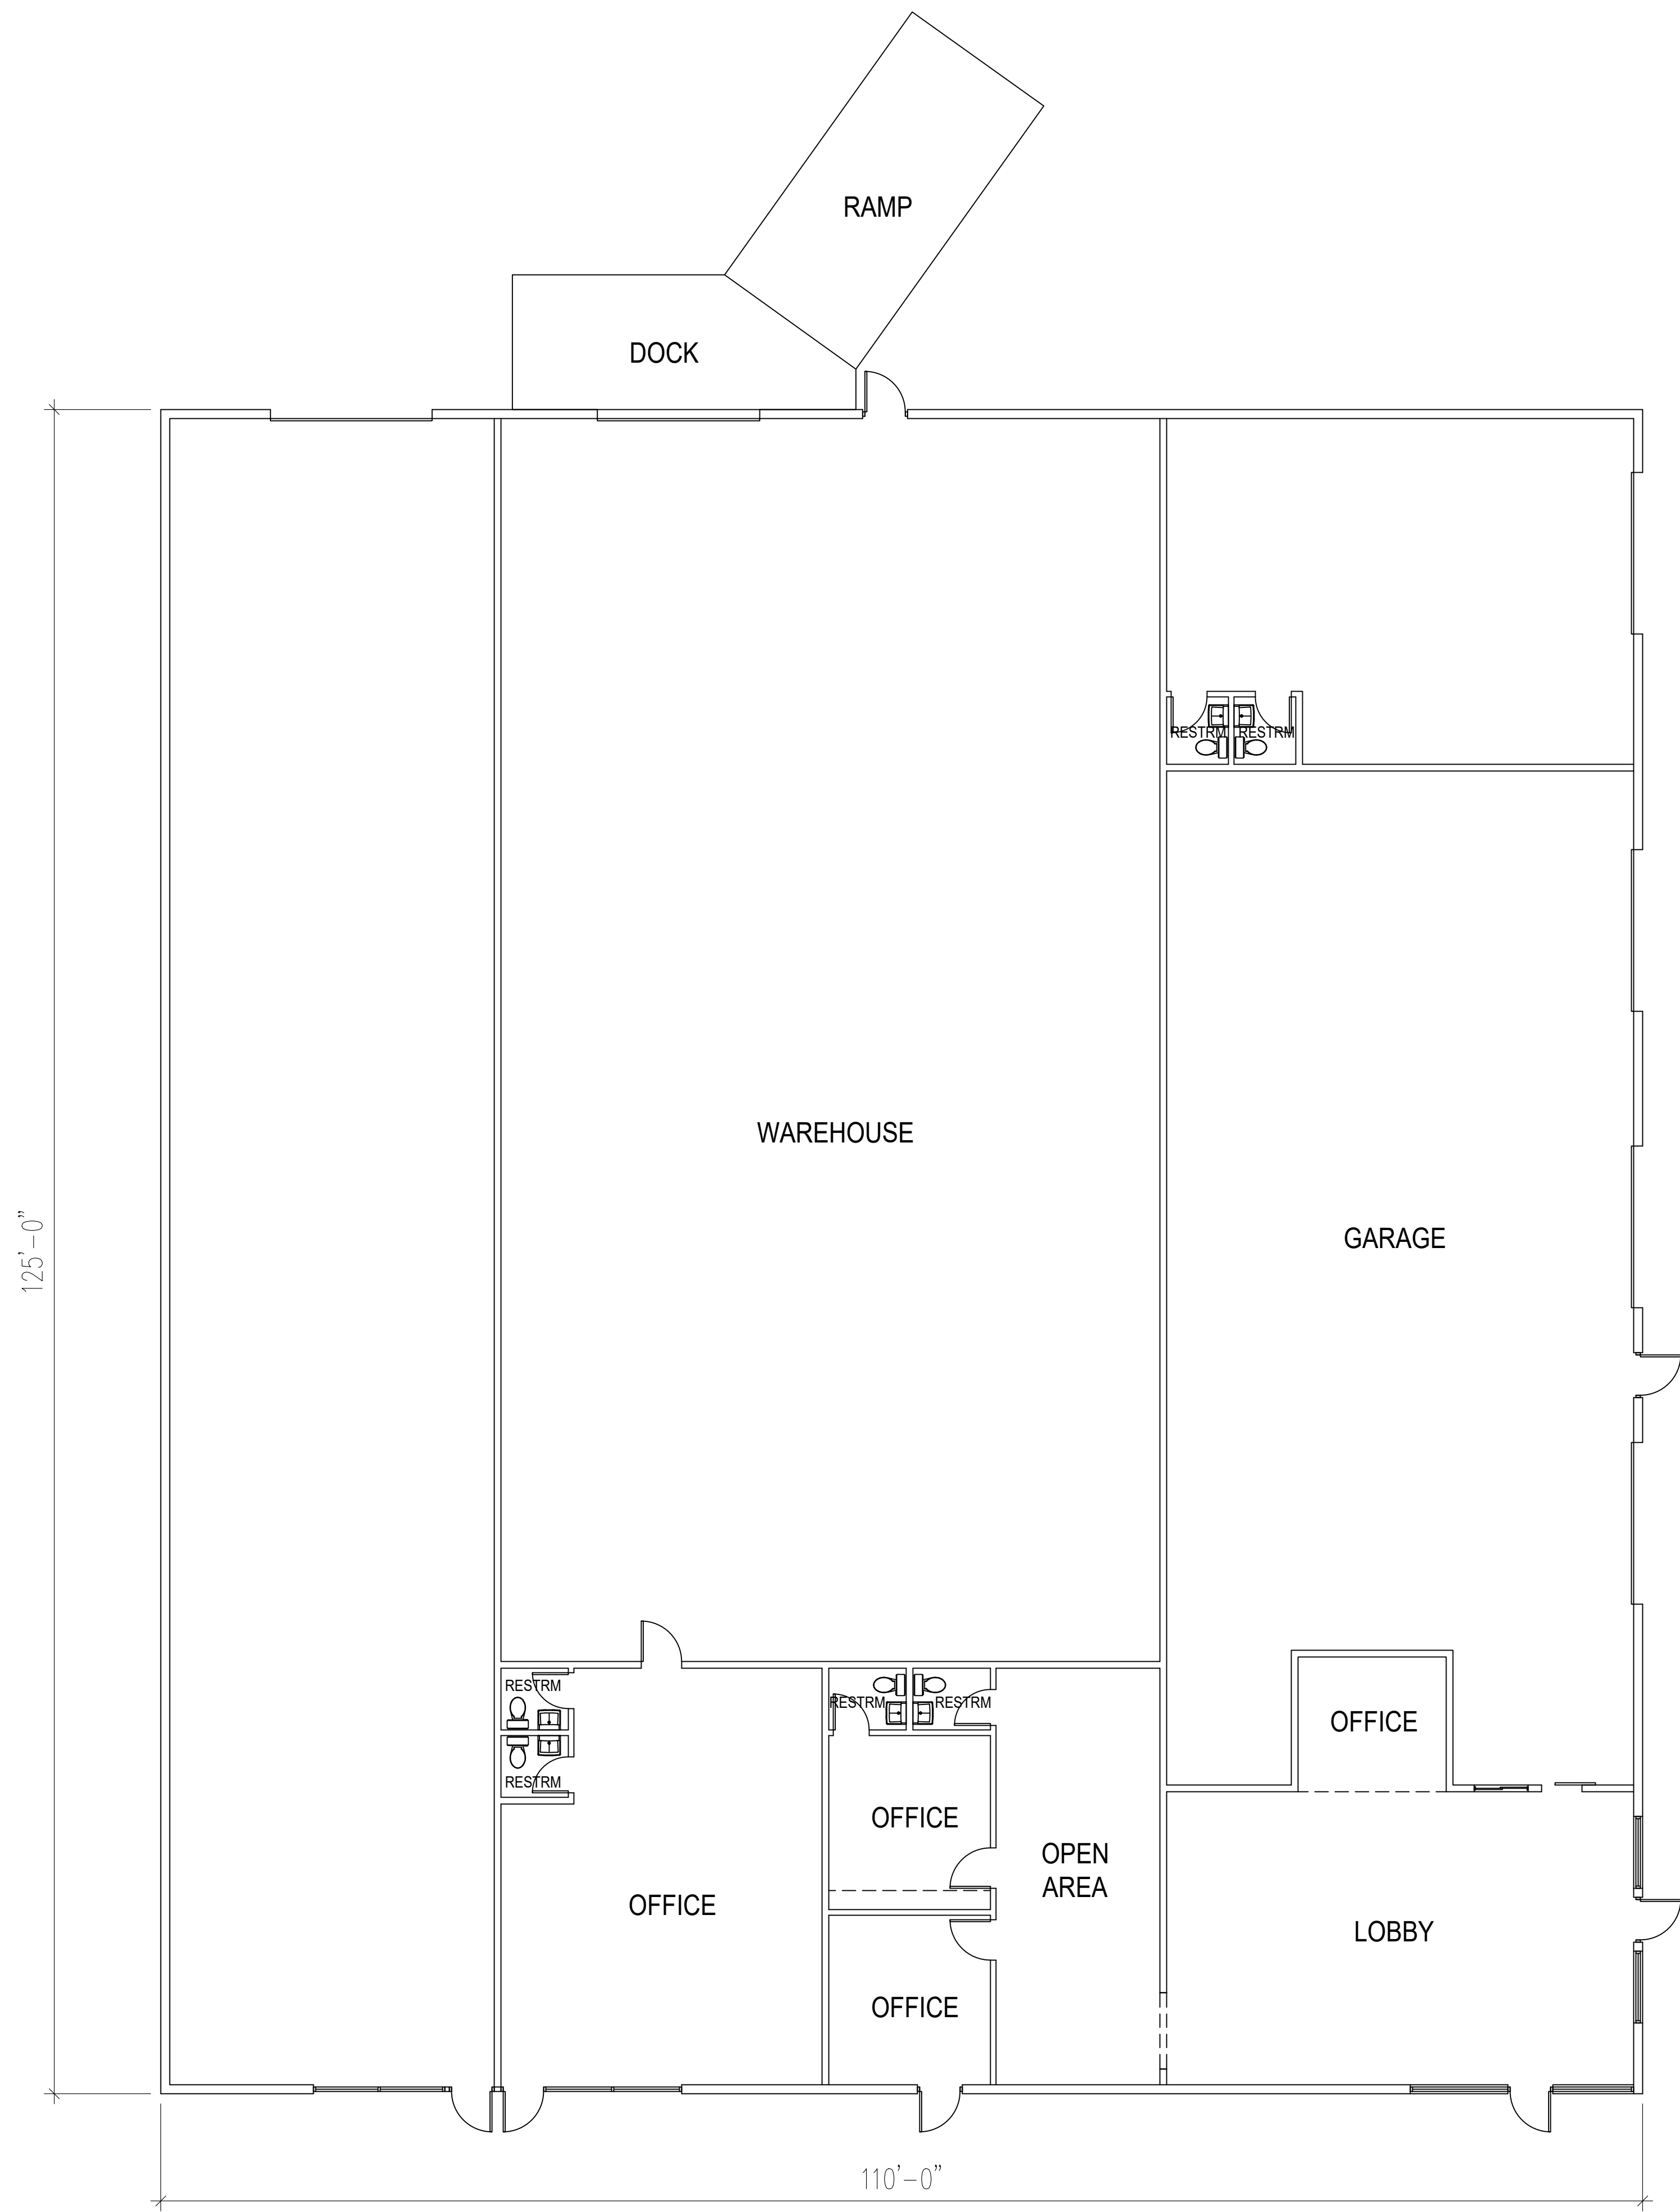

1 Main Structure As-Built Floor Plan
A1.00 SCALE: 1/8" = 1'-0"

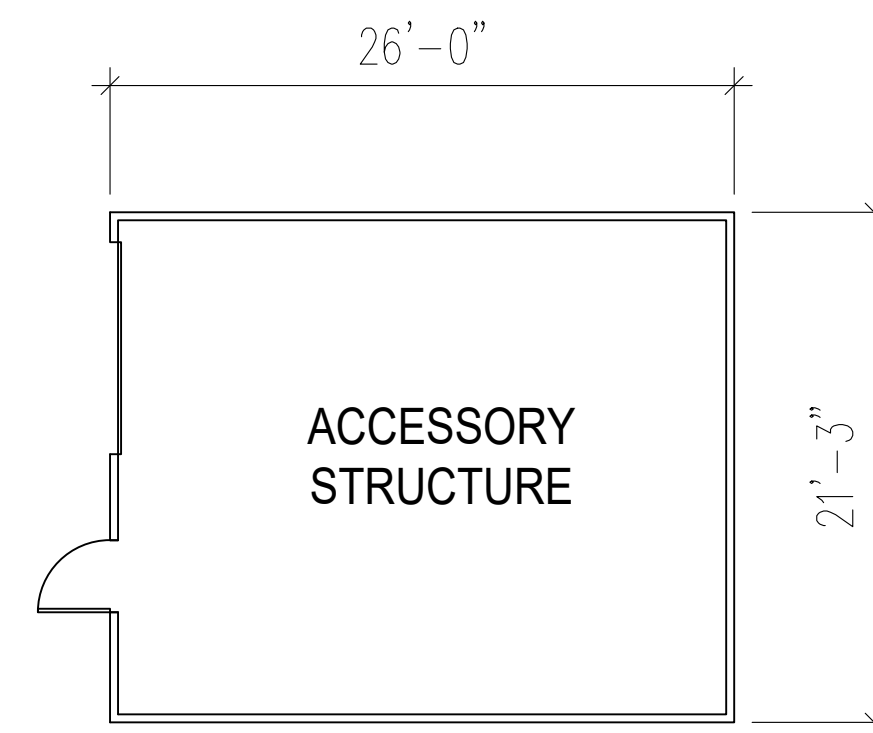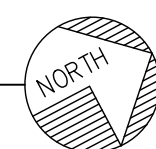

2 Accessory Structure As-Built Floor Plan
A1.00 SCALE: 1/8" = 1'-0"

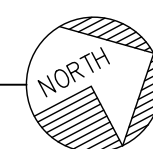

#	REVISION	BY
△		
△		

--

--



1704-1710 Western Ave. Las Vegas, NV 89102	AS-BUILT FLOOR PLAN
---	---------------------

DATE: 01/19/2026	
DRAWN BY:	
SCALE: AS NOTED	


SHEET A1.00

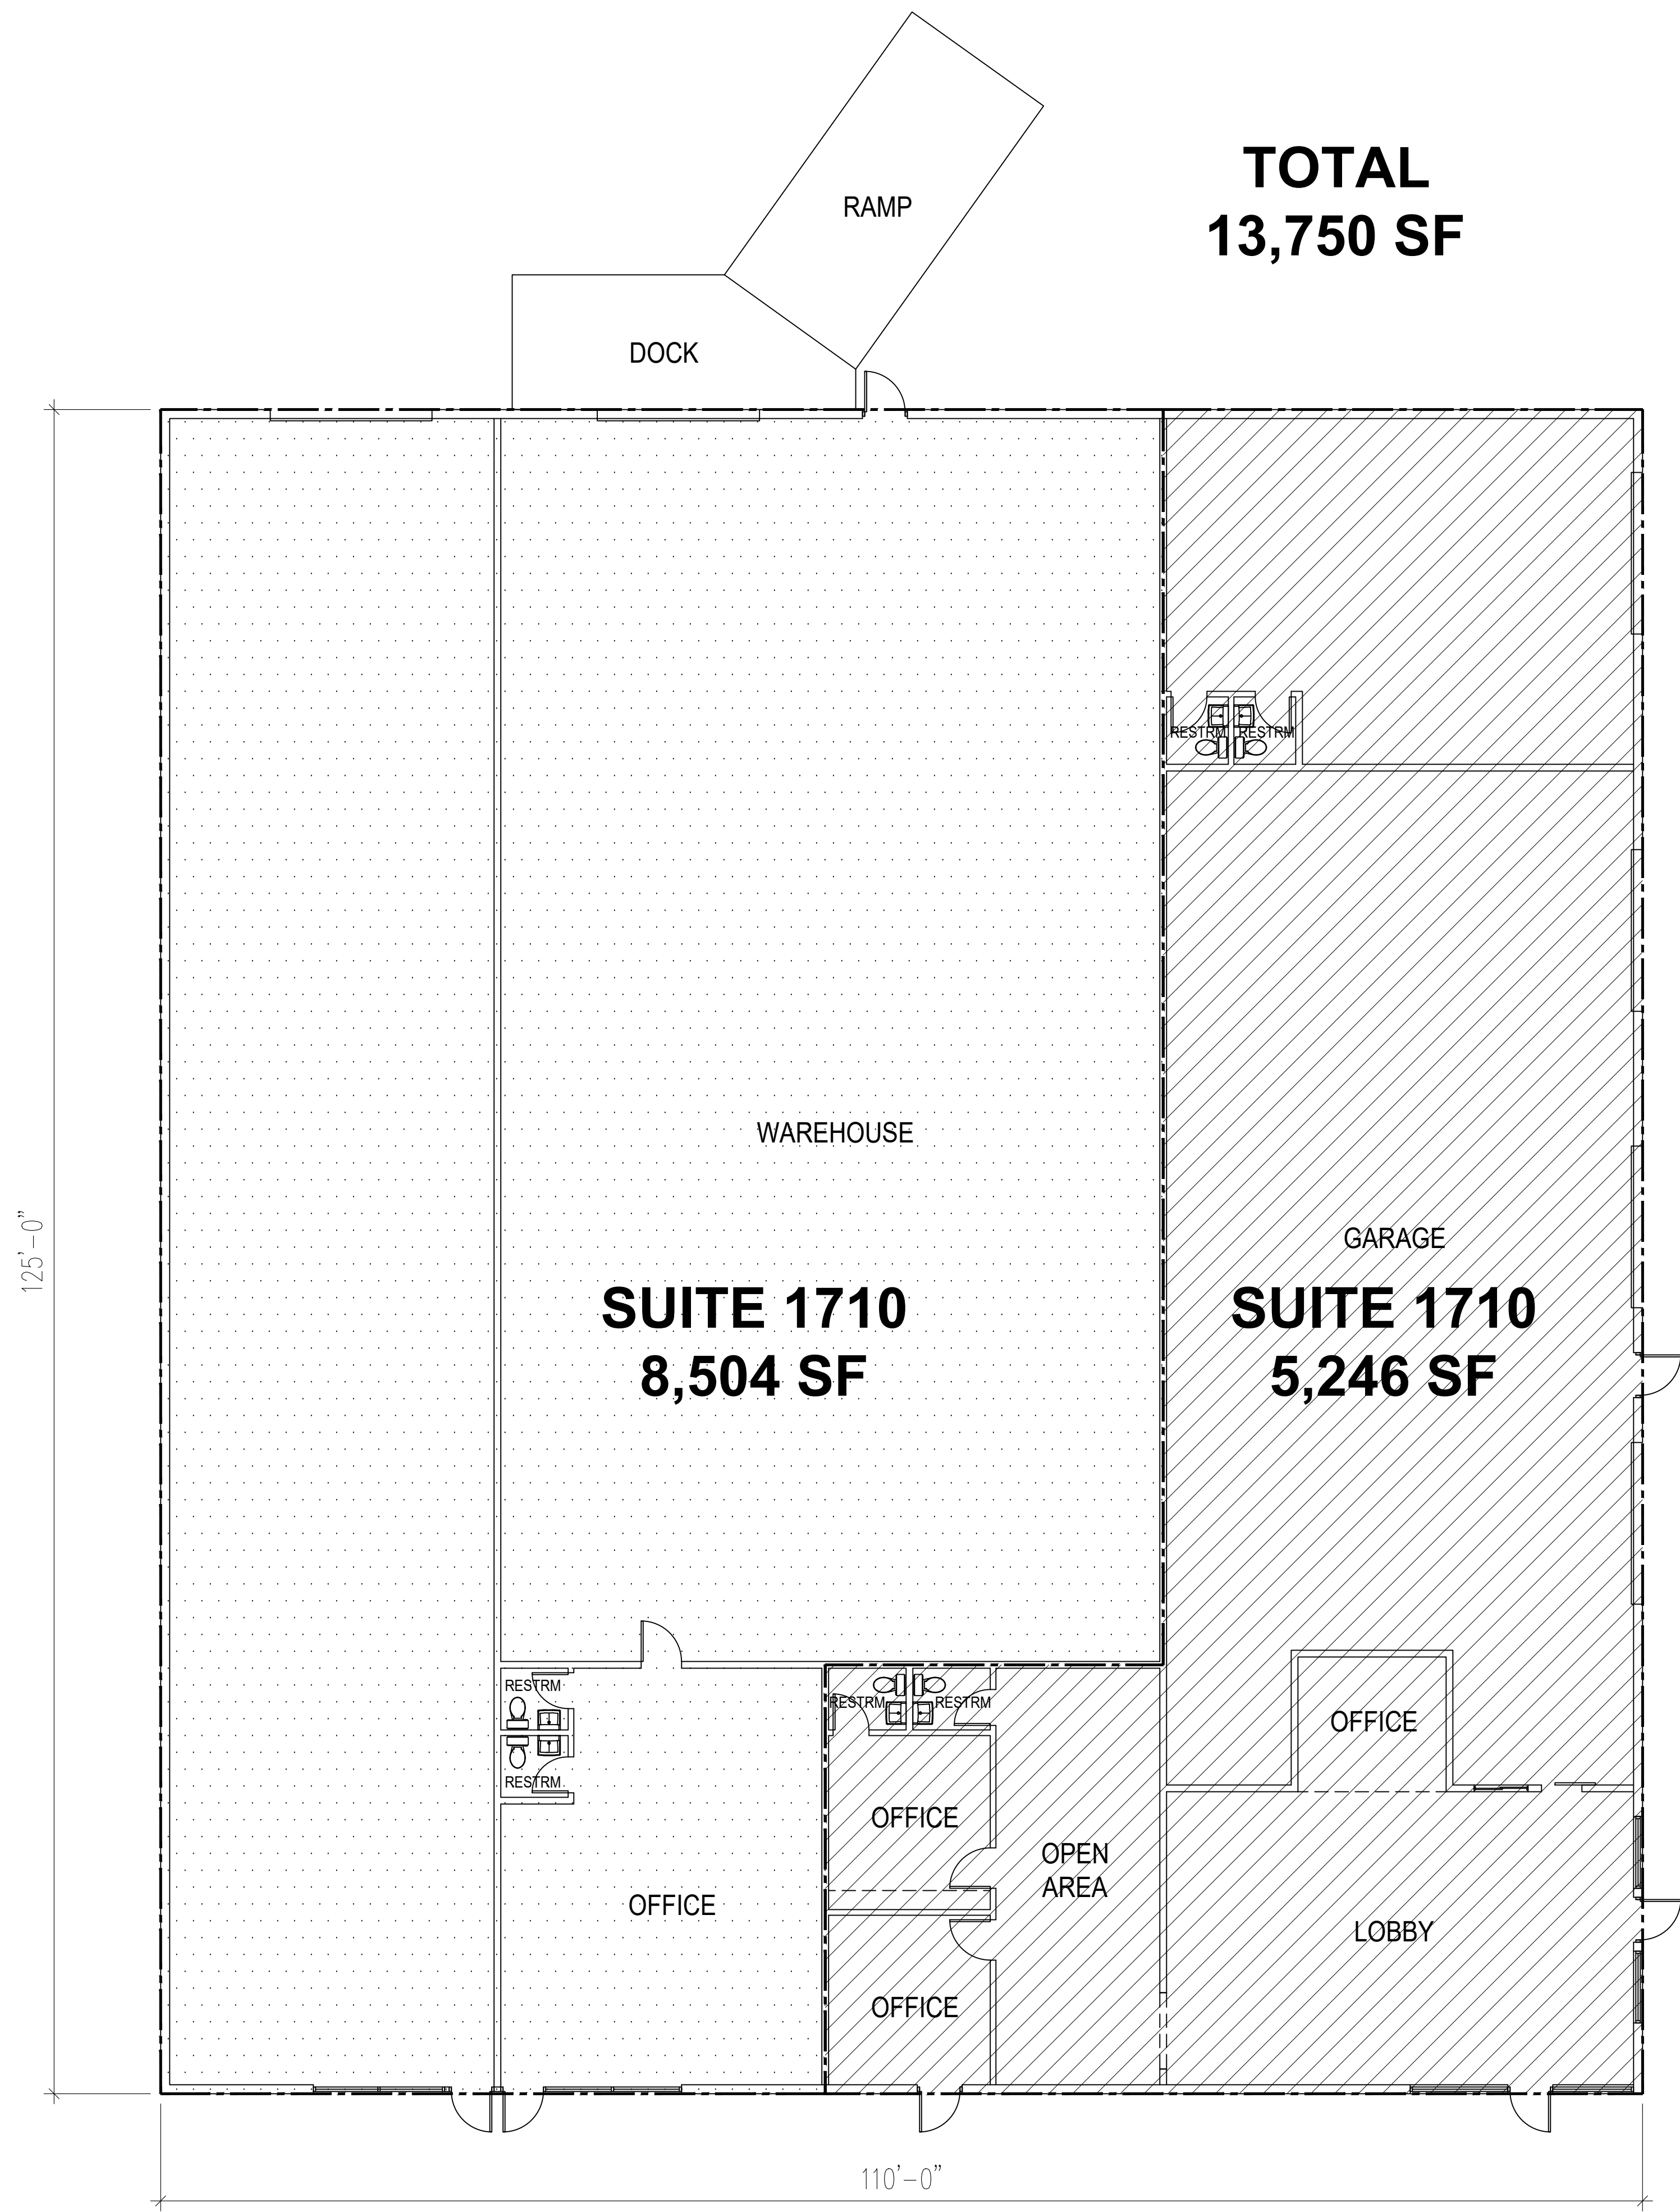

1 Main Structure As-Built Floor Plan (Area Breakdown)
A1.00 SCALE: 1/8" = 1'-0"

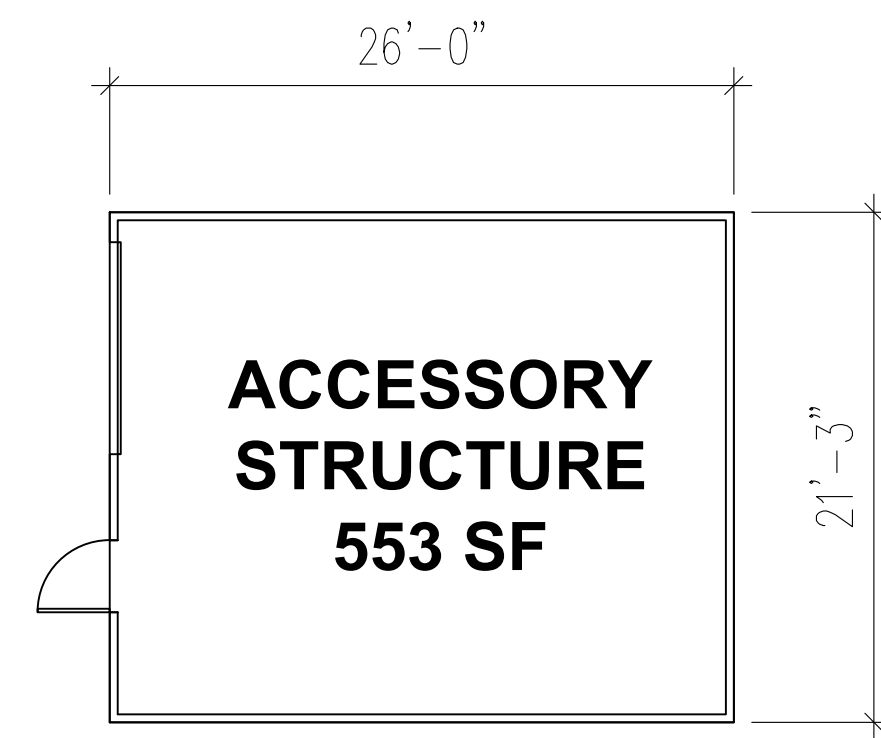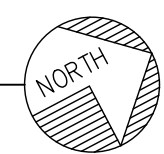

2 Accessory Structure As-Built Floor Plan
A1.00 SCALE: 1/8" = 1'-0"

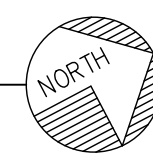

#	REVISION	BY
△		
△		
--

--

1704-1710 Western Ave. Las Vegas, NV 89102	AS-BUILT FLOOR PLAN (AREA BREAKDOWN)
---	--------------------------------------

DATE: 01/19/2026	DRAWN BY:	SCALE: AS NOTED

SHEET A1.00
