



SUITE 202 & 204
AS BUILT - 1 OF 1
205 REGENCY EXECUTIVE PARK
6,420 RSF
SCALE: 3/32" = 1'-0"
DATE: JULY 7, 2026

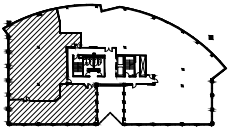

KEY PLAN

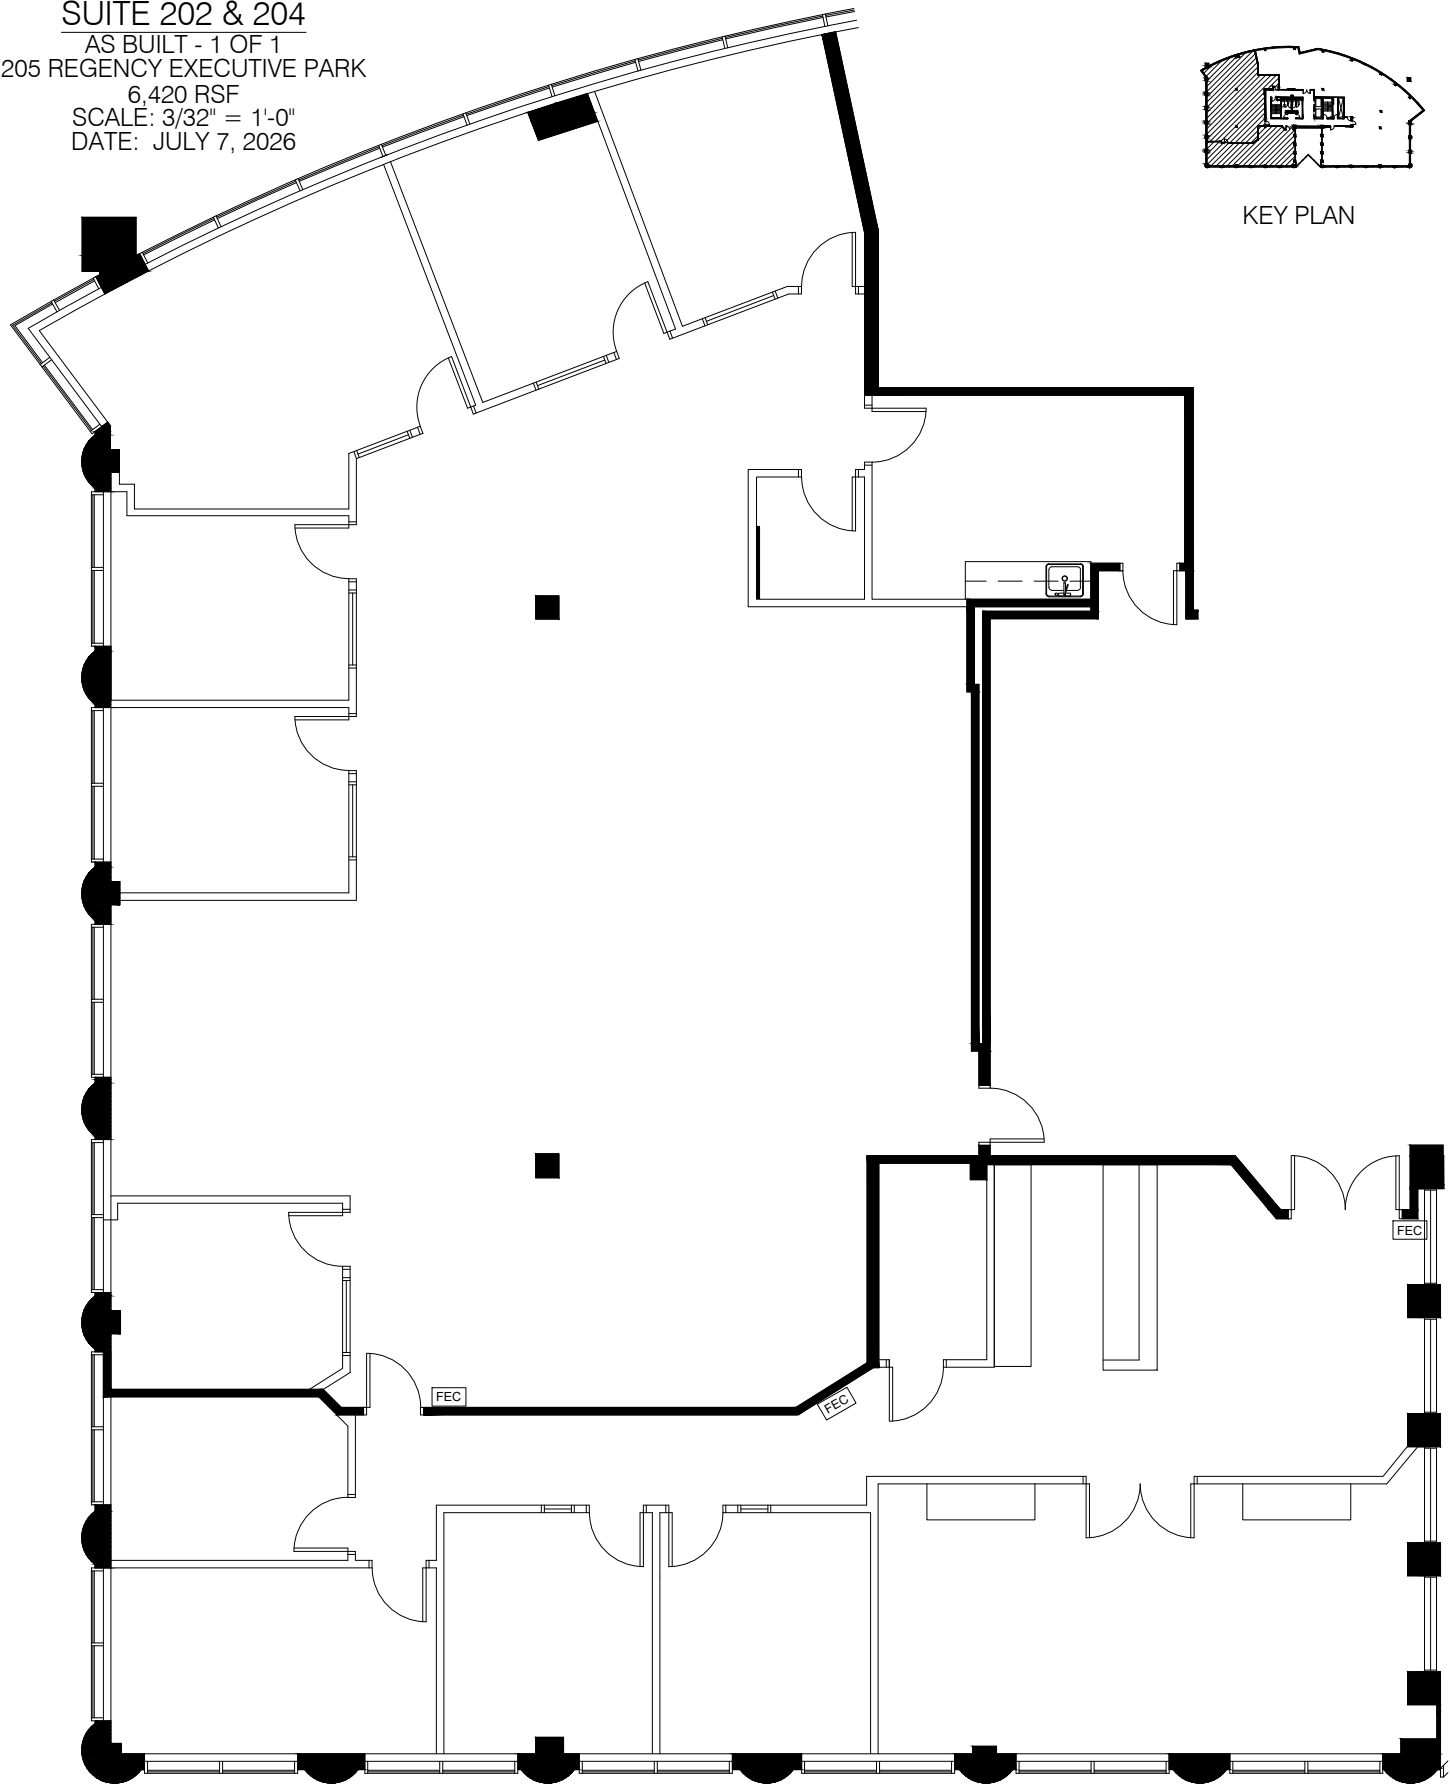

SMITH
HARRIS
DESIGN
associates