

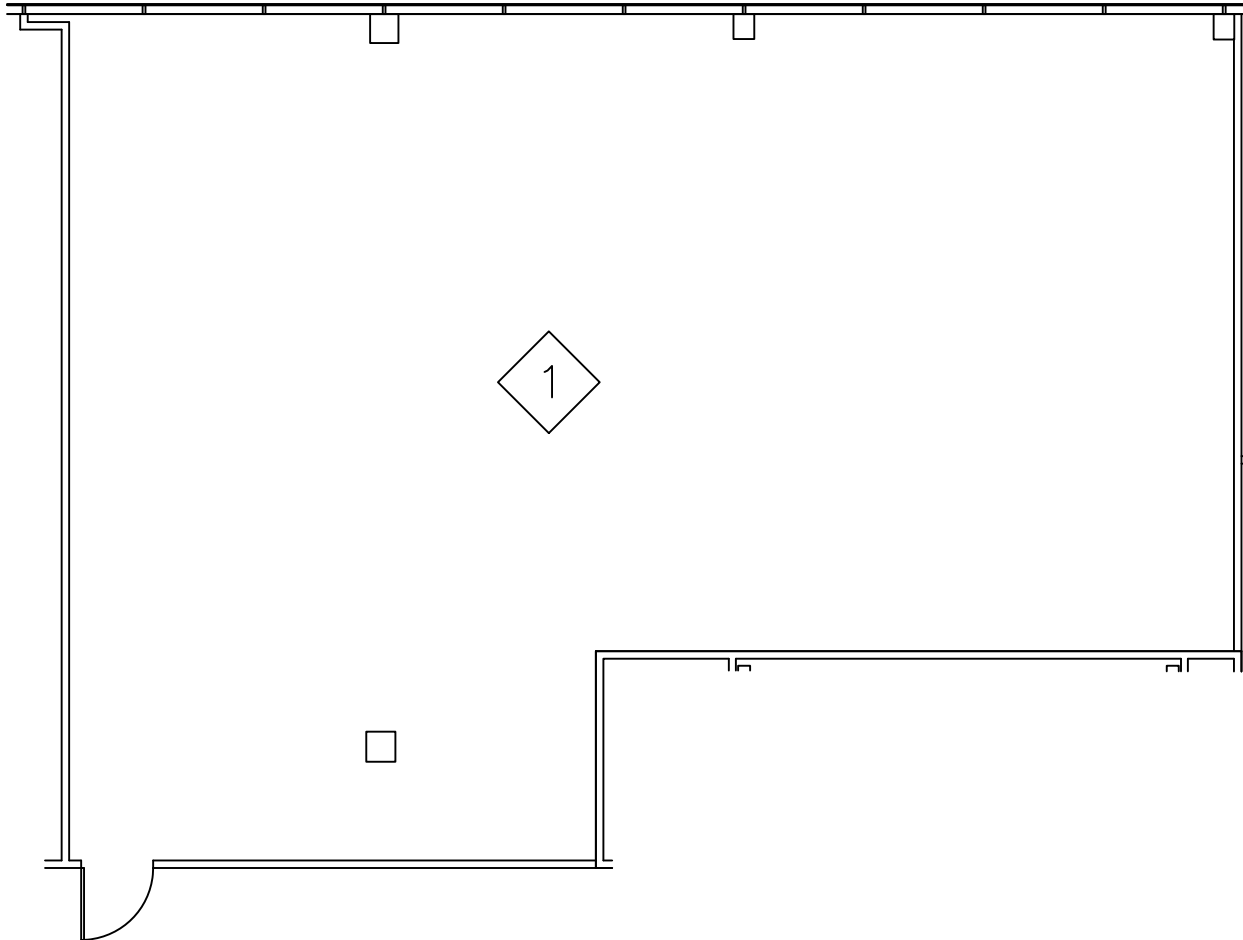


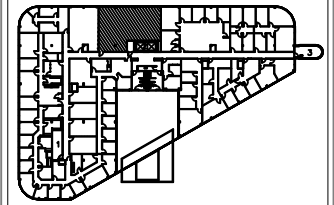

AS-BUILTS FOR SUITE INDICATED HAVE NOT
BEEN VERIFIED BY RADIAN ARCHITECTURE

For Leasing Information Call:
AOEDE 408-520-1625

Suite 341
2440
Texas Parkway
Level 03

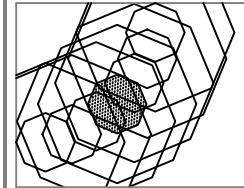

Suite Location:



Suite Area:

1,800 NRSF

Project Number:

2194.CB

Scale:

1/8"=1'-0"

Sheet Number:

AB-341

10.06.21