



1550 Tower | Suite 485
Suite As-Built Plan
1,198 RSF

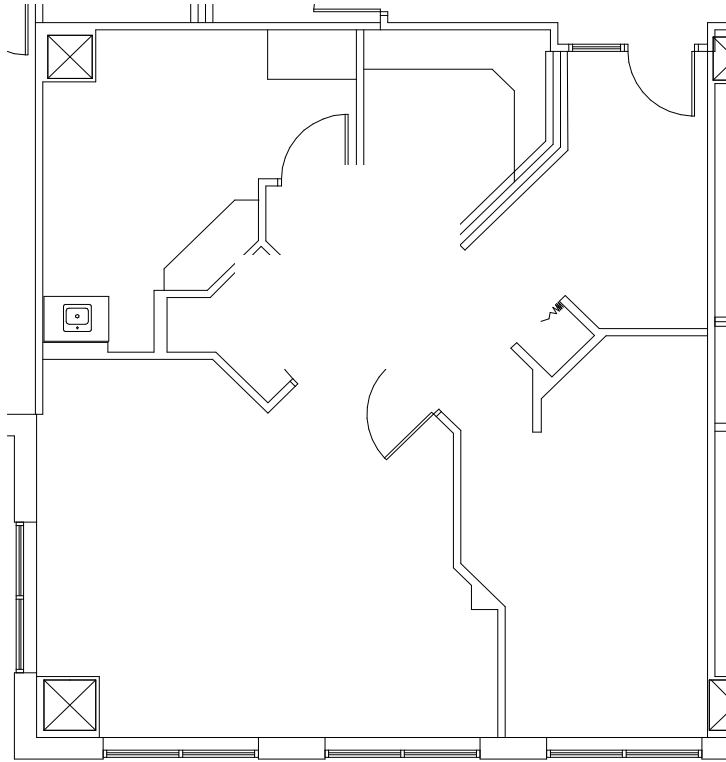

Leased by:

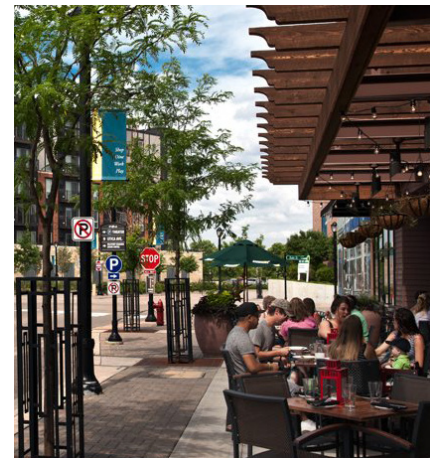