


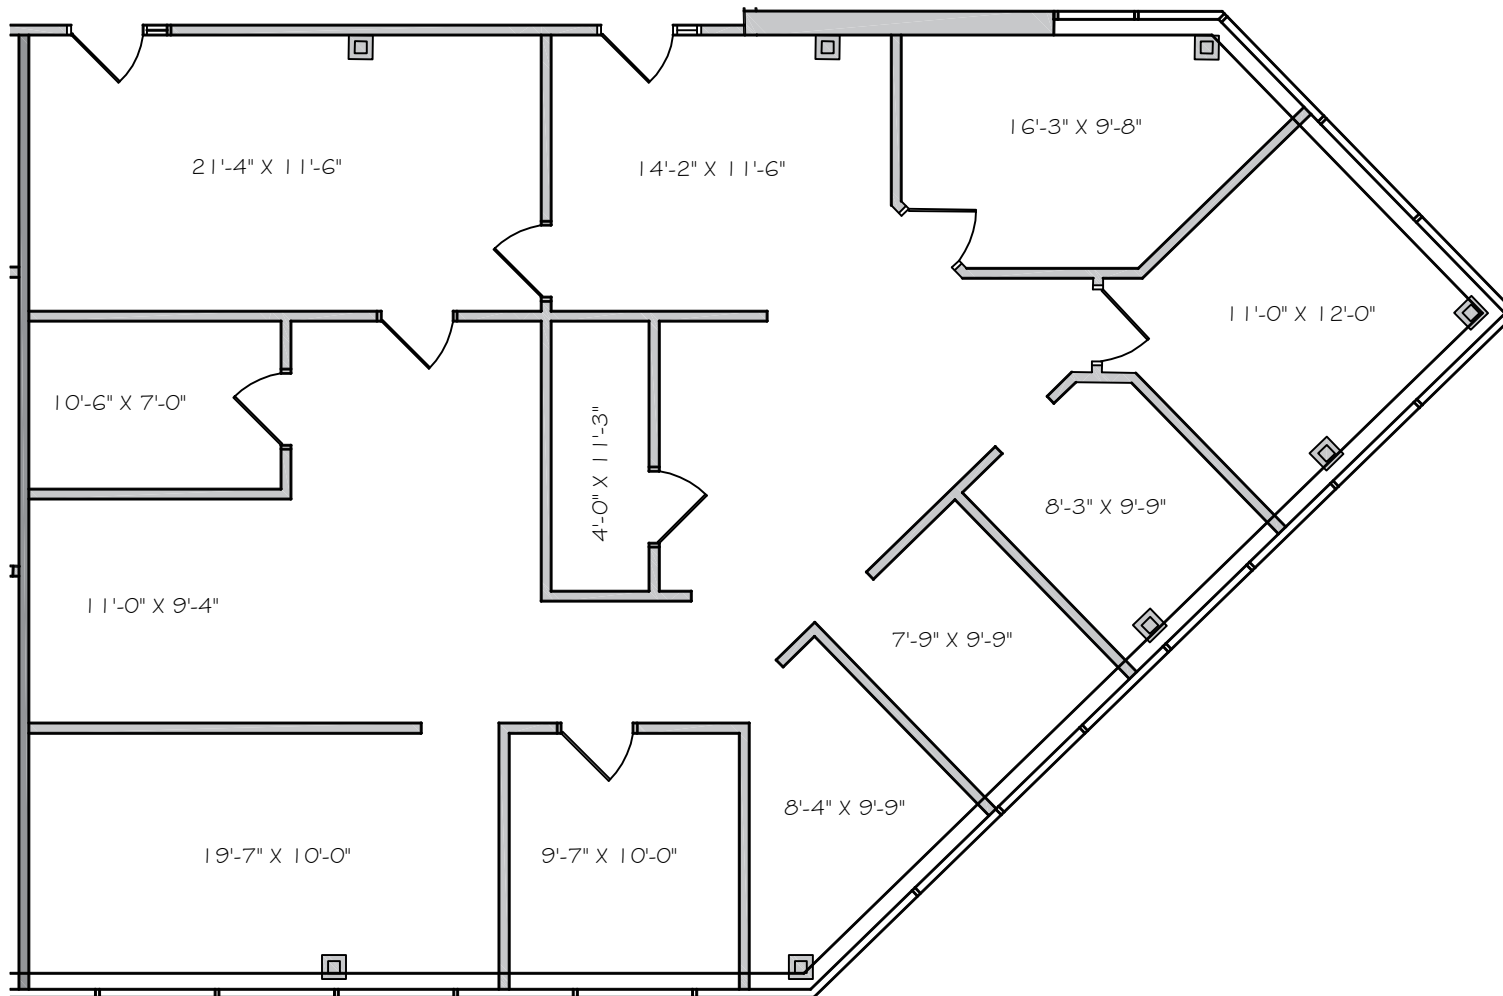

SUITE B-202

GROSS LEASABLE AREA: 2,042 SF


4866 Hardwoods Dr.
West Bloomfield, MI

PROJECT:

Chicago Building
As-Built Suite Plans

LOCATION:

31201 Chicago Rd
Warren, MI

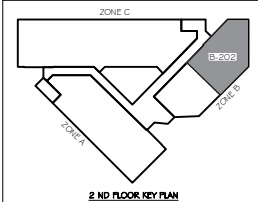

ISSUED:

• 05.21.19

DO NOT SCALE PRINTS USE
FIGURED DIMENSIONS ONLY

JOB NO.

19015

SUITE NO.

B-202