




OFFICE - 5,387 RSF
WAREHOUSE - 8,124 RSF

* INCLUDES % OF METER ROOM

Key Plan

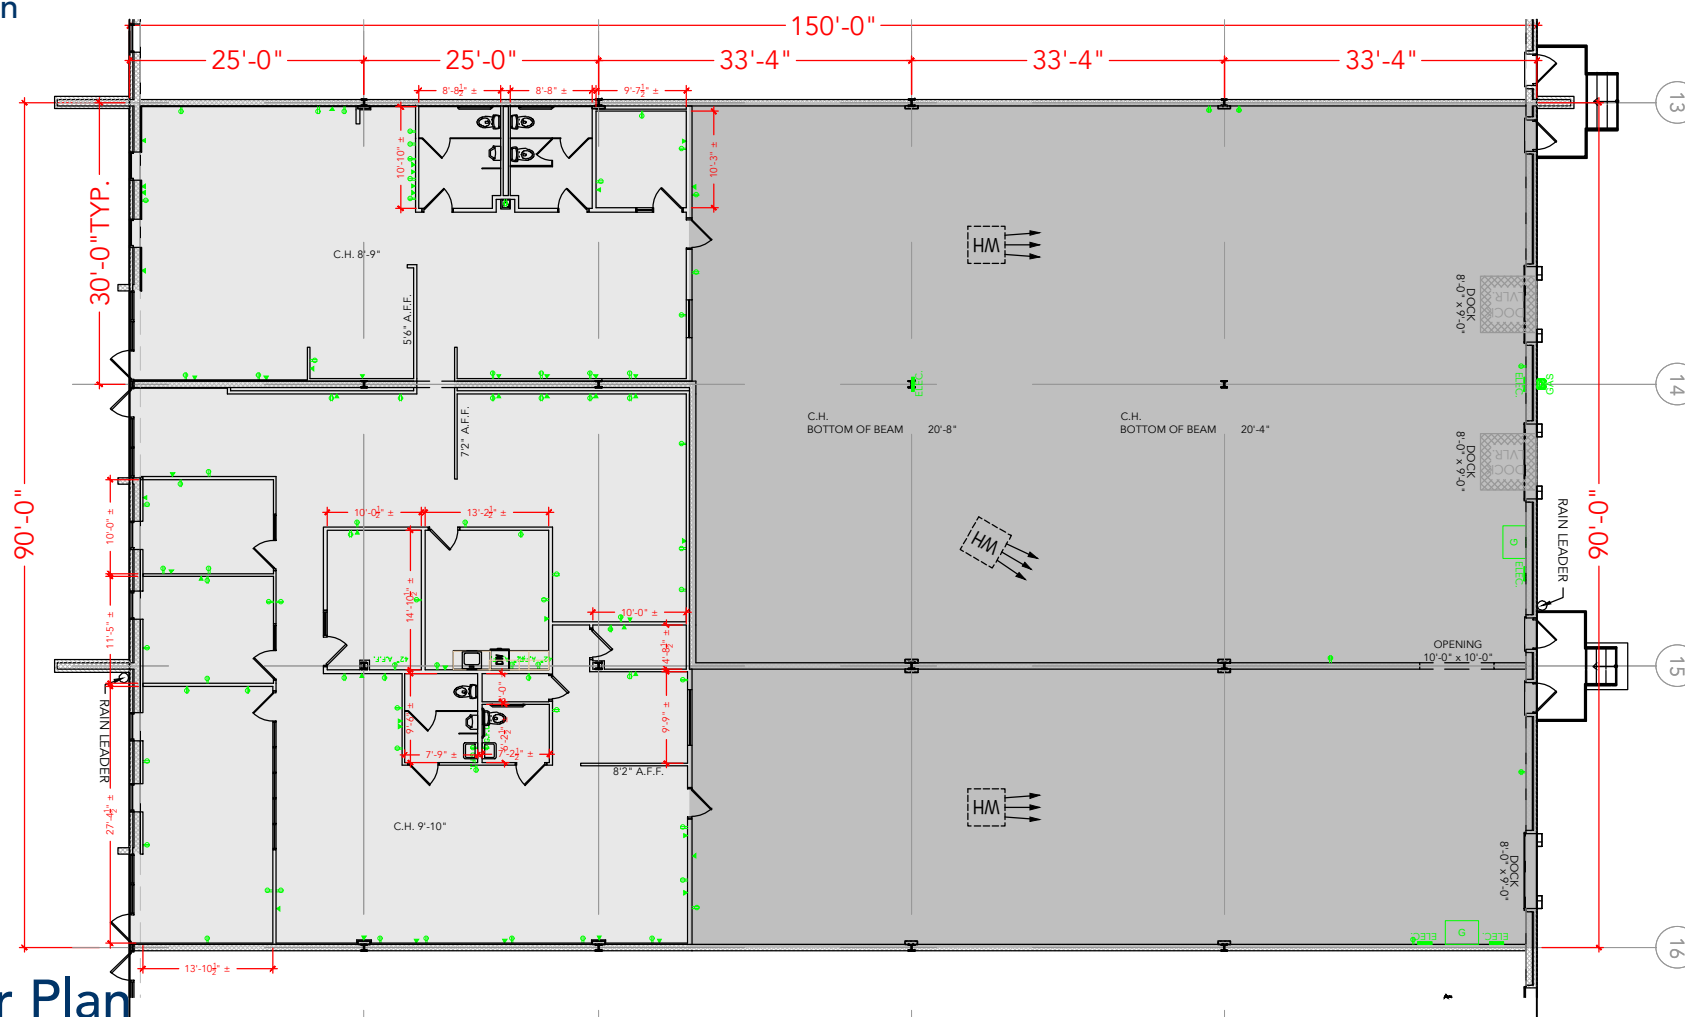

Floor Plan

DRAWING #: HR1-M-P ASBUILT DATE: 09.04.2026