


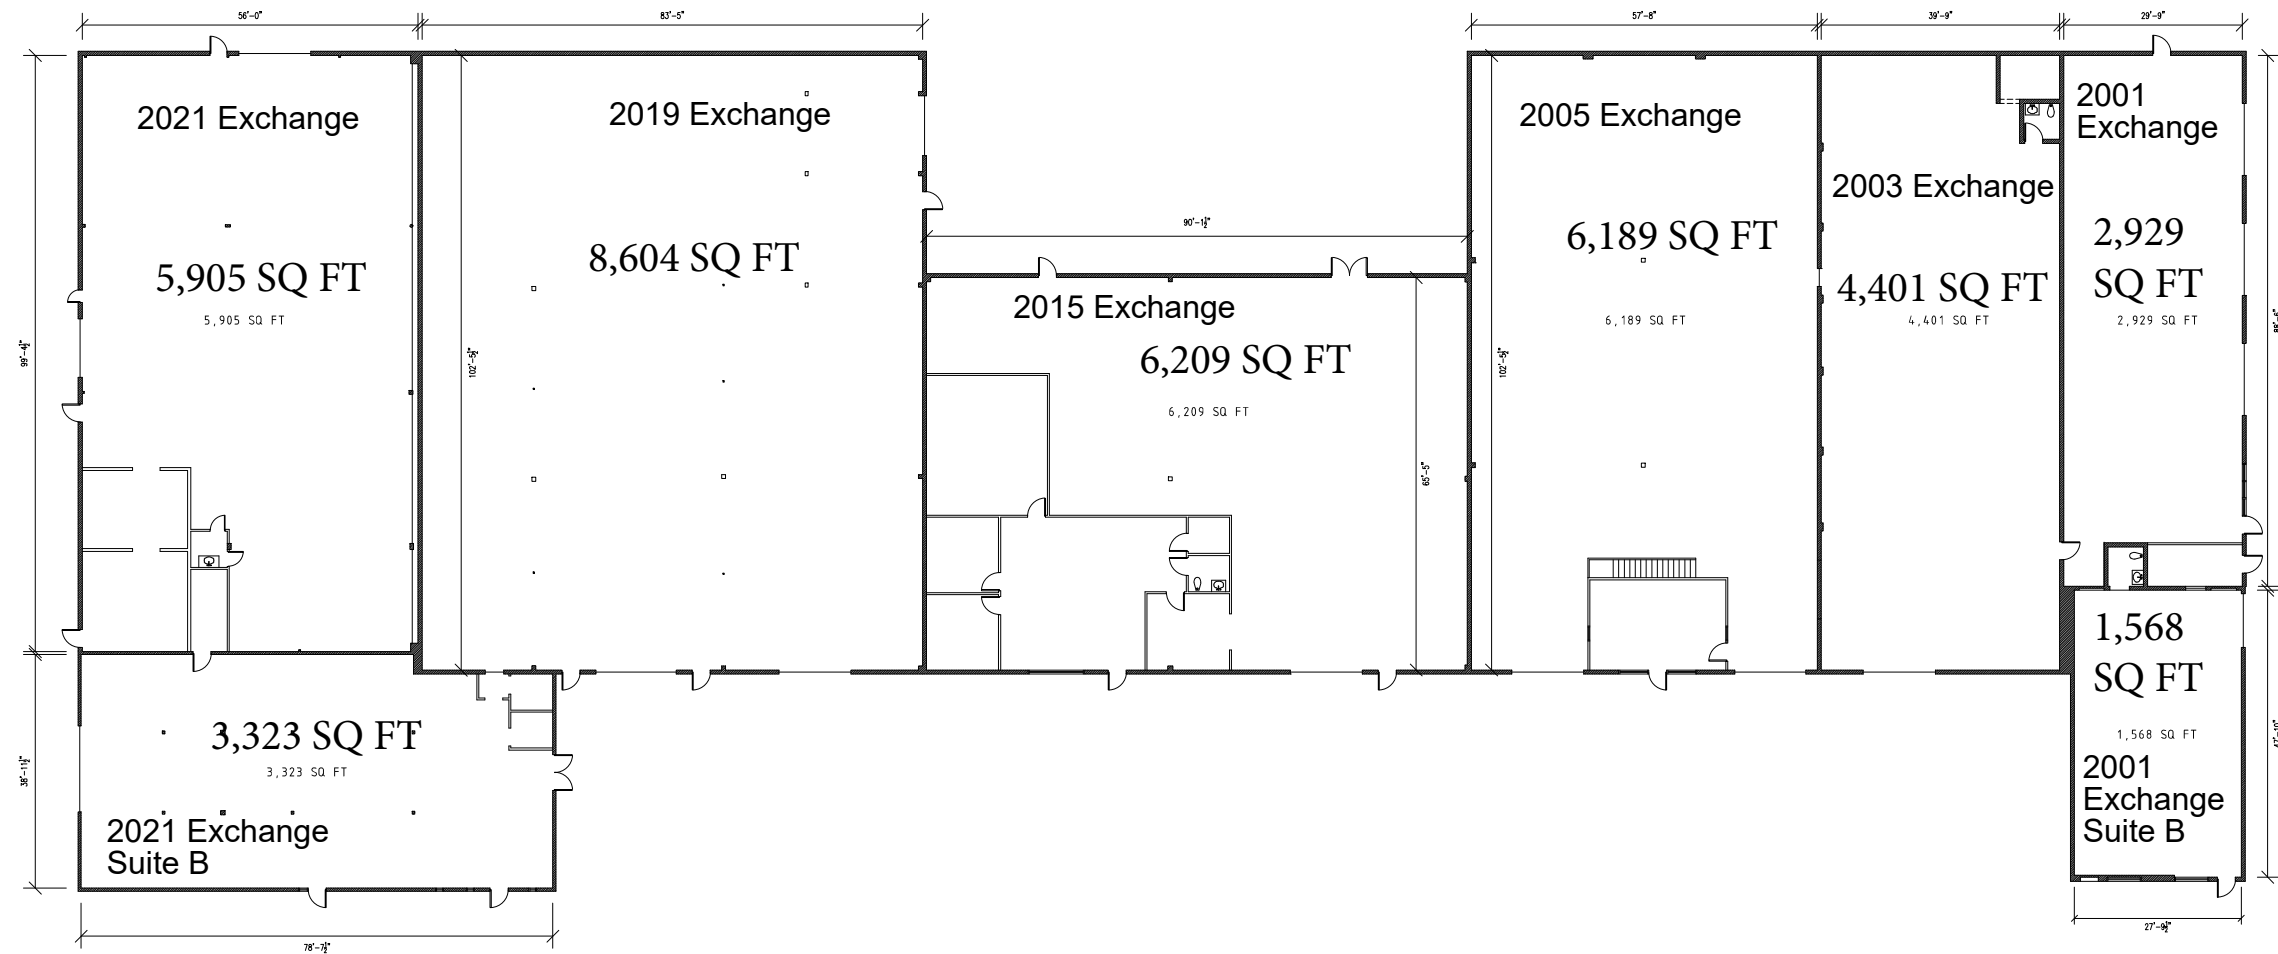

AS BUILT FLOOR PLANS
SCALE: 1/32"=1'-0"

TOTAL
39,753 SQ FT

2019 EXCHANGE AVENUE
OKLAHOMA CITY, OK 73108

DRAFT

AS BUILT
FLOOR PLAN

A1.1