


2782 Dufferin


Apr 26-24

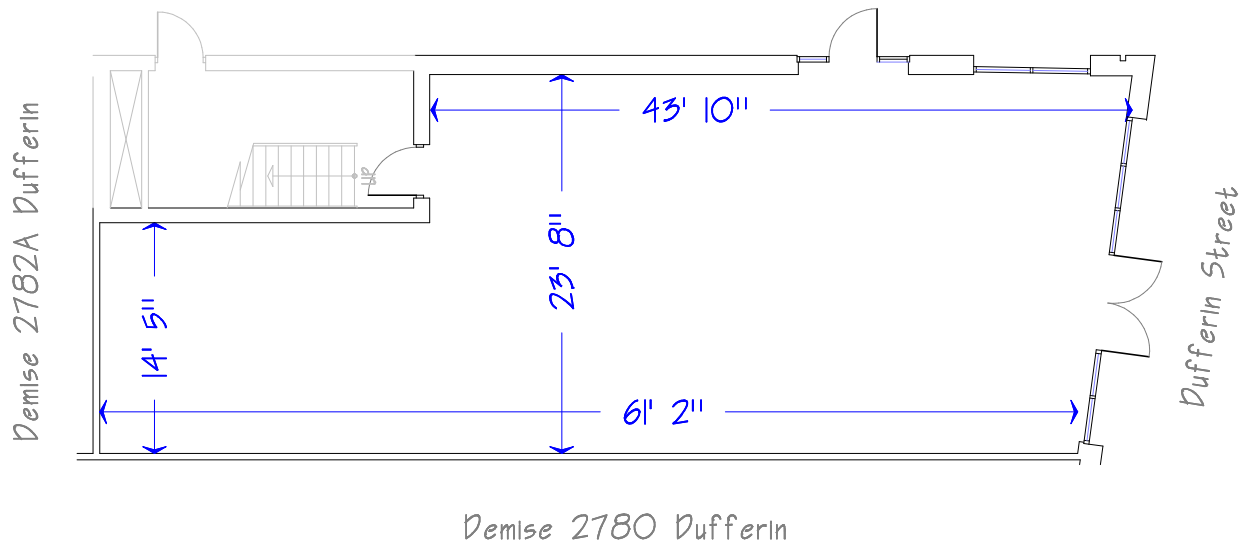

2782 Dufferin St

Toronto, Ontario

as measured April 26, 2024

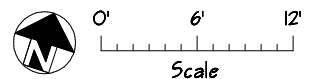

measured
as built
(416) 485-4554