



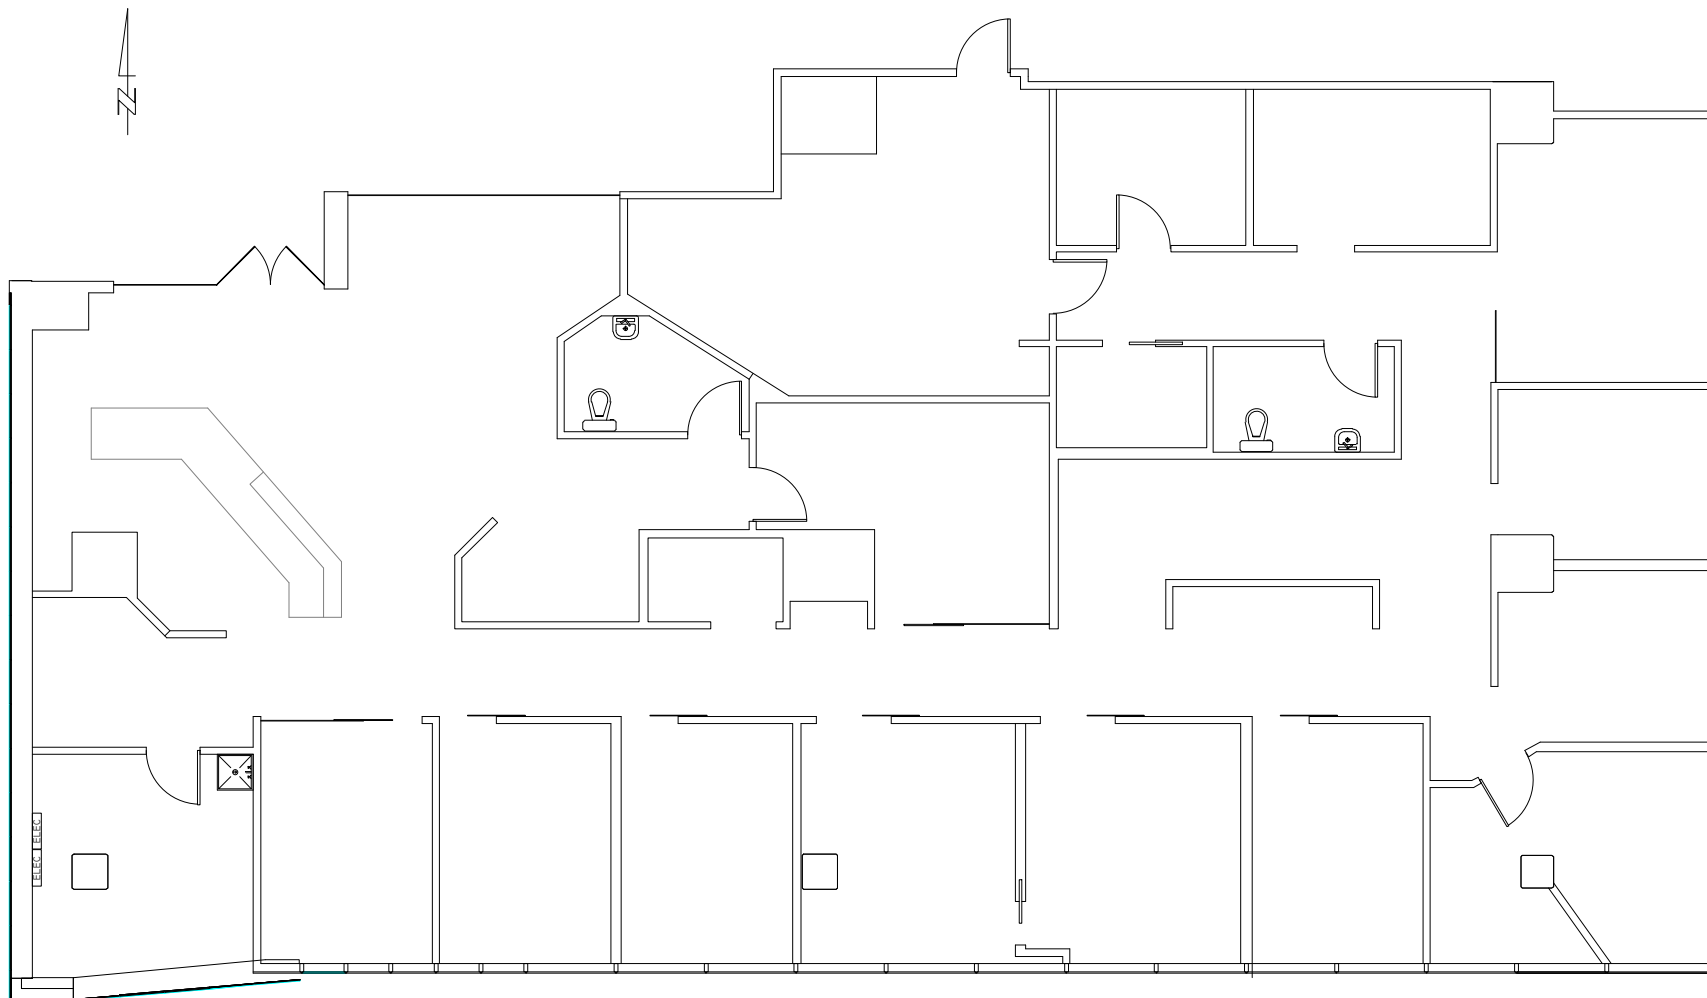

1' 5' 10'
SCALE BAR

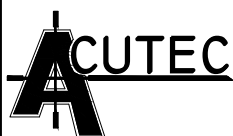

ACUTEC FACILITY DATA CORPORATION			
GLENORA P.O. BOX #53003 EDMONTON, AB T5N 4A8		BUS: (780)-413-4895 FAX: (780)-413-4896	
DRAWN BY:	DATE	CHECKED BY:	DATE
JB	01-11-18	JB	05-11-18
SCALE:		DRAWING:	
3/32" = 1' 0"		#203	

#203, STANTEC TOWER
10220 103 AVENUE
EDMONTON, AB

COMMENTS:
AS-BUILT DRAWING — OCTOBER 5, 2022