


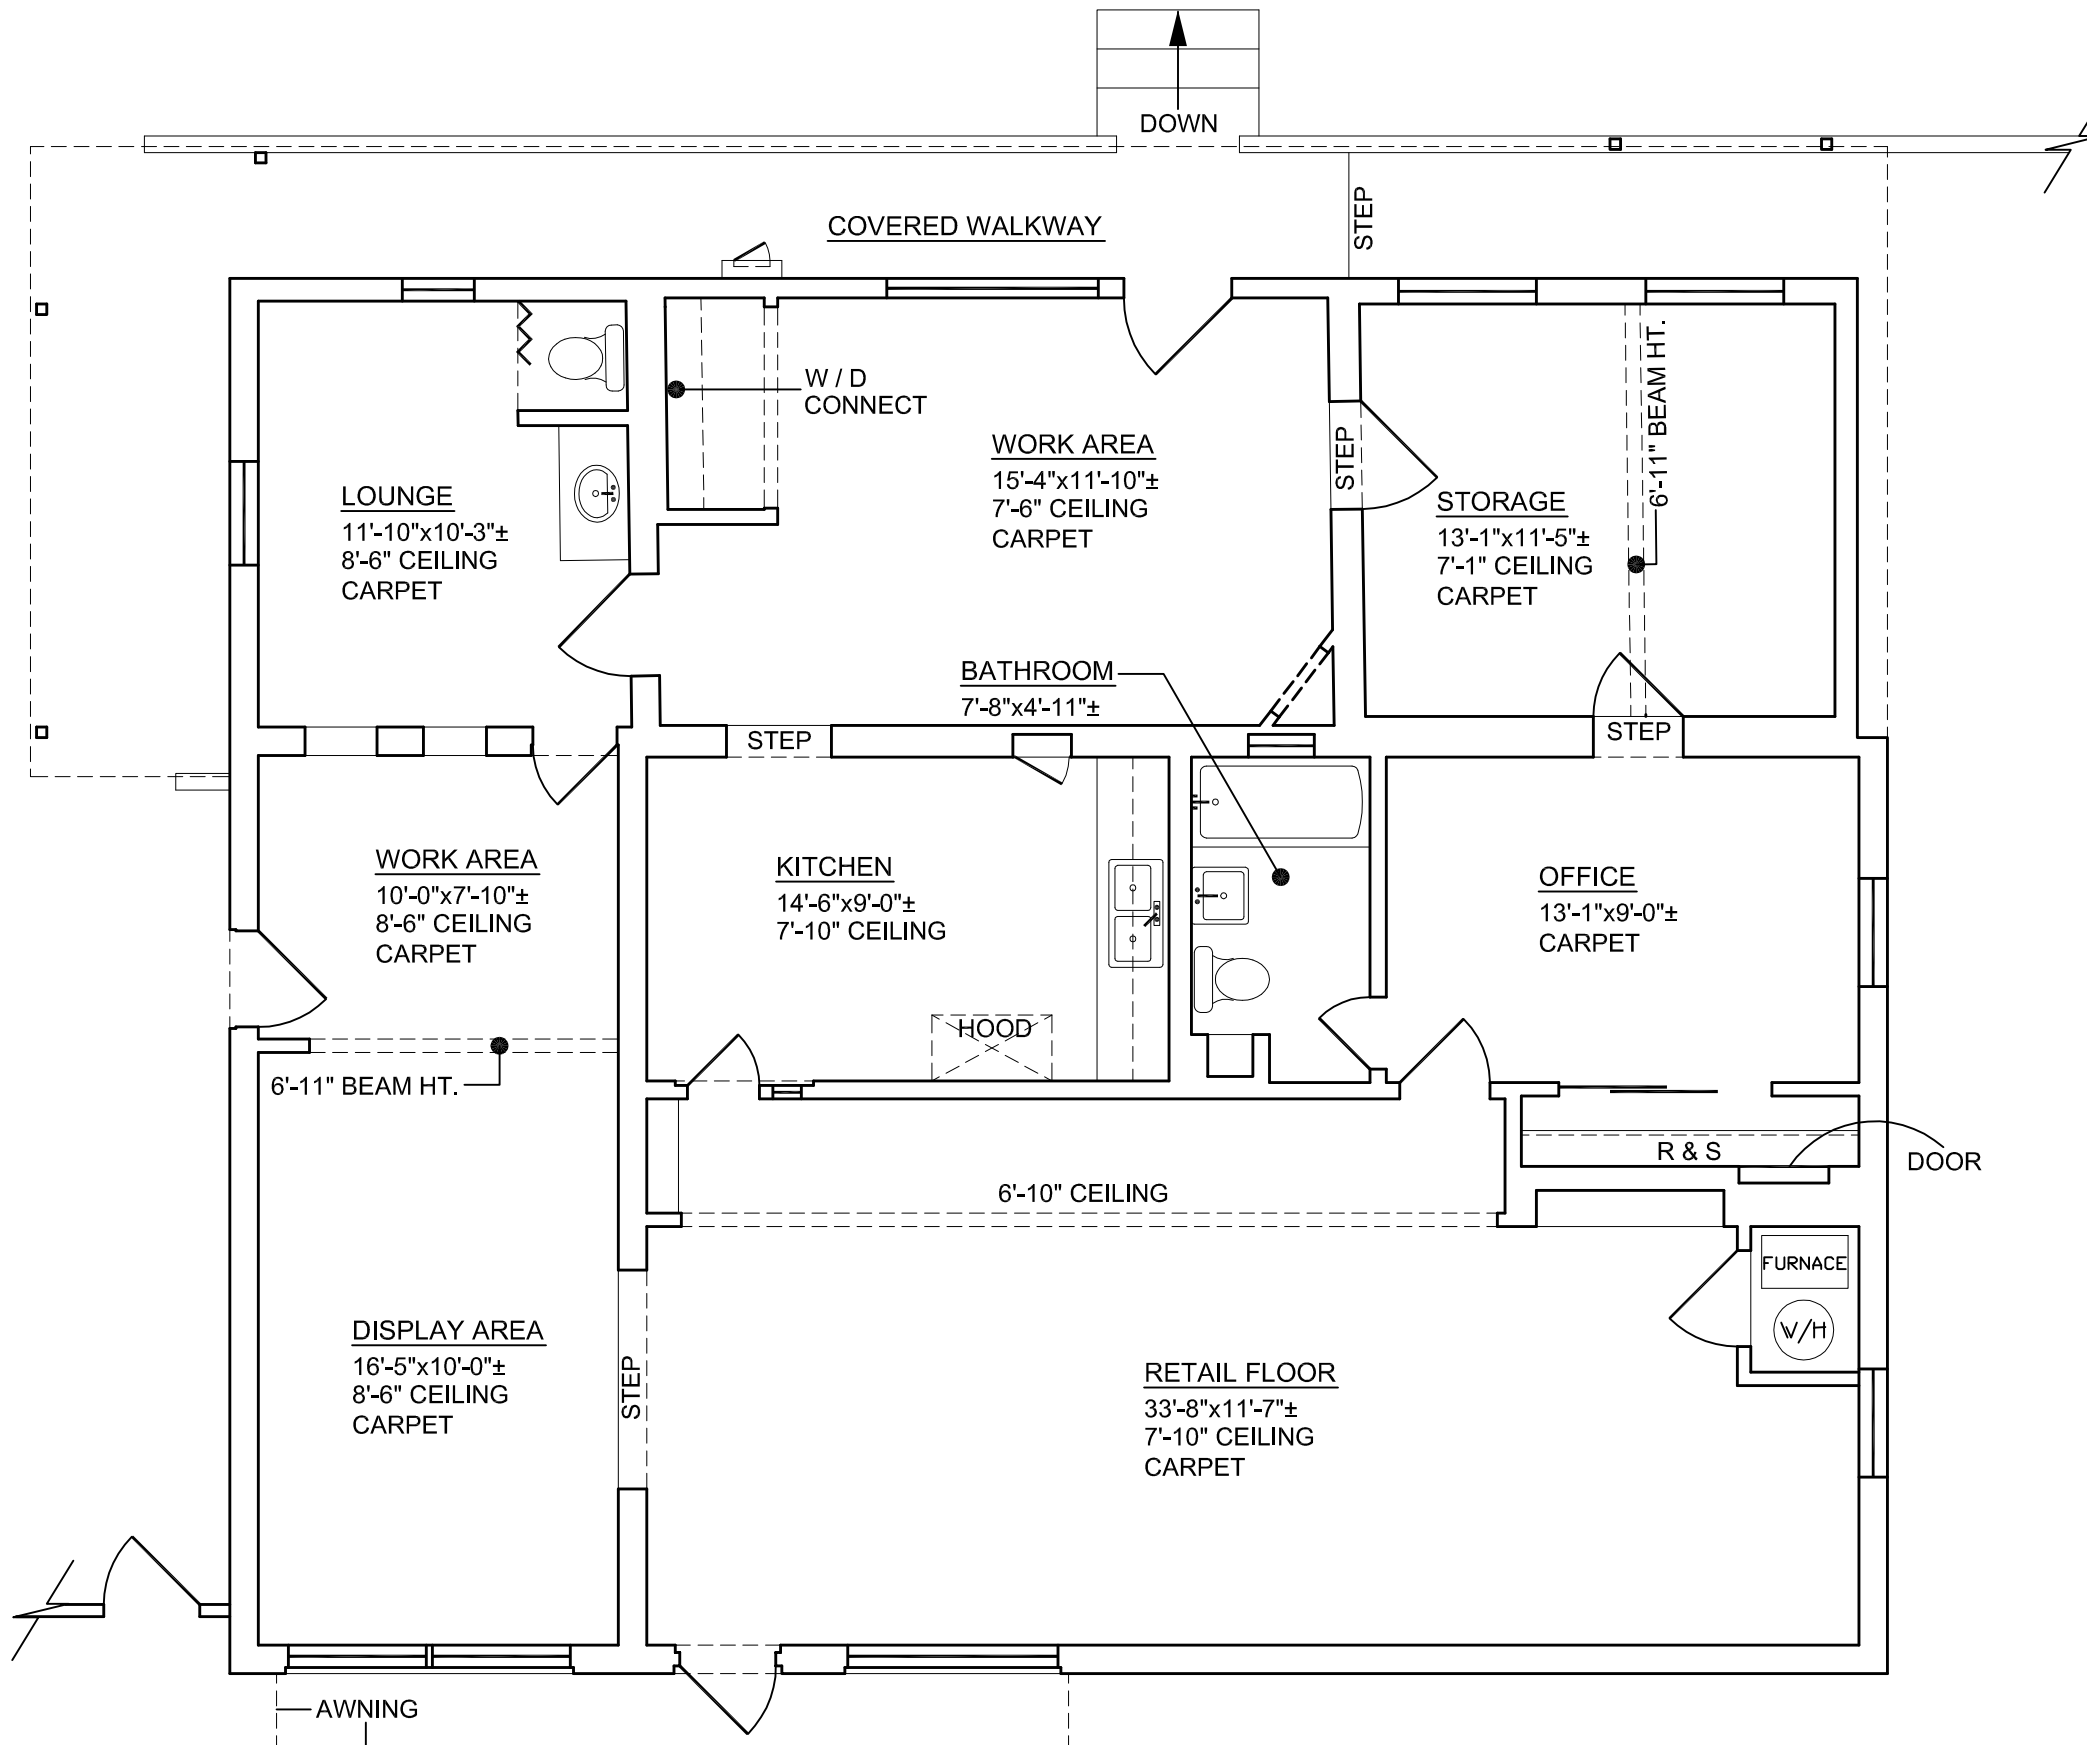


NOTES

1. ALL CALCULATIONS INDICATE "GROSS" AREA AS PER "BOMA" STANDARDS.
2. ALL FIXTURES INDICATED ARE BUILT-IN.
3. ALL FLOORS ARE VINYL UNLESS OTHERWISE INDICATED.
4. ALL CEILING HEIGHTS ARE 7'-11" UNLESS OTHERWISE NOTED.
5. ALL DIMENSIONS TO BE FIELD VERIFIED PRIOR TO ANY CONSTRUCTION.
6. SOME DIMENSIONS MAY VARY DUE TO WALLS OUT OF PLUMB.

AREA CALCULATIONS:

GROSS BUILDING AREA 1,773.48 SQ. FT.

2837 SAN MATEO BLVD. NE

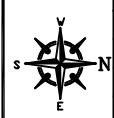	ORIENTATION	MEASURED BY	JR	REVISIONS
		DESIGNED BY	N.A.	
		DRAFTED BY	JR	
		CHECKED BY	P.M.	
		REVISED:		
SCALE	3/16"=1'-0"	DATE	11/24/21	

SHEET #
01
OF 01

PROJECT:
2837
SAN MATEO
BLVD. NE

DESCRIPTION:
AS-BUILT
DRAWING

CLIENT:
UNA
ESQUINA
LLC.


505-899-1199