



BASEMENT 3011
ALL CONCRETE

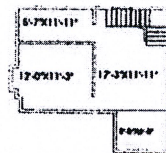


BASEMENT 3015
ALL CONCRETE

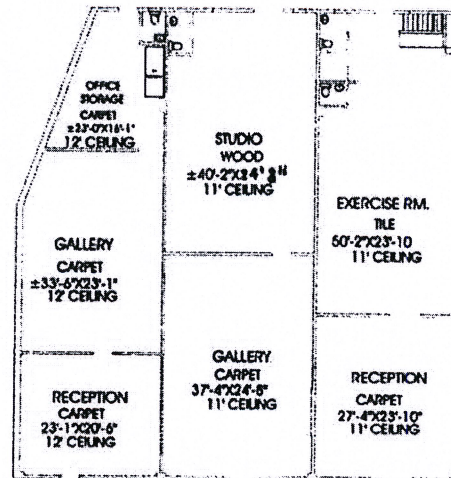

3011 3013 3015



FRONT ELEVATION

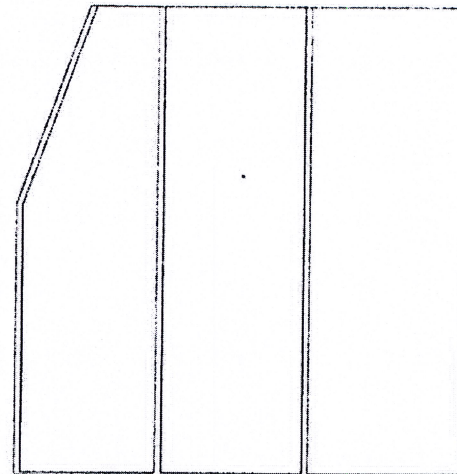

ROOF PLAN

- NOTES:
1. AREA CALCULATIONS INDICATE "GROSS" AREA AS PER "BOMA" STANDARDS.
 2. ALL FLOOR COVERINGS ARE AS NOTED.
 3. ALL FIXTURES INDICATED ARE BUILT-IN.

AREA CALCULATIONS (IN SQ.FT.):

3011-B	1377.11
3011	1722.96
3013	1989.59
3015	1982.72
3015-B	527.90

Leased @ 1700/m²



REAR ELEVATION

MEASURED BY: SIM
DRAFTED BY: SIM
CHECKED BY: M.G.
REVISED ON:

SCALE: 1/8" = 1'-0" DATE: 1.23.97



ORIENTATION

SHEET #
1
OF 1

PROJECT:
3011/13/15
MONTE
VISTA
NORTHEAST
DESCRIPTION
AS-BUILT
DRAWING
AND
ELEVATIONS
CLIENT:
DARTMOUTH
STREET
GALLERY

CLIENT REFERENCE #


97015

COMPUTER DRAFTING & DESIGN BY:



CALL: 505-899-1199

*5695 Main Floor
1405 Basement*

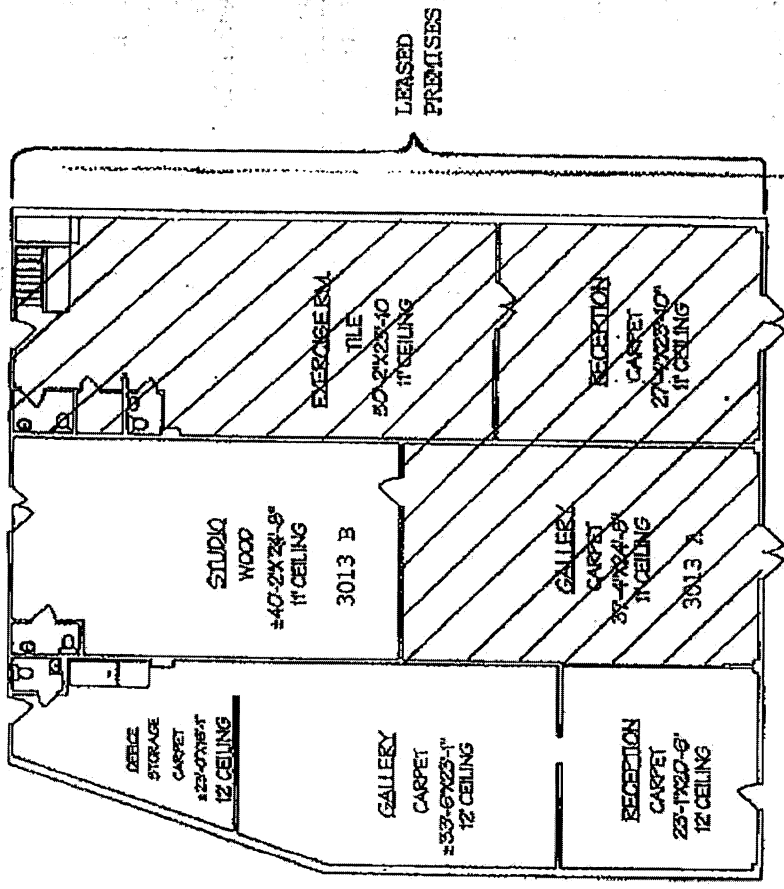

3011

3013

3015

MONTA VISTA BLVD. NE, ALBUQUERQUE, NM 87106

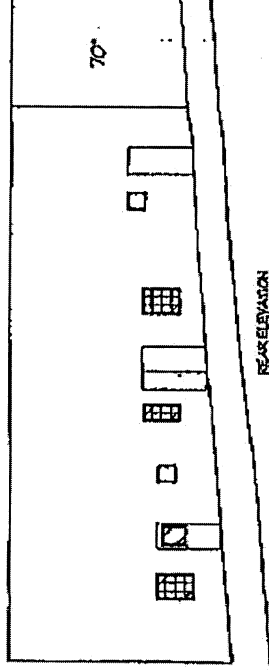
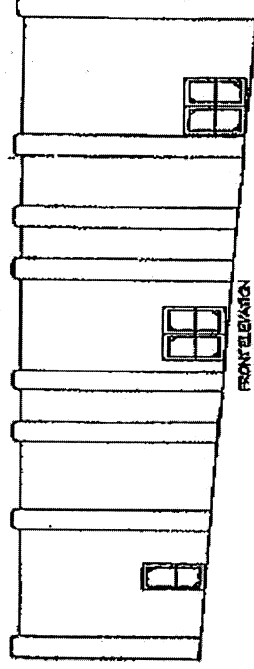


EXHIBIT A