



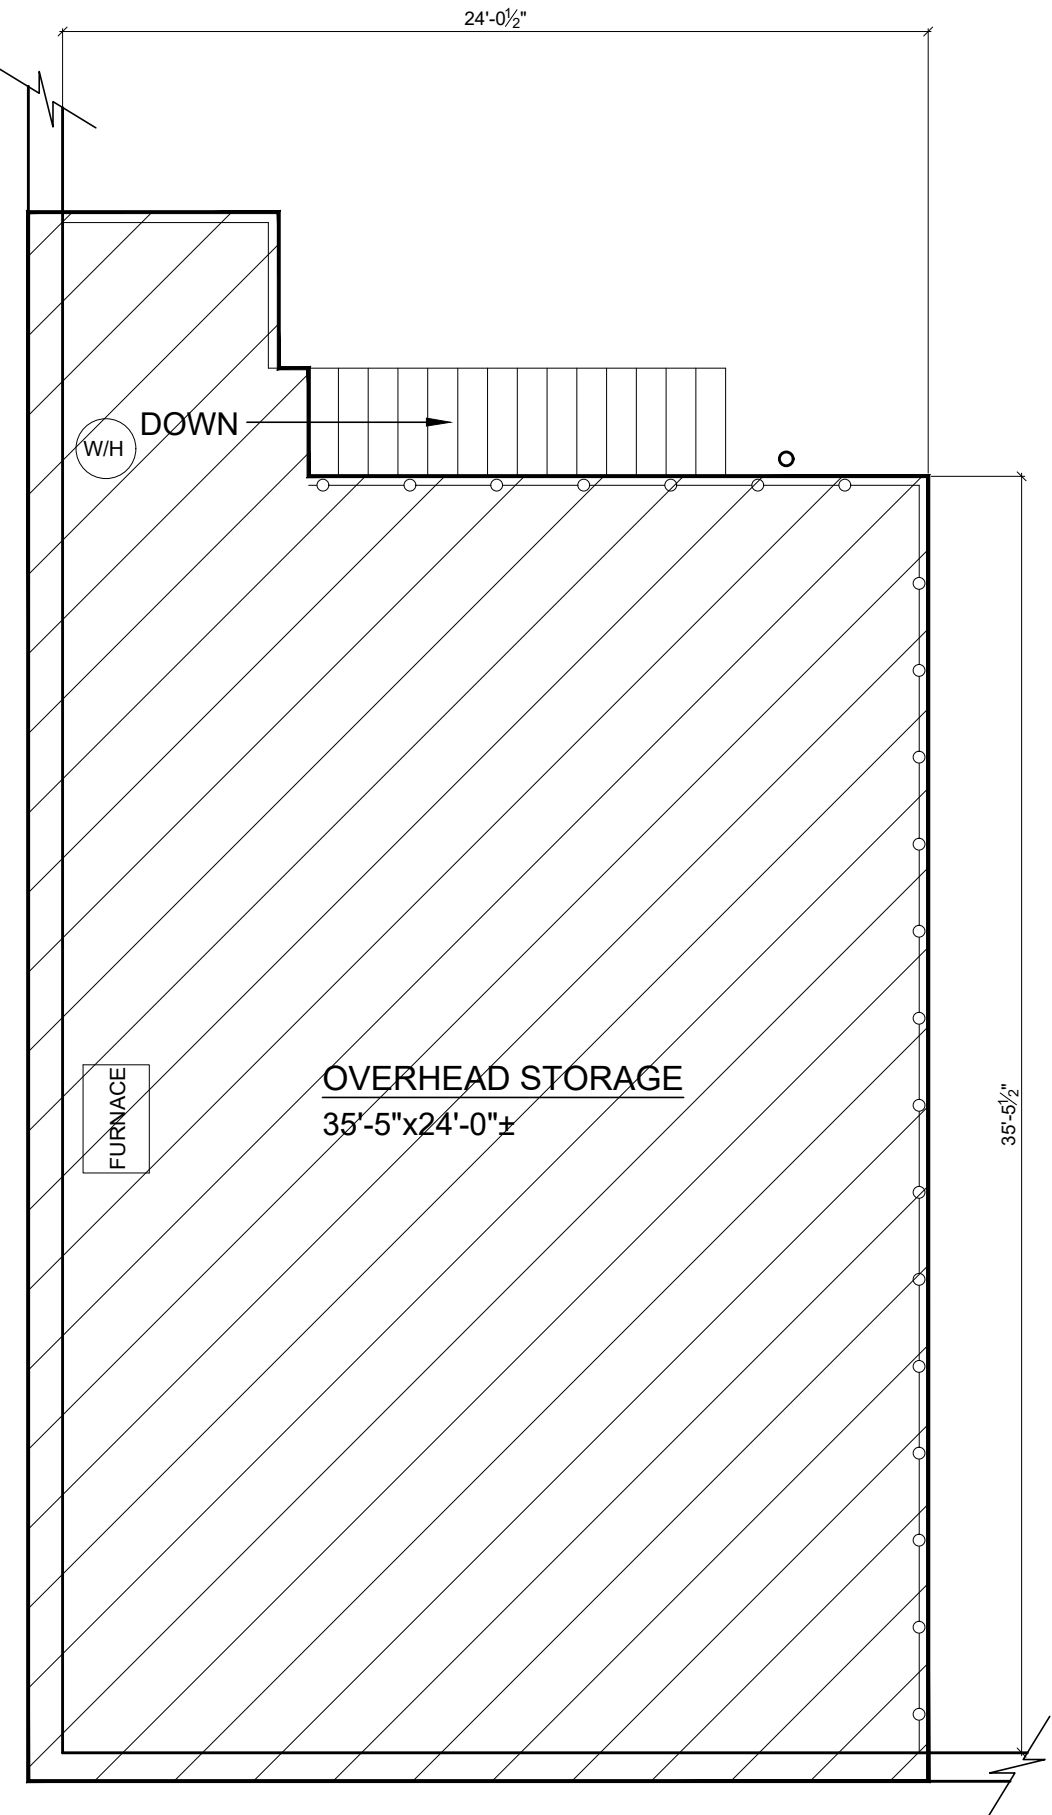

1244 CALLE DE COMERCIO
OVERHEAD STORAGE

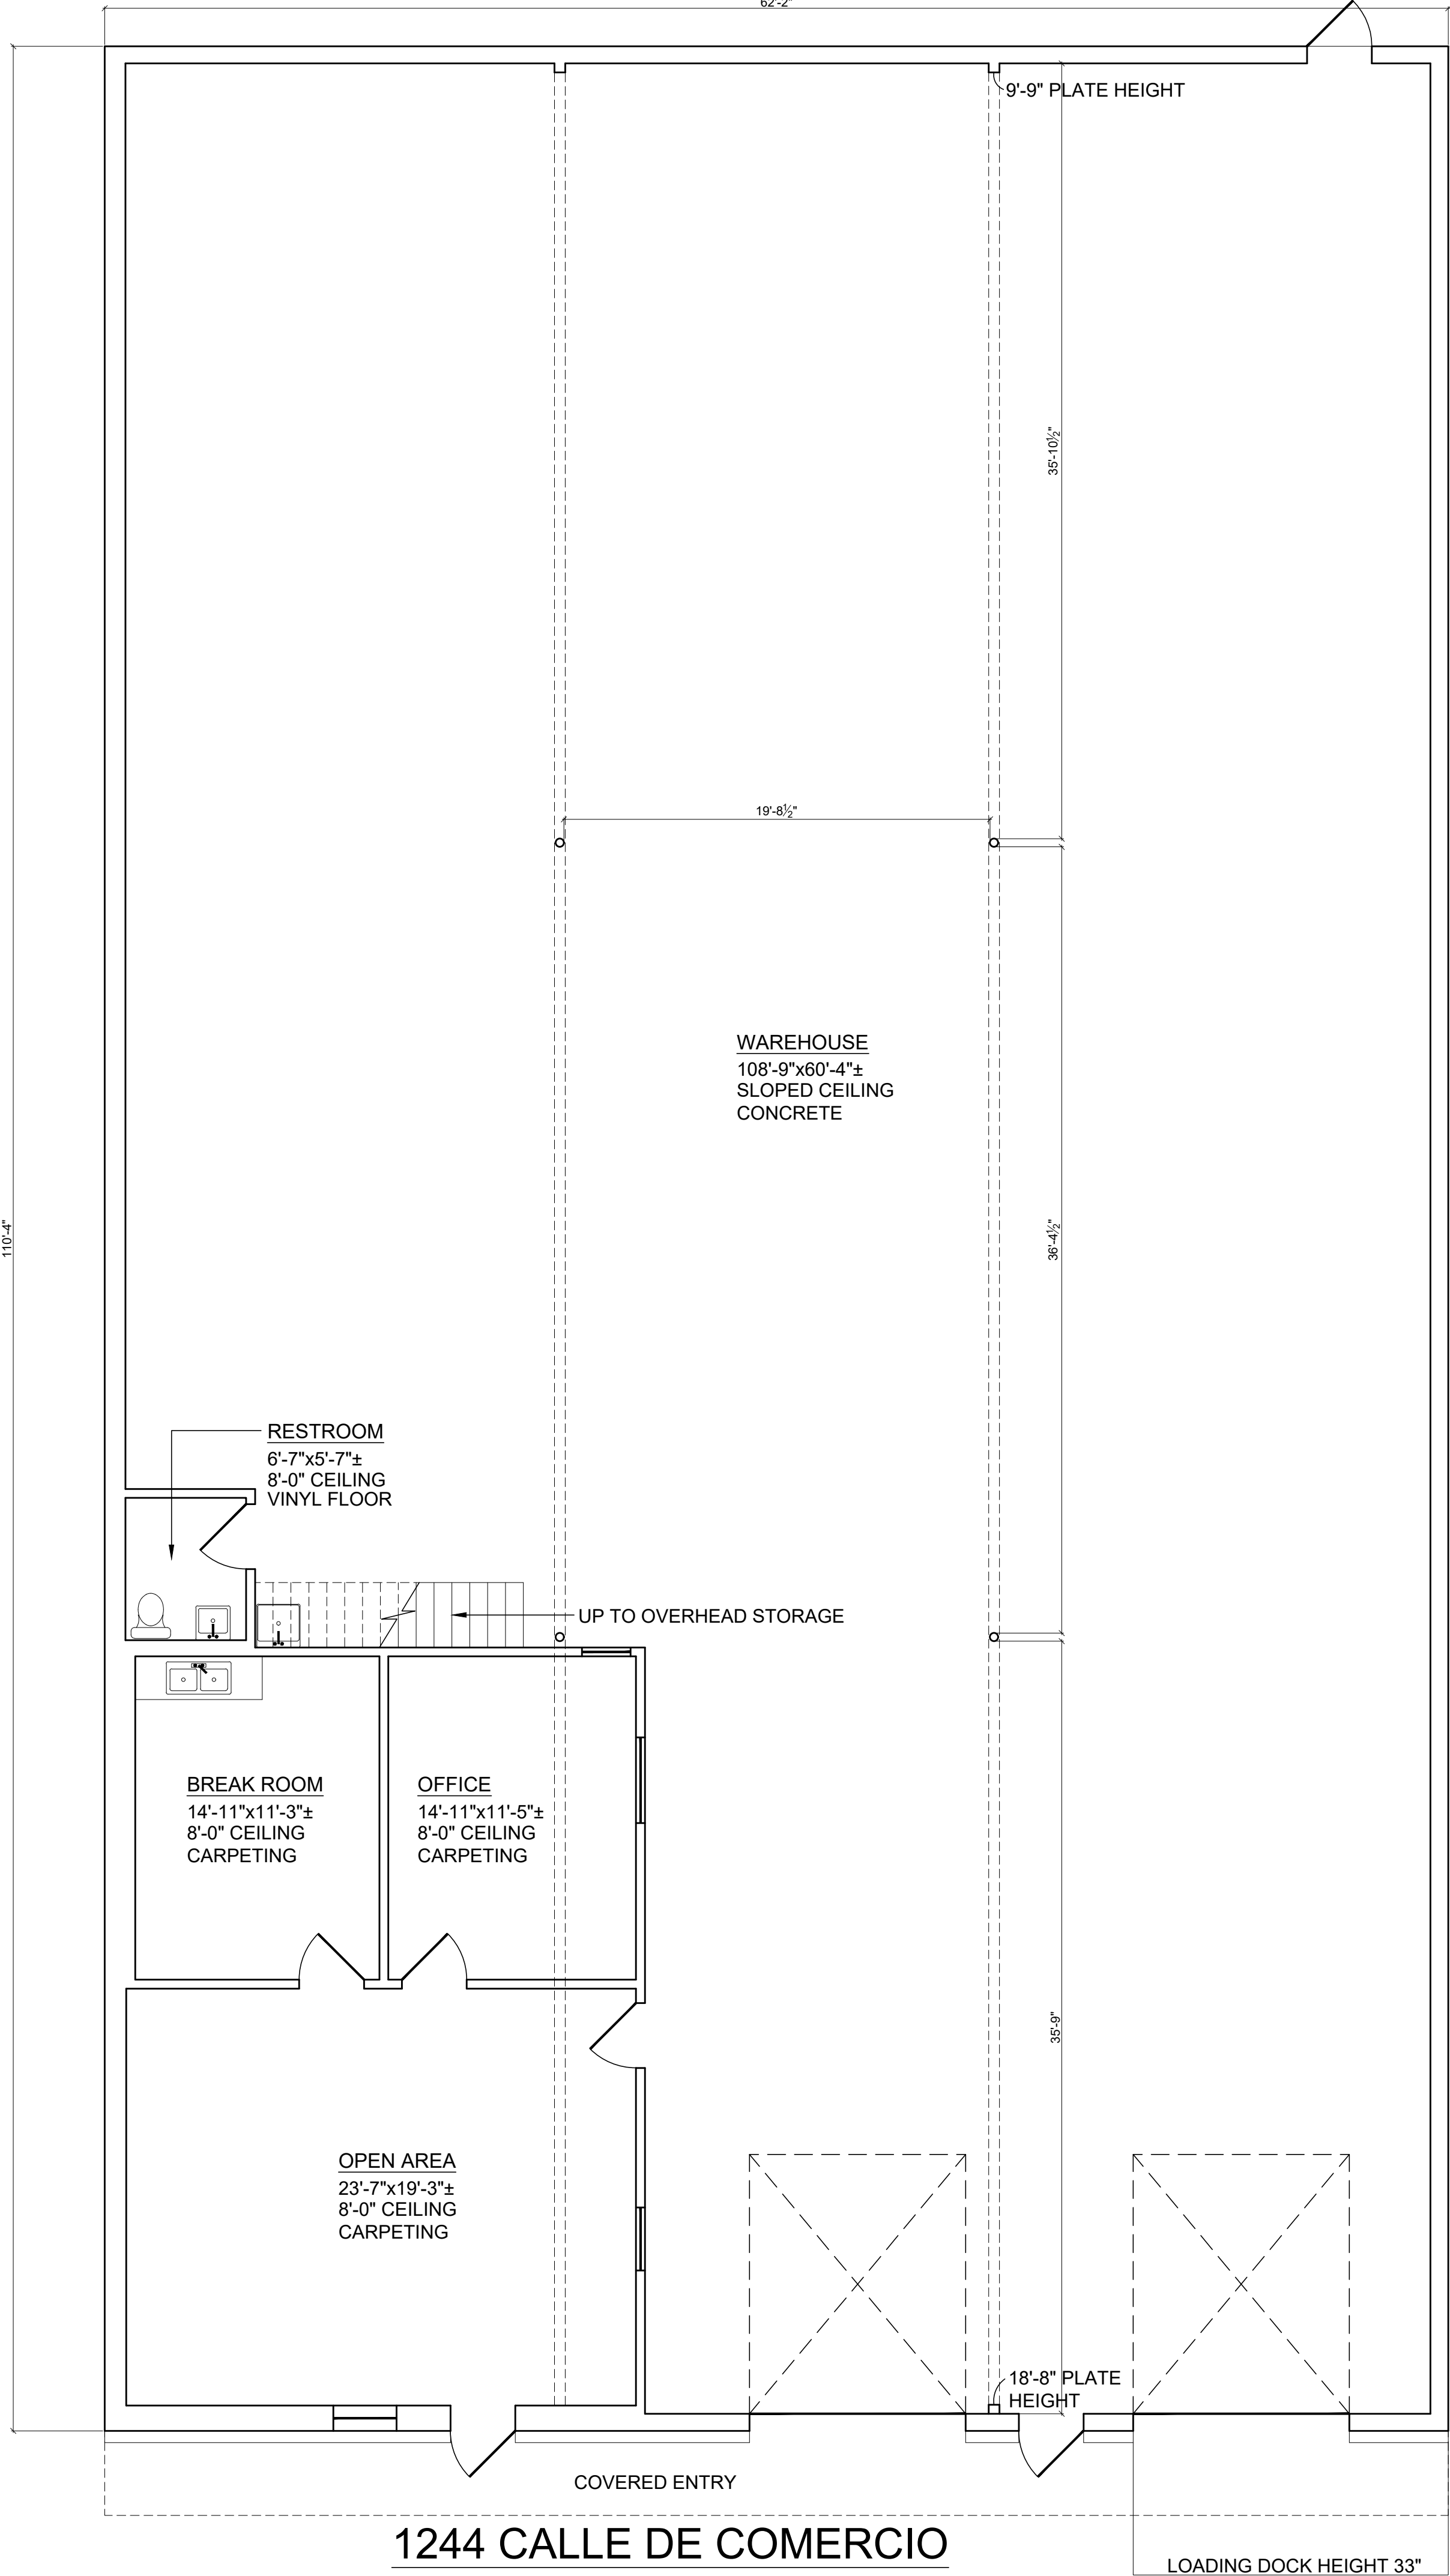

1244 CALLE DE COMERCIO

NOTES

1. ALL CALCULATIONS INDICATE "GROSS" AREA AS PER "BOMA" STANDARDS.
2. THE STAIRS ARE NOT INCLUDED IN THE OVERHEAD STORAGE AREA.
3. ALL FIXTURES INDICATED ARE BUILT-IN.
4. ALL FLOORS ARE AS NOTED.
5. ALL CEILING HEIGHTS AS NOTED.
6. ALL DIMENSIONS TO BE FIELD VERIFIED PRIOR TO ANY CONSTRUCTION.

AREA CALCULATIONS:

OFFICE AREA	906.25 SQ. FT.
WAREHOUSE AREA	5952.80 SQ. FT.
TOTAL MAIN FLOOR AREA	6859.05 SQ. FT.

TOTAL MAIN FLOOR AREA	6859.05 SQ. FT.
UPPER STORAGE AREA	959.41 SQ. FT.
TOTAL BUILDING AREA	7818.46 SQ. FT.

PROJECT:
1244
CALLE DE COMERCIO
SANTA FE
NEW MEXICO

DESCRIPTION:
AS-BUILT
DRAWING

CLIENT:
TERRY
MEURER

SHEET #
01
OF 01

ORIENTATION	MEASURED BY	PM	REFERENCE
	DESIGNED BY	N.A.	2
	DRAFTED BY	PM	5
	CHECKED BY	M.G.	0
	REVISED:		2
SCALE	DATE		#
3/16"=1'-0"	03/24/2025		5

505-899-1199