




[Click to access3D model](#)

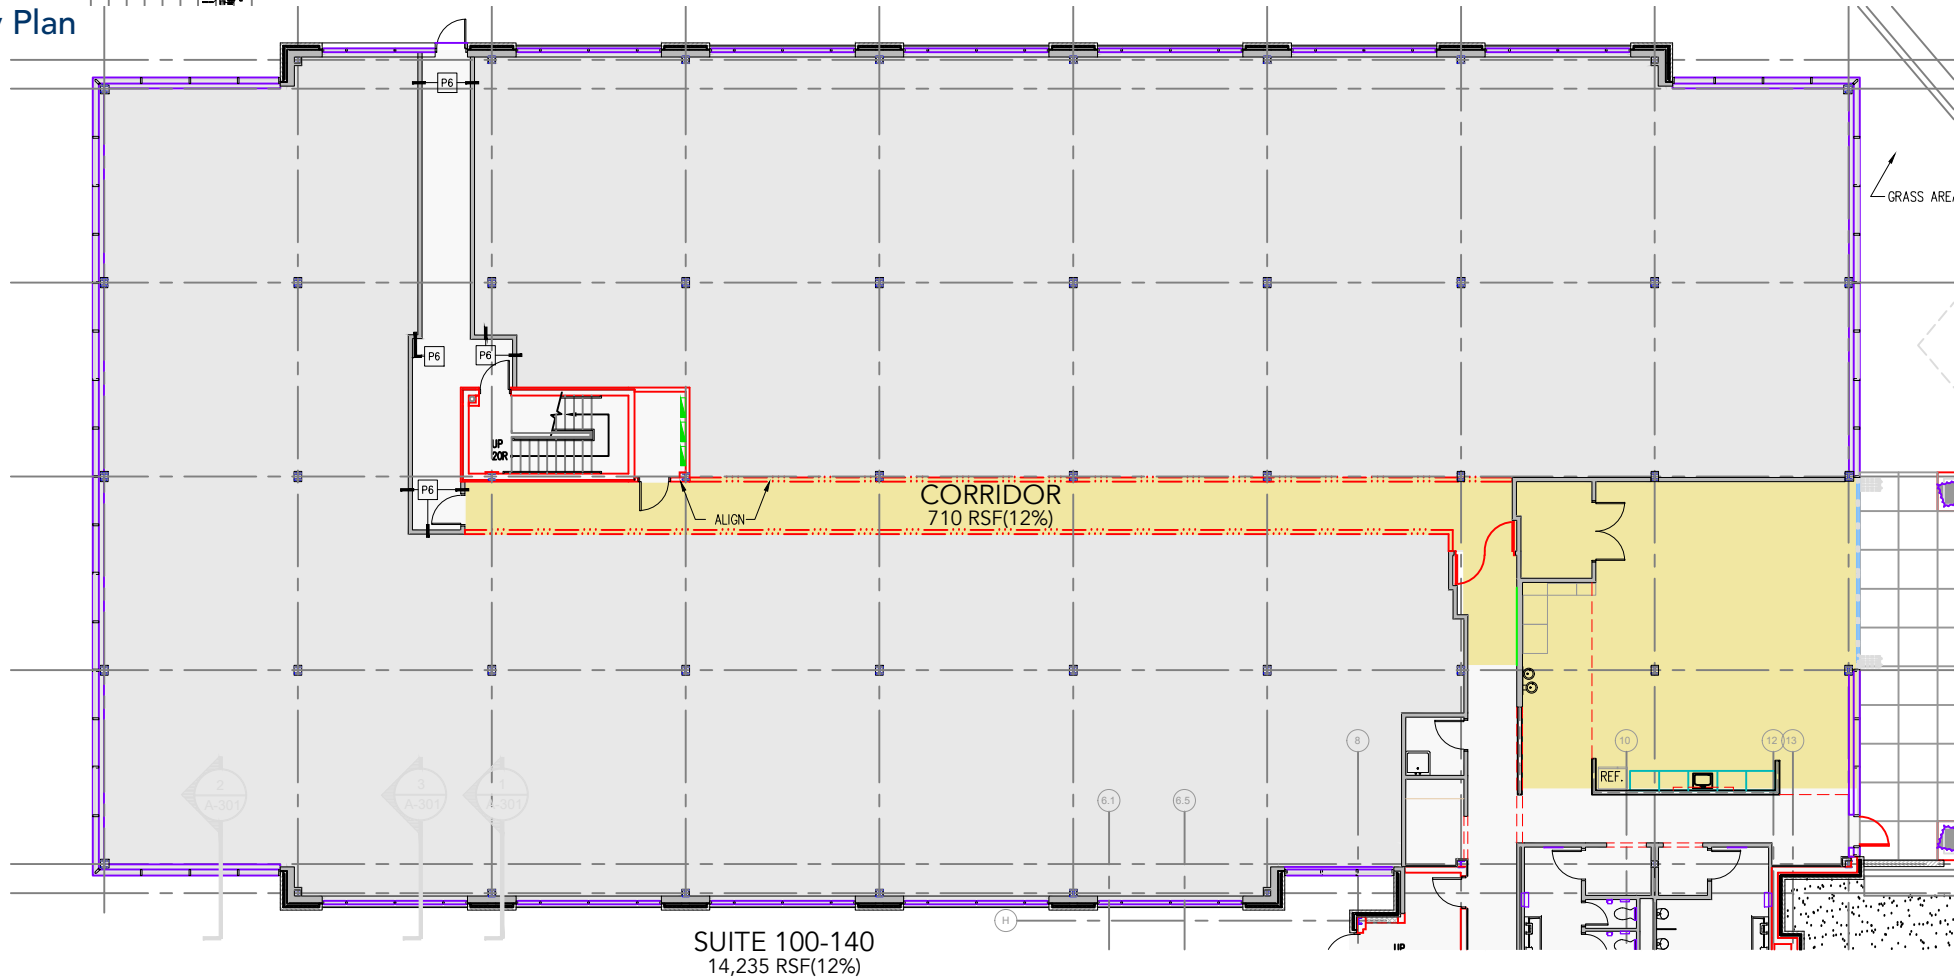

PLAN NOT TO SCALE - THIS IS NOT A CONSTRUCTION DOCUMENT

DRAWING #: SC11-100-140 ASBUILT DATE:NEEDS TO BE