


KEYNOTES:

- A REMOVE DOOR
 B NEW DOOR

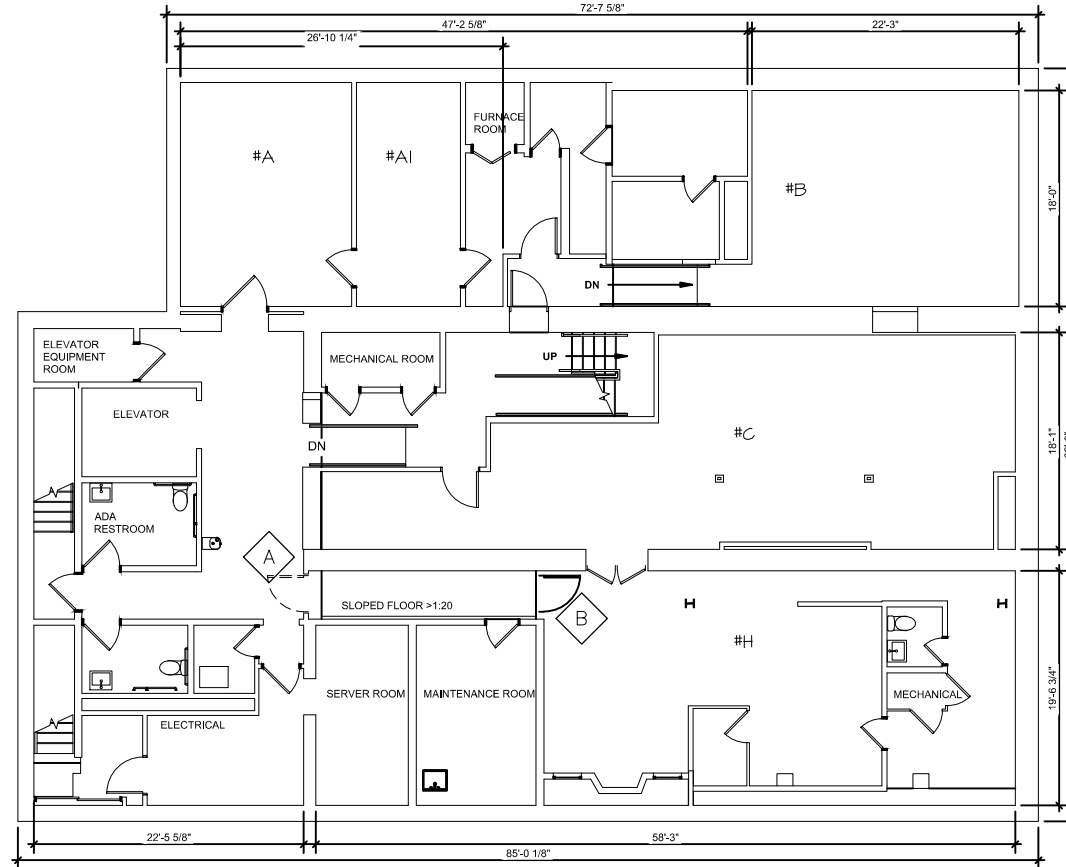

REV	DATE	DESCRIPTION	LINVILL PROPERTIES 3333 CO. RD. 101 S., WAYZATA, MN 55391 MAGGIE LINVILL SMITH (952) 890-5400	PLAN BASEMENT 4388 FRANCE AVENUE SOUTH EDINA, MINNESOTA 55410	BSMT 12/2/22 1/16"=1'-0"
					
Preliminary Drawing NOT TO BE USED FOR CONSTRUCTION			R & C DRAFTING 9448 CREEK RIDGE LANE, SAVAGE, MN. 55378 (612) 965-3999 Bob@RandCDrafting.com		