

New Indianapolis Sublease




9465 Counselors Row | Indianapolis, IN 46240

Space & Building Features

- 3,502 SF
- Suite 120
- Sublease through 12/31/2027
- Immediate occupancy
- Rate is negotiable
- Move-in ready, fully furnished space
- Excellent lake views
- 8 private offices
- Work room
- Conference room
- Break room
- Reception
- Building amenities include: *fitness center, cafe, pickleball courts, sand volleyball and conferencing*

New Indianapolis Sublease

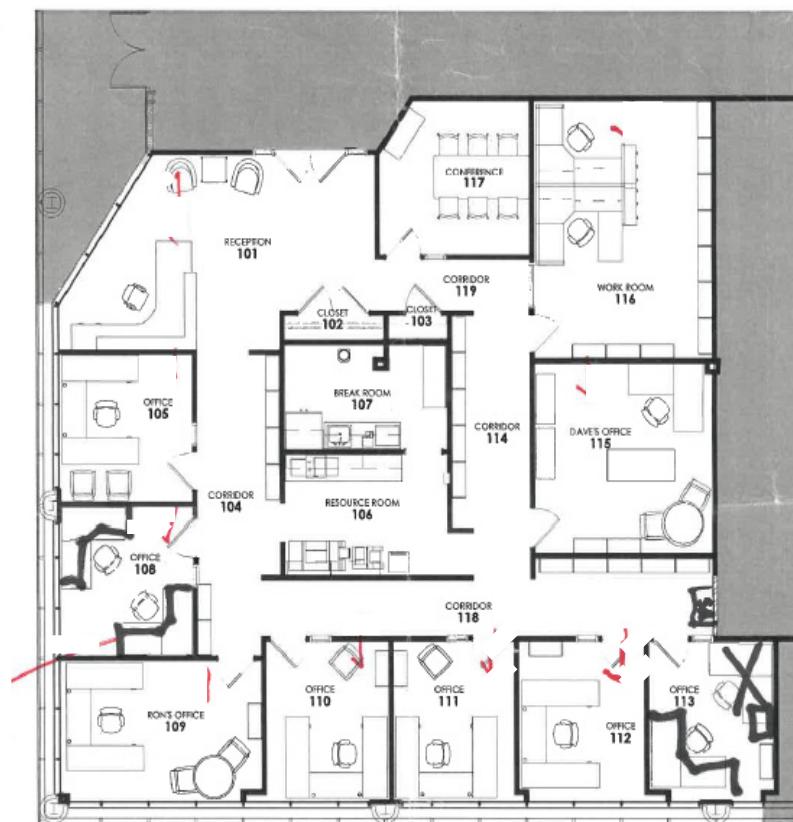

1 FURNITURE PLAN
1/8" = 1'-0"

Contact Information

Phil Mosey, Vice President

317.413.2203 | phil.mosey@colliers.com

Benjamin Cooper, Senior Vice President

312.602.6910 | bcooper@cbiz.com

New Indianapolis Sublease



Contact Information

Phil Mosey, Vice President

317.413.2203 | phil.mosey@colliers.com

Benjamin Cooper, Senior Vice President

312.602.6910 | bcooper@cbiz.com