




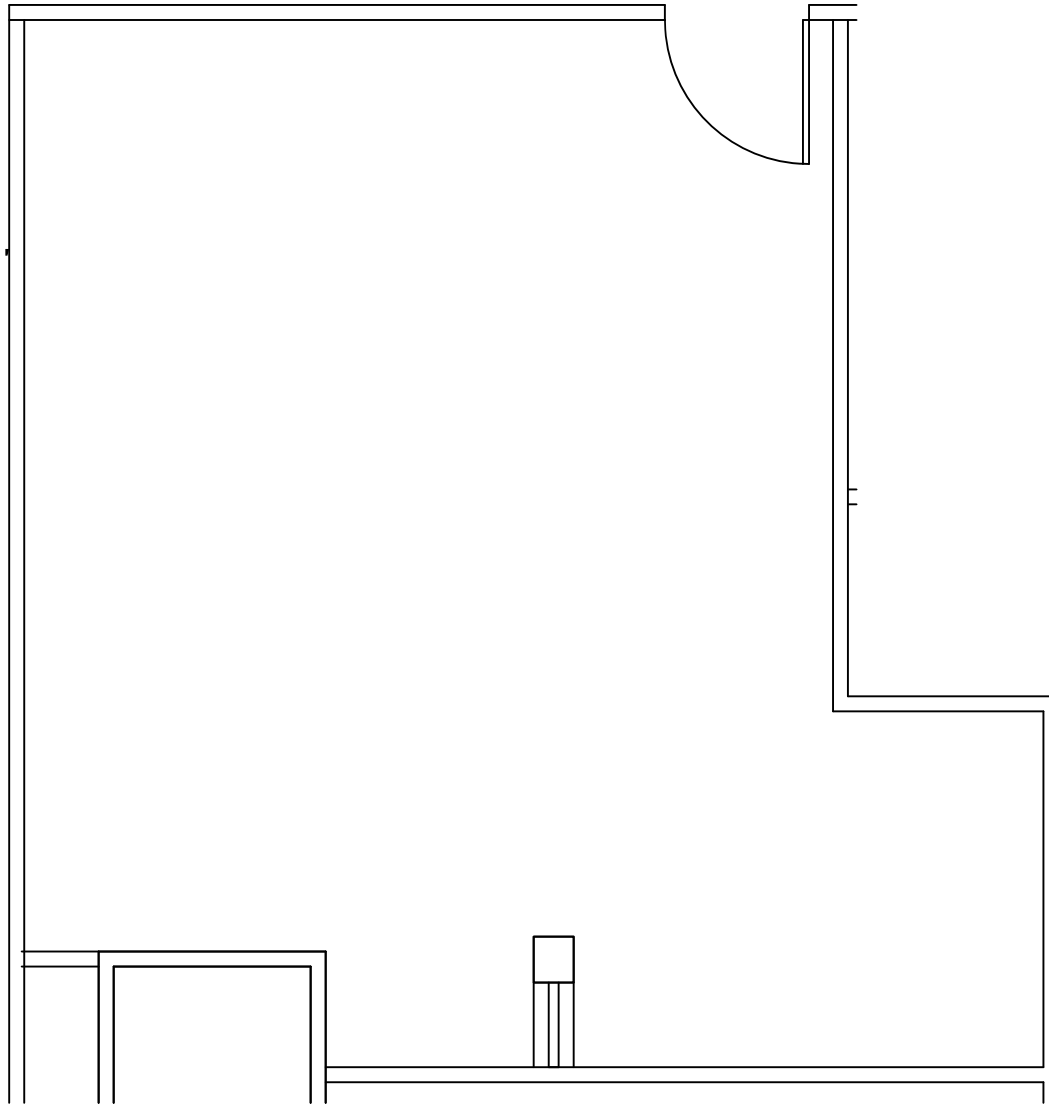

Suite 350
2440
Texas Parkway
Level 03

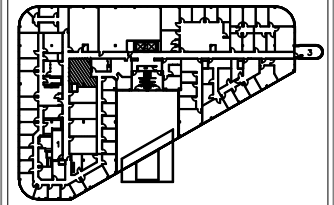

Suite Location:

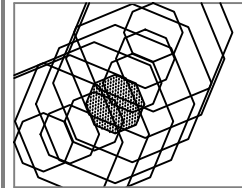

Suite Area:

467 NRSF

Project Number:

2194.CB

Scale:

1/4"=1'-0"

Sheet Number:

AB-350

For Leasing Information Call:
AOEDE 408-520-1625

10.06.21