
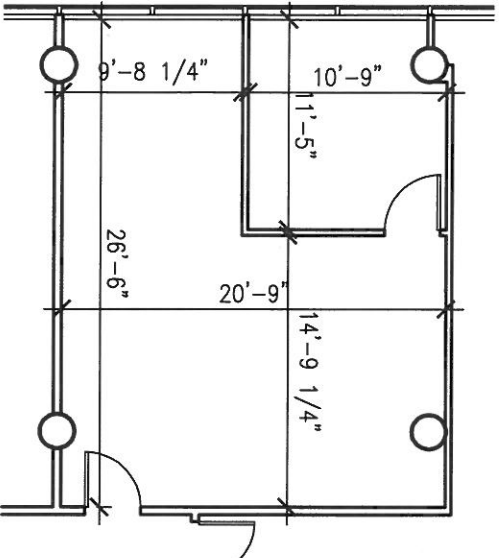


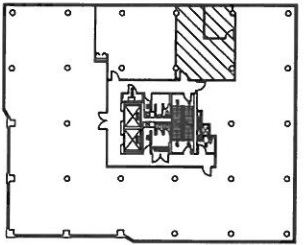

	Property: Belmont House Dartmouth, Nova Scotia		Suite: 350
	Measured in accordance with the BOMA Standard Method for Measuring Floor Area, The Rentable Area was found to be 658 S.F.		
M, E, A, S, U, R, E, M, E, N, T, O, F, Office Industrial Retail Residential <i>[Signature]</i> <u>Ed Massey, President – Measure Made Inc.</u> Scale: N.T.S.			
Measure Date: June, 2015	Plot Date: June 10/15		