



|              |      |
|--------------|------|
| REVISIONS BY | DATE |
|              |      |
|              |      |
|              |      |

DATE: 5/10/05  
BY: [Signature]

**jerry clawson / architect**  
architecture • master planning • interiors  
2501 W. CLEVELAND AVE. SUITE 200  
MIAMI, FL 33135  
TEL: 305.442.4343 FAX: 305.442.4344  
WWW.JERRYCLAWSON.COM

**ARCHITECTURAL SITE PLAN**  
RENOVATIONS TO OFFICE BUILDING  
PROJECT TEAMWORK  
400 WEST BROWARD BLVD.  
PLANTATION, FLORIDA

|           |          |
|-----------|----------|
| DATE      | 5/10/05  |
| BY        | AS-1     |
| SCALE     | 1" = 20' |
| PROJECT   | AS-1     |
| CLIENT    |          |
| ARCHITECT |          |

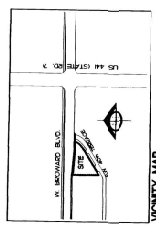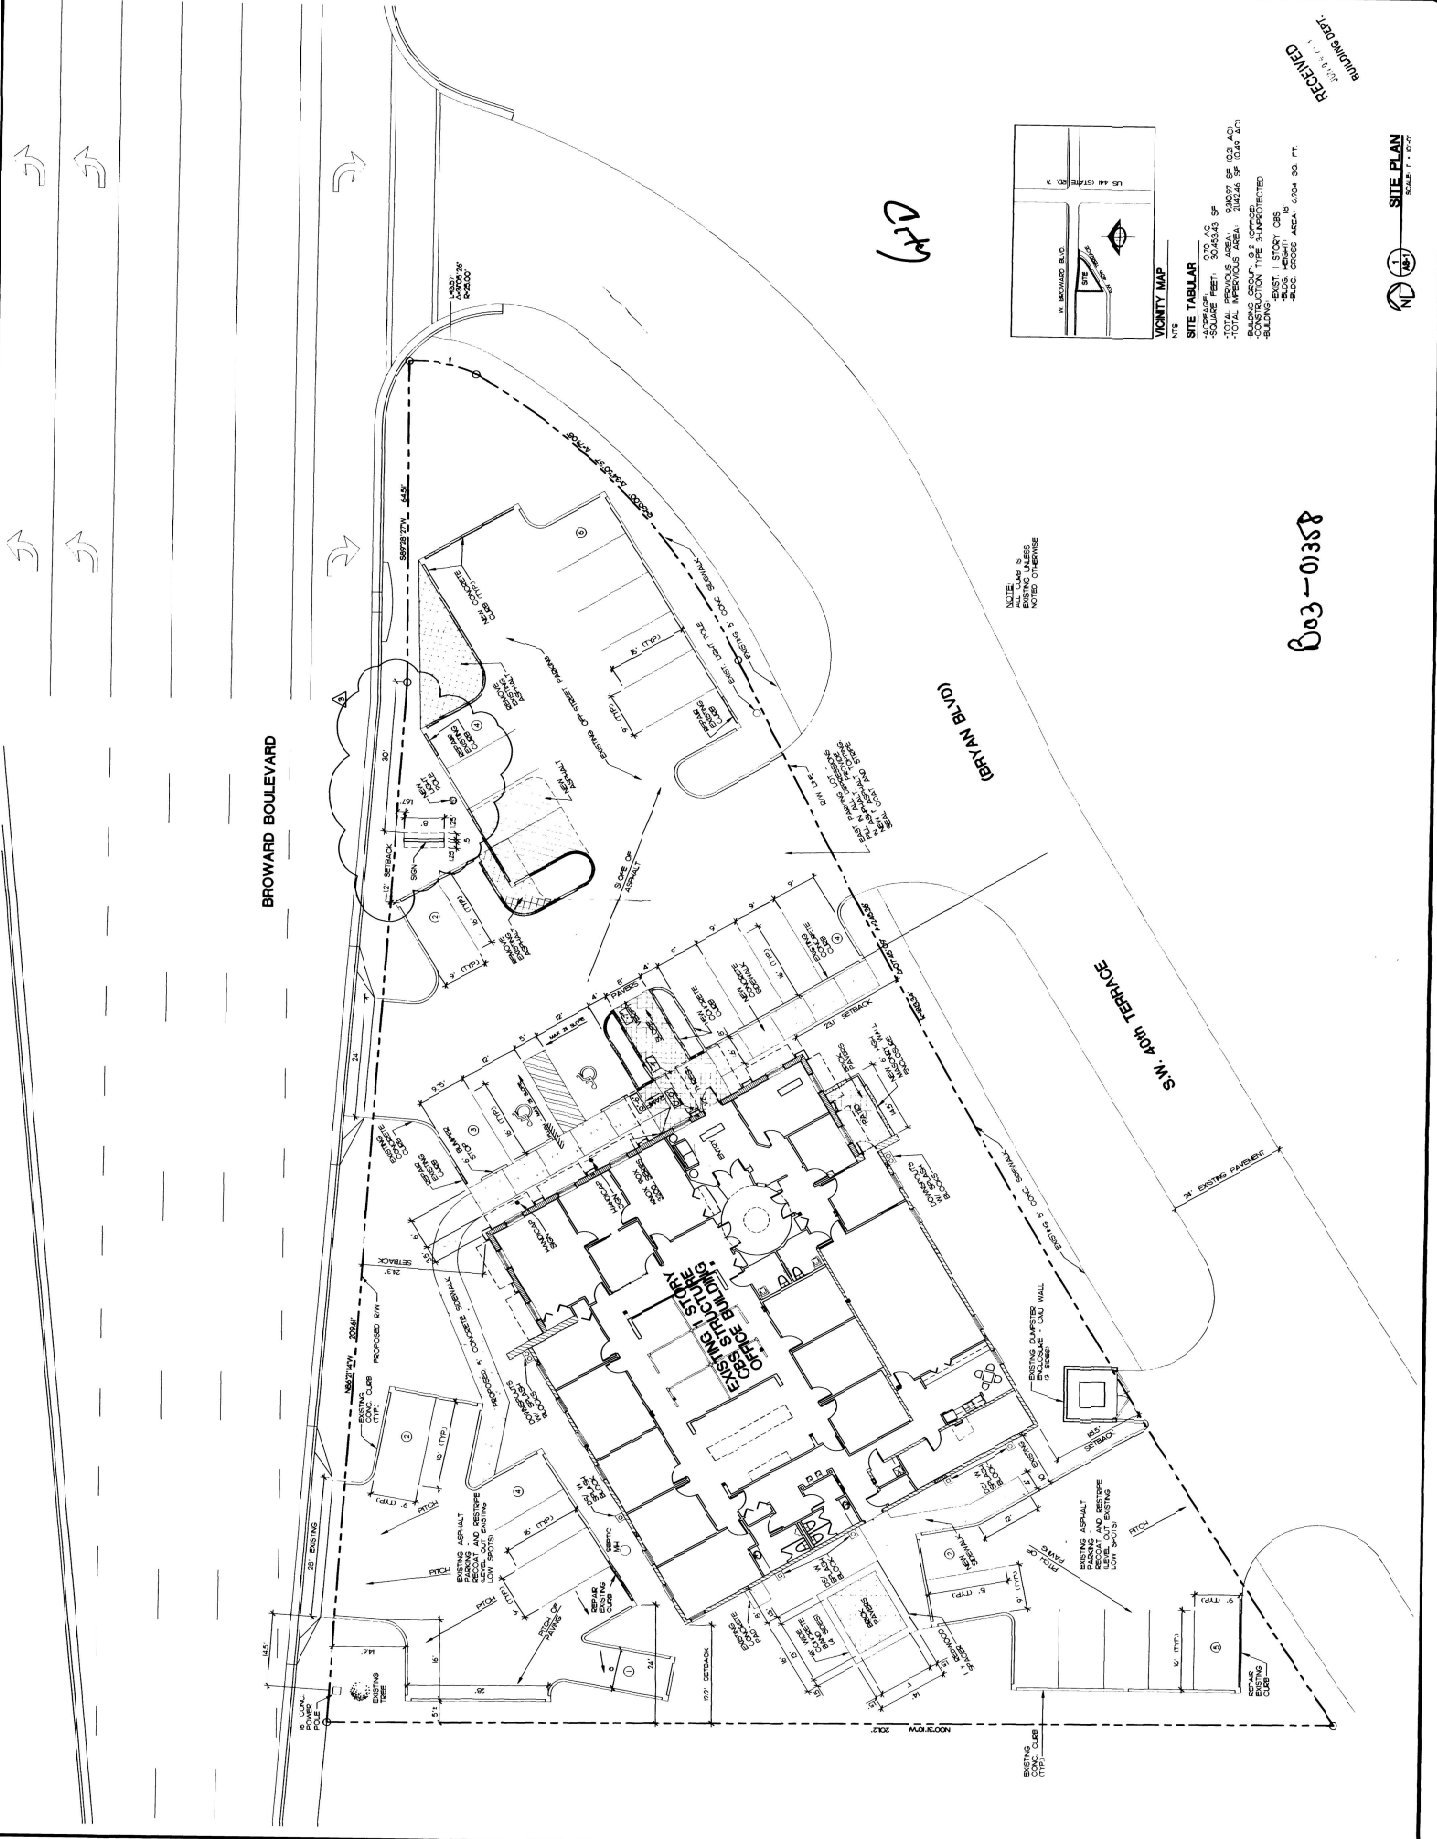

**SITE TABULAR**  

03-01358

**SITE PLAN**  
SCALE: 1" = 20'

RECEIVED  
5/10/05  
BUILDING DEPT.