


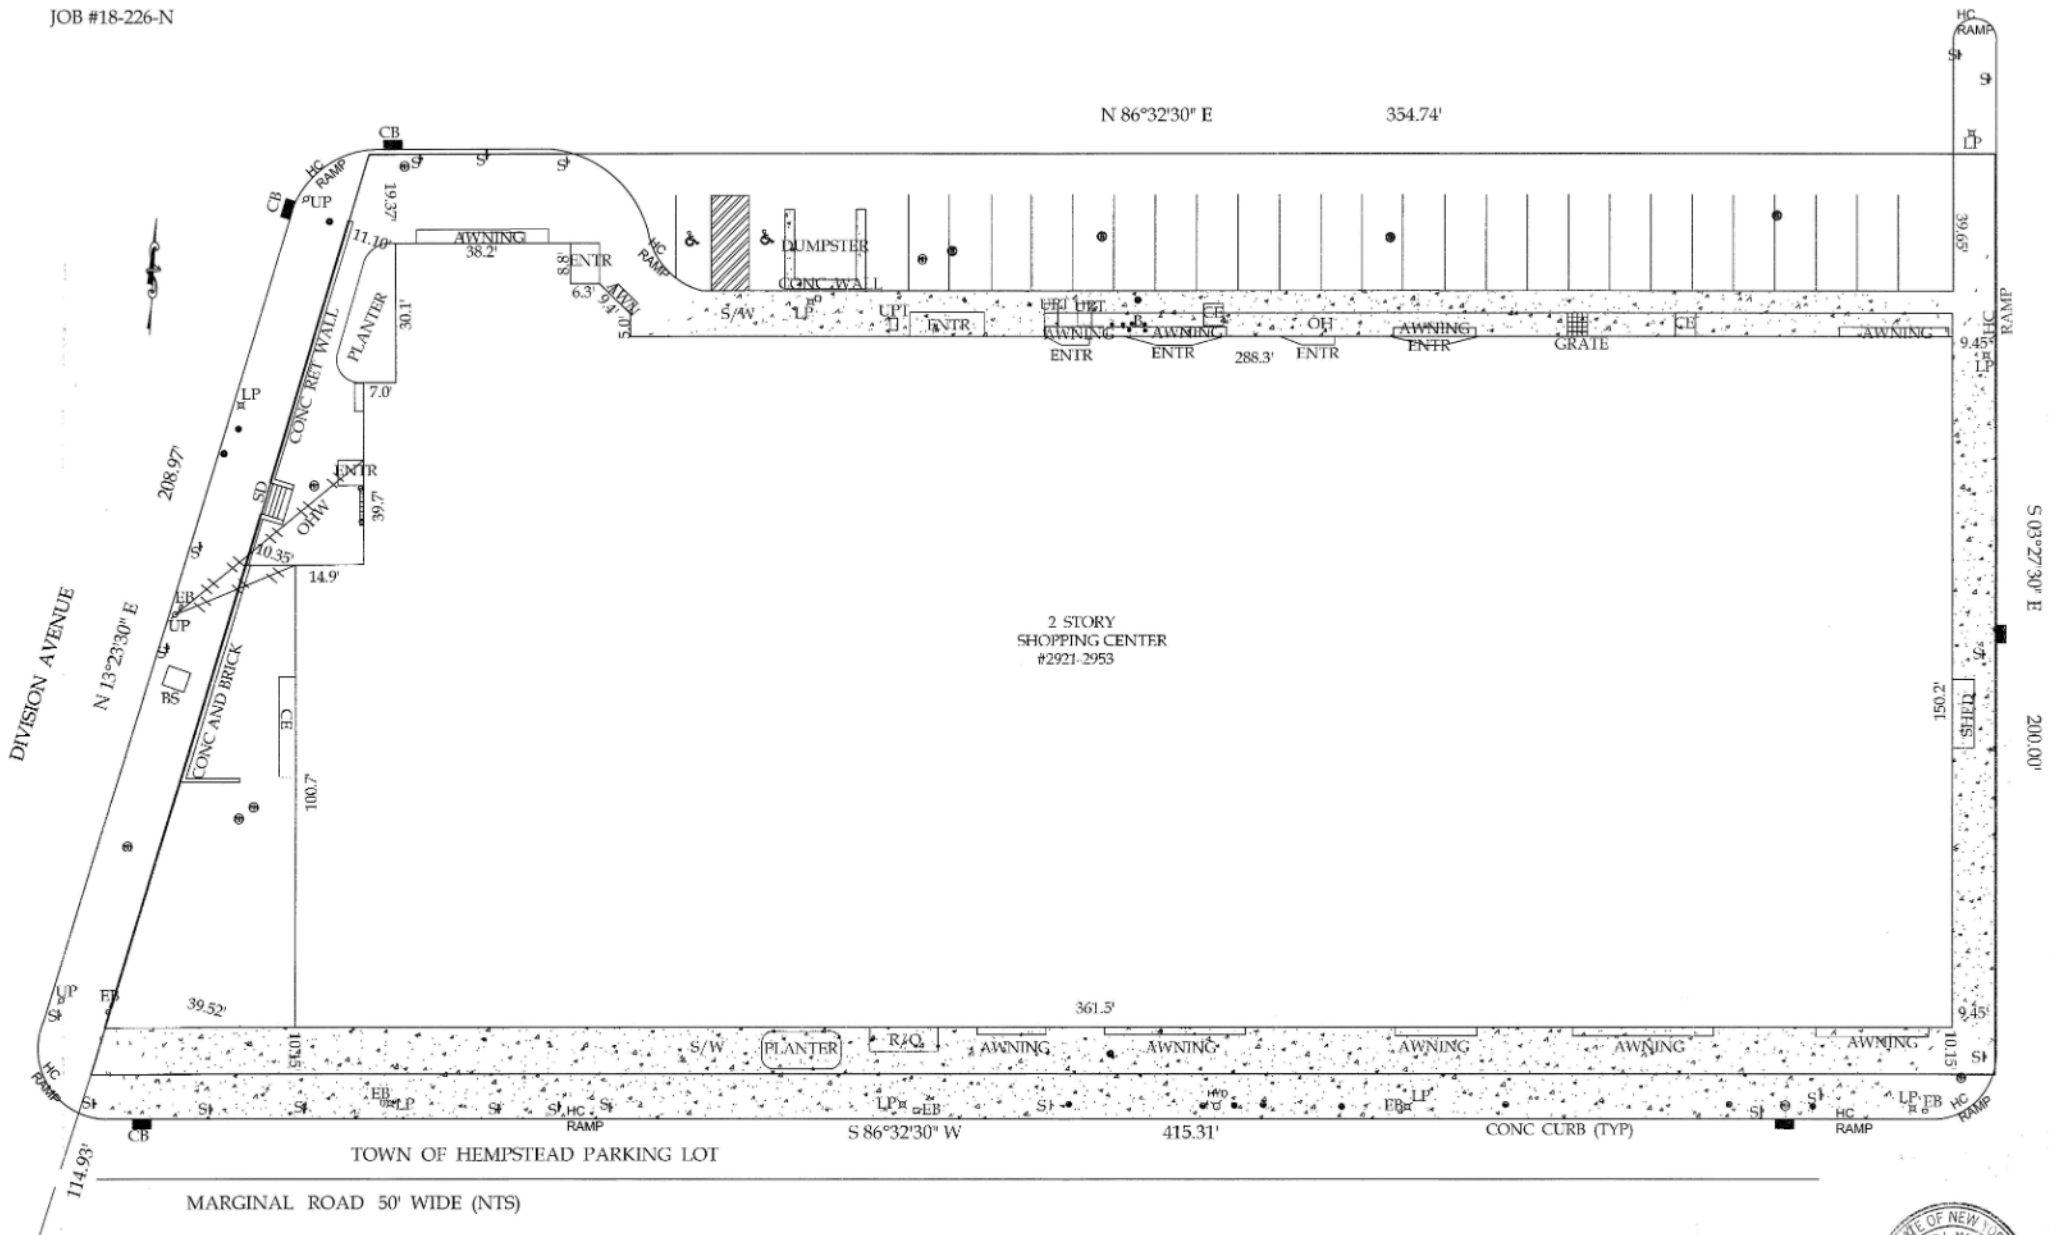

SURVEY OF PROPERTY  
LOCATED AT LEVITTOWN  
TOWN OF HEMPSTEAD  
NASSAU COUNTY, NY  
N.C.T.M. 45-M-24  
CERTIFIED TO:  
ALDRICH MANAGEMENT CO., LLC  
NEW YORK COMMUNITY BANK ISAGA, ATIMA  
FIDELITY NATIONAL TITLE INS. CO.  
ISLAND ABSTRACT INC.  
#1A06365N18CR

UNAUTHORIZED ALTERATION OR ADDITION  
TO THIS SURVEY IS A VIOLATION OF  
SECTION 7009 OF THE NEW YORK STATE  
EVIDENCE LAW  
COPIES OF THIS SURVEY MAP NOT BEARING  
THE LAND SURVEYOR'S SEAL OR  
ENDORSED SEAL SHALL NOT BE CONSIDERED  
TO BE VALID THIS COPY  
GUARANTEES INDICATED HEREON SHALL RUN  
ONLY TO THE PERSON FOR WHOM THE SURVEY  
IS PREPARED, AND IN NO EVENT TO THE  
CLIENT COMPANY, GOVERNMENTAL AGENCY AND  
LENDING INSTITUTION LISTED HEREON, AND  
THE ASSIGNEES OF THE LENDING INSTITUTION.  
GUARANTEES ARE NOT TRANSFERABLE  
TO ANY OTHER INSTITUTION OR SUBSEQUENT  
OWNER

ALL STRUCTURES, EASEMENTS,  
OR UNDERGROUND UTILITIES  
NOT SHOWN ARE NOT GUARANTEED  
THE EFFECTS OF REMEDIATION SHALL  
BE DETERMINED BY THE STRUCTURES TO  
BE REMEDIATED AND FOR A SPECIFIED  
PERIOD AND USED AND THEREAFTER AND  
NOT INTENDED TO AFFECT THE CREDIBILITY  
OF FENCED, RETAINING WALLS, POLES,  
PITCHES, PLANTING AREAS, ADDITIONS TO ANY  
BUILDINGS OR ANY OTHER CONSTRUCTION

- ⊕ = HANDICAP PARKING
- ⊙ = MANHOLE
- ⊙ = SANITARY MANHOLE
- ⊙ = GAS VALVE
- ⊙ = WATER VALVE
- UPT = UTILITY PIT
- LP = LIGHT POLE
- EB = ELECTRIC BOX
- St = SIGN
- Hyd = HYDRANT
- BS = BUS STOP
- OHW = OVERHEAD WIRTES
- B = BOLLARD
- CB = CATCH BASIN



PREPARED BY  
**DONALD L. MALM, JR**  
LAND SURVEYOR  
61 NASSAU AVE  
ISLIP, NY 11751  
631-581-0003  
SCALE: 1" = 30'  
DATE: JULY 12, 2018