


Common Corridor

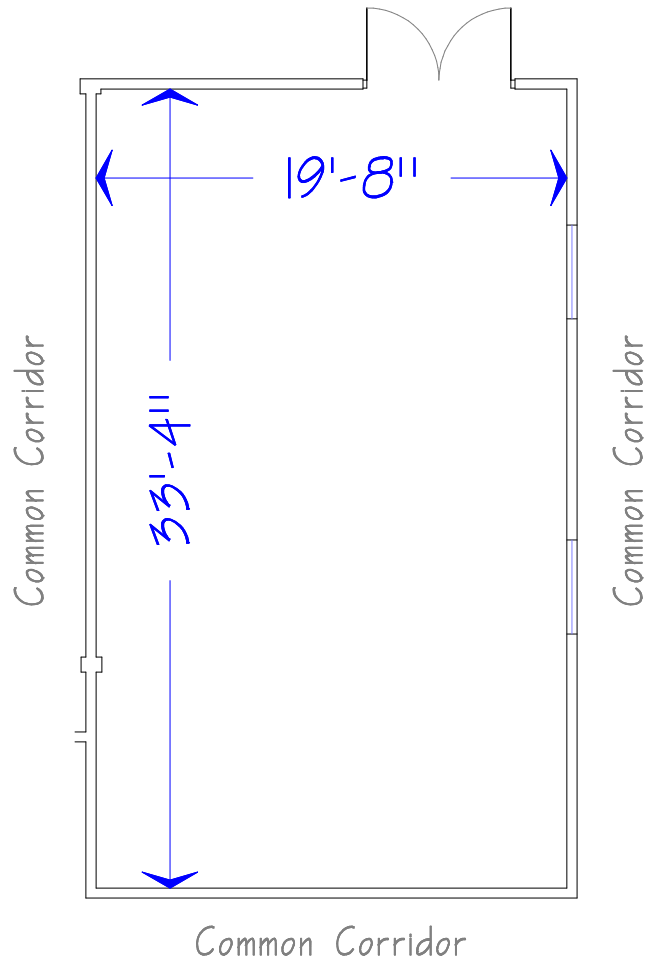

Unit 210
2770 Dufferin Street
Toronto, Ontario

as measured April 22, 2024

