


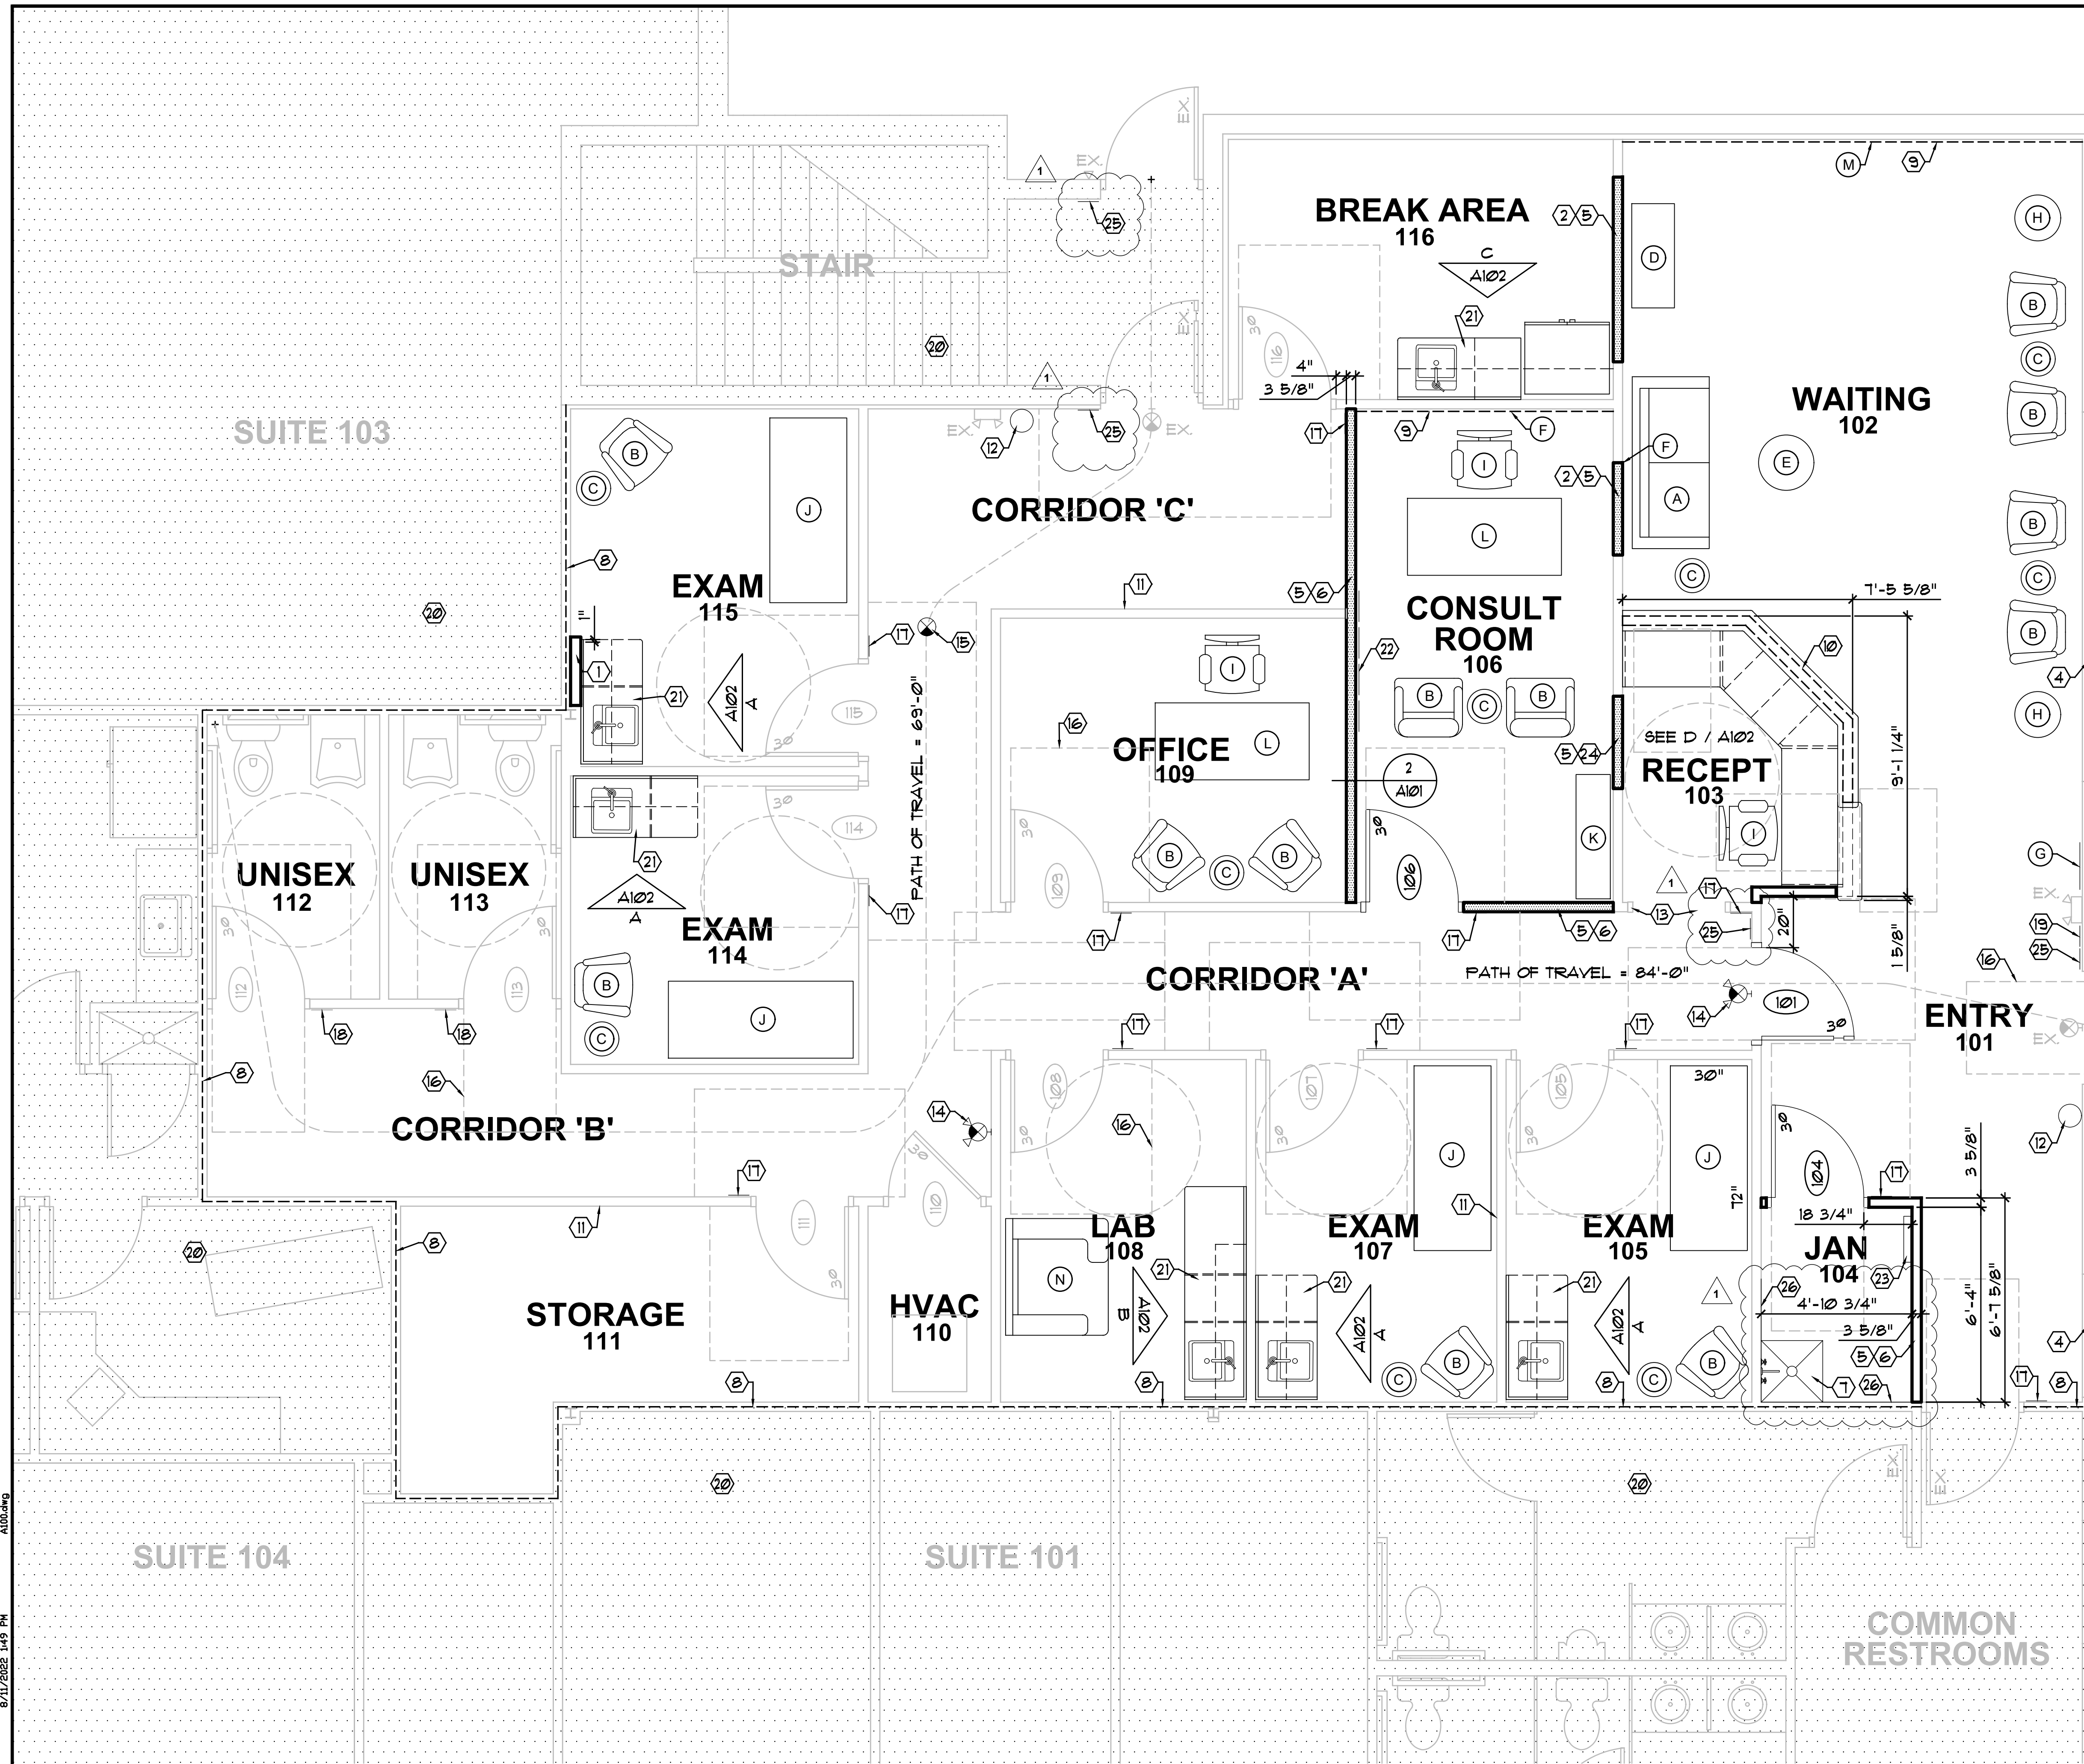

24. INFILL EXISTING WALL WHERE RECEPTION WINDOW WAS REMOVED W/ 3/8" METAL STUDS W/ 5/8" G.W.B. - PAINTED.
25. ADA / IAC COMPLIANT TACTILE EXIT SIGNAGE - SEE DETAIL 5/A101.
26. INSTALL REINFORCED FIBERGLASS PANEL W/ EDGE TRIM BEHIND AND FOR A DISTANCE OF 24" FROM NORTH EDGE OF MOP BASIN AND ENTIRE SOUTH WALL W/ A HEIGHT OF 48" A.F.F.
27. IDENTITY OF BUILDING SUITE: WHITE CONTRASTING LETTERS, A MINIMUM OF 4" HIGH WITH A 1/2" MINIMUM STROKE SHALL BE INSTALLED ON THE CENTER UPPER PORTION OF THE DOOR FACE. THE LETTERS WILL BE VISIBLE FROM THE STREET.

FURNISHINGS	
A	SOFA
B	CLIENT CHAIR
C	SIDE TABLE
D	REFRESHMENT TABLE
E	COFFEE TABLE
F	ARTWORK
G	MIRROR
H	ARTIFICIAL PLANT
I	CONFERENCE CHAIR
J	EXAM TABLE
K	BOOKSHELF
L	PROVIDER DESK
M	QC KINETIX LOGO
N	PHLEBOTOMY CHAIR



**Suite 102
410 East University Avenue
Champaign, Illinois**

JOB NO. 82206	DATE JULY 21, 2022
SCALE 3/8" = 1'-0"	REV AUGUST 12, 2022
DRAWN BY TAW	
CHECKED BY TAW	

A100

