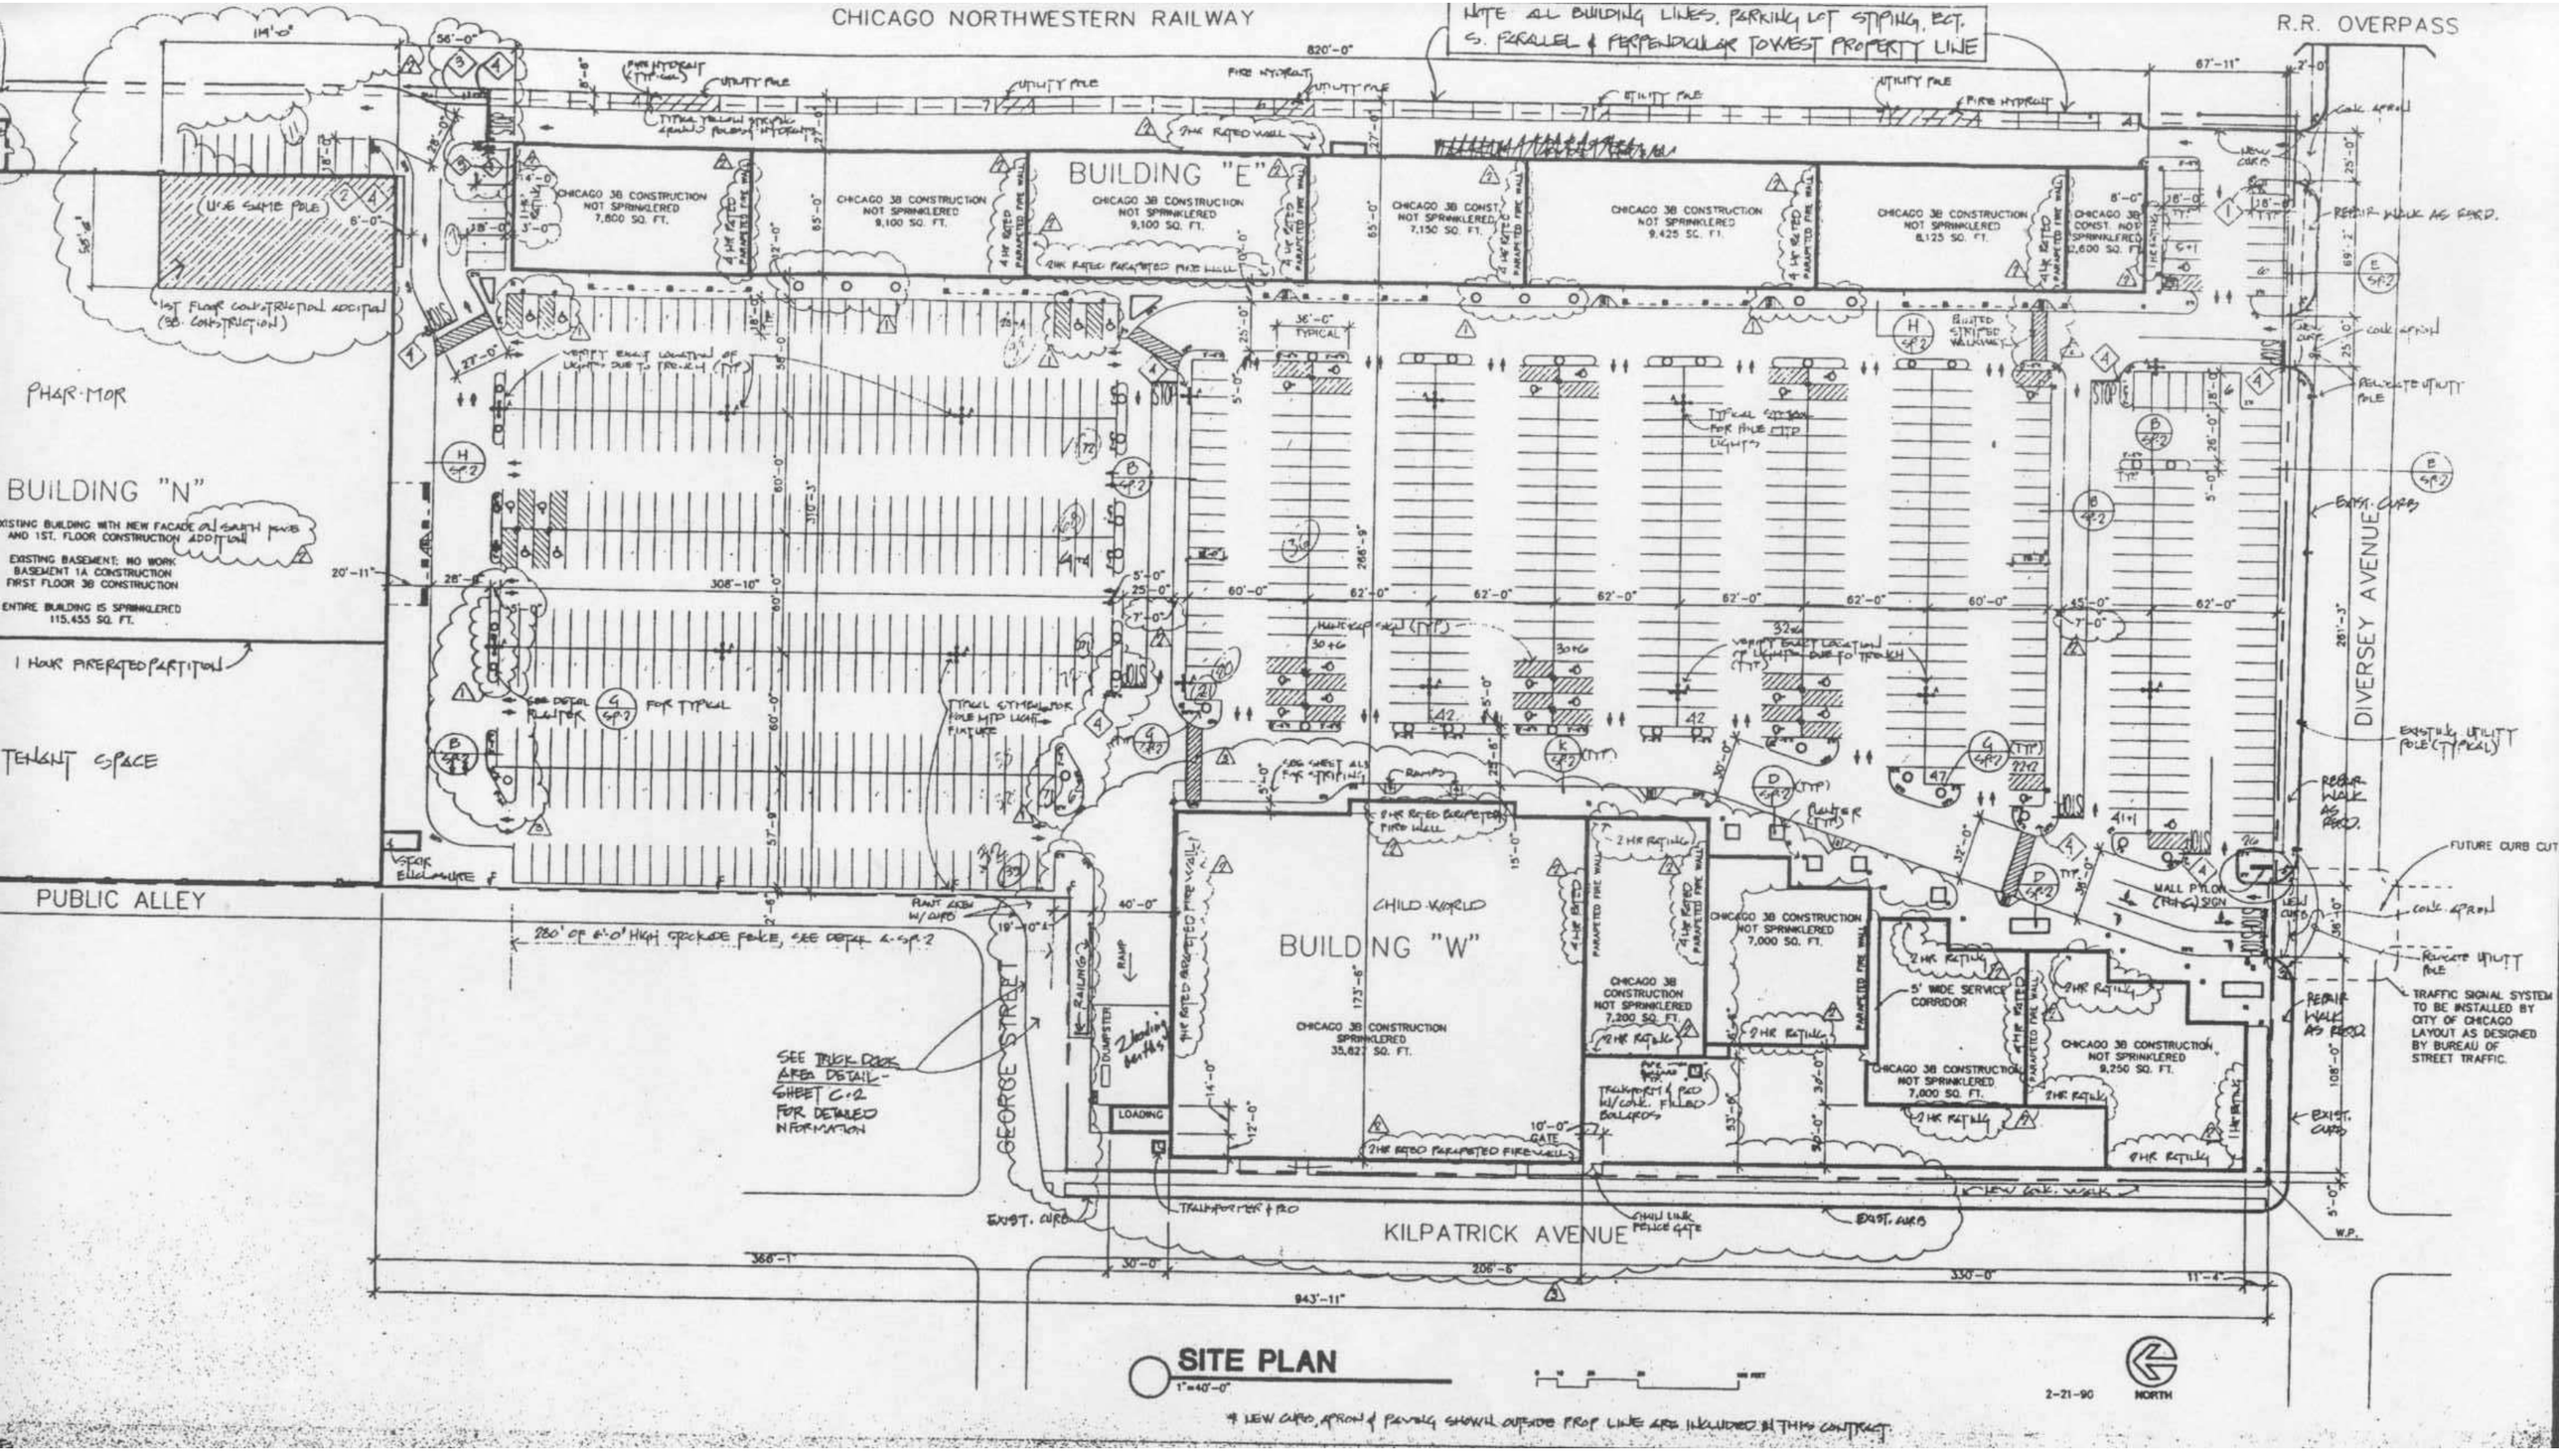

CHICAGO NORTHWESTERN RAILWAY
NOTE: ALL BUILDING LINES, PARKING LOT STRIPING, ECT. S. PERALLEL & PERPENDICULAR TOWEST PROPERTY LINE
R.R. OVERPASS
BUILDING "E"
CHICAGO 3B CONSTRUCTION NOT SPRINKLERED 7,800 SQ. FT.
CHICAGO 3B CONSTRUCTION NOT SPRINKLERED 9,100 SQ. FT.
CHICAGO 3B CONSTRUCTION NOT SPRINKLERED 9,100 SQ. FT.
CHICAGO 3B CONST NOT SPRINKLERED 7,150 SQ. FT.
CHICAGO 3B CONSTRUCTION NOT SPRINKLERED 9,425 SQ. FT.
CHICAGO 3B CONSTRUCTION NOT SPRINKLERED 8,125 SQ. FT.
CHICAGO 3B CONST. NOT SPRINKLERED 2,600 SQ. FT.
1ST FLOOR CONSTRUCTIONAL ADDITION (3B CONSTRUCTION)
PHAR-MOR
BUILDING "N"
EXISTING BUILDING WITH NEW FACADE AND 1ST. FLOOR CONSTRUCTION ADDITION
EXISTING BASEMENT: NO WORK
BASEMENT 1A CONSTRUCTION
FIRST FLOOR 3B CONSTRUCTION
ENTIRE BUILDING IS SPRINKLERED
115,455 SQ. FT.
1 HOUR FIRERATED PARTITION
TENANT SPACE
PUBLIC ALLEY
DIVERSEY AVENUE
EXIST. CURB
REPAIR WALK AS REQ'D.
REMOVE UTILITY POLE
EXISTING UTILITY POLE (TYPICAL)
FUTURE CURB CUT
CONC. APRON
TRAFFIC SIGNAL SYSTEM TO BE INSTALLED BY CITY OF CHICAGO LAYOUT AS DESIGNED BY BUREAU OF STREET TRAFFIC.
MALL PYLON (TYP.) SIGN
CHILD WORLD
BUILDING "W"
CHICAGO 3B CONSTRUCTION SPRINKLERED 35,627 SQ. FT.
CHICAGO 3B CONSTRUCTION NOT SPRINKLERED 7,000 SQ. FT.
CHICAGO 3B CONSTRUCTION NOT SPRINKLERED 7,200 SQ. FT.
CHICAGO 3B CONSTRUCTION NOT SPRINKLERED 7,000 SQ. FT.
CHICAGO 3B CONSTRUCTION NOT SPRINKLERED 9,250 SQ. FT.
5' WIDE SERVICE CORRIDOR
2 HR RATING
GEORGE STREET
KILPATRICK AVENUE
SEE TRUCK DOCK AREA DETAIL - SHEET C-2 FOR DETAILED INFORMATION
LOADING
DUMPSTER
RAMP
280' OF 6'-0" HIGH CRICKADE FENCE, SEE DETAIL 4 - SH. 2
10'-0" GATE
CHAIN LINK FENCE GATE
TRAFFIC METER & PED
EXIST. CURB
NEW CONC. WALK
W.P.
943'-11"
330'-0"
206'-6"
30'-0"
368'-1"
SITE PLAN
1"=40'-0"
NORTH
2-21-90
* NEW CURB, APRON & PAVING SHOWN OUTSIDE PROP LINE ARE INCLUDED IN THIS CONTRACT.