


Cannabis Distric Processing Lab

6909 West Hefner Road Suite B-9
Oklahoma City Oklahoma

Scope of Work: No Construction Improvements; Change of Use

Elliott
Architects Inc.
900 N.W. 6th Street
Oklahoma City, Oklahoma 73106
Phone: (405) 272-0800
Fax: (405) 272-0802
Email: create@elliottarchitects.com

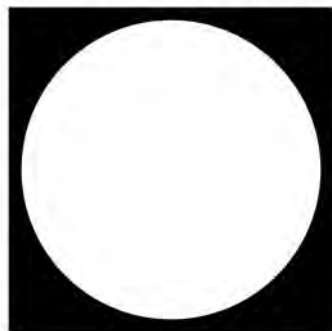



PHONE:	
ADDRESS:	
CONSULTANT:	
DISCIPLINE:	
GEO TECH	
STRUCTURAL	
MECHANICAL	
ELECTRICAL	
PLUMBING	

Cannabis District LLC
6909 West Hefner Road Ste. B-9
Oklahoma City, Oklahoma 73162

PROJECT: 22124	
DATE: 05/06/2021	
REVISIONS #/DATE	
# DATE # DATE	
1 7/20/2022 6	
2 7	
3 8	
4 9	
5 10	

SHEET:

A0.0

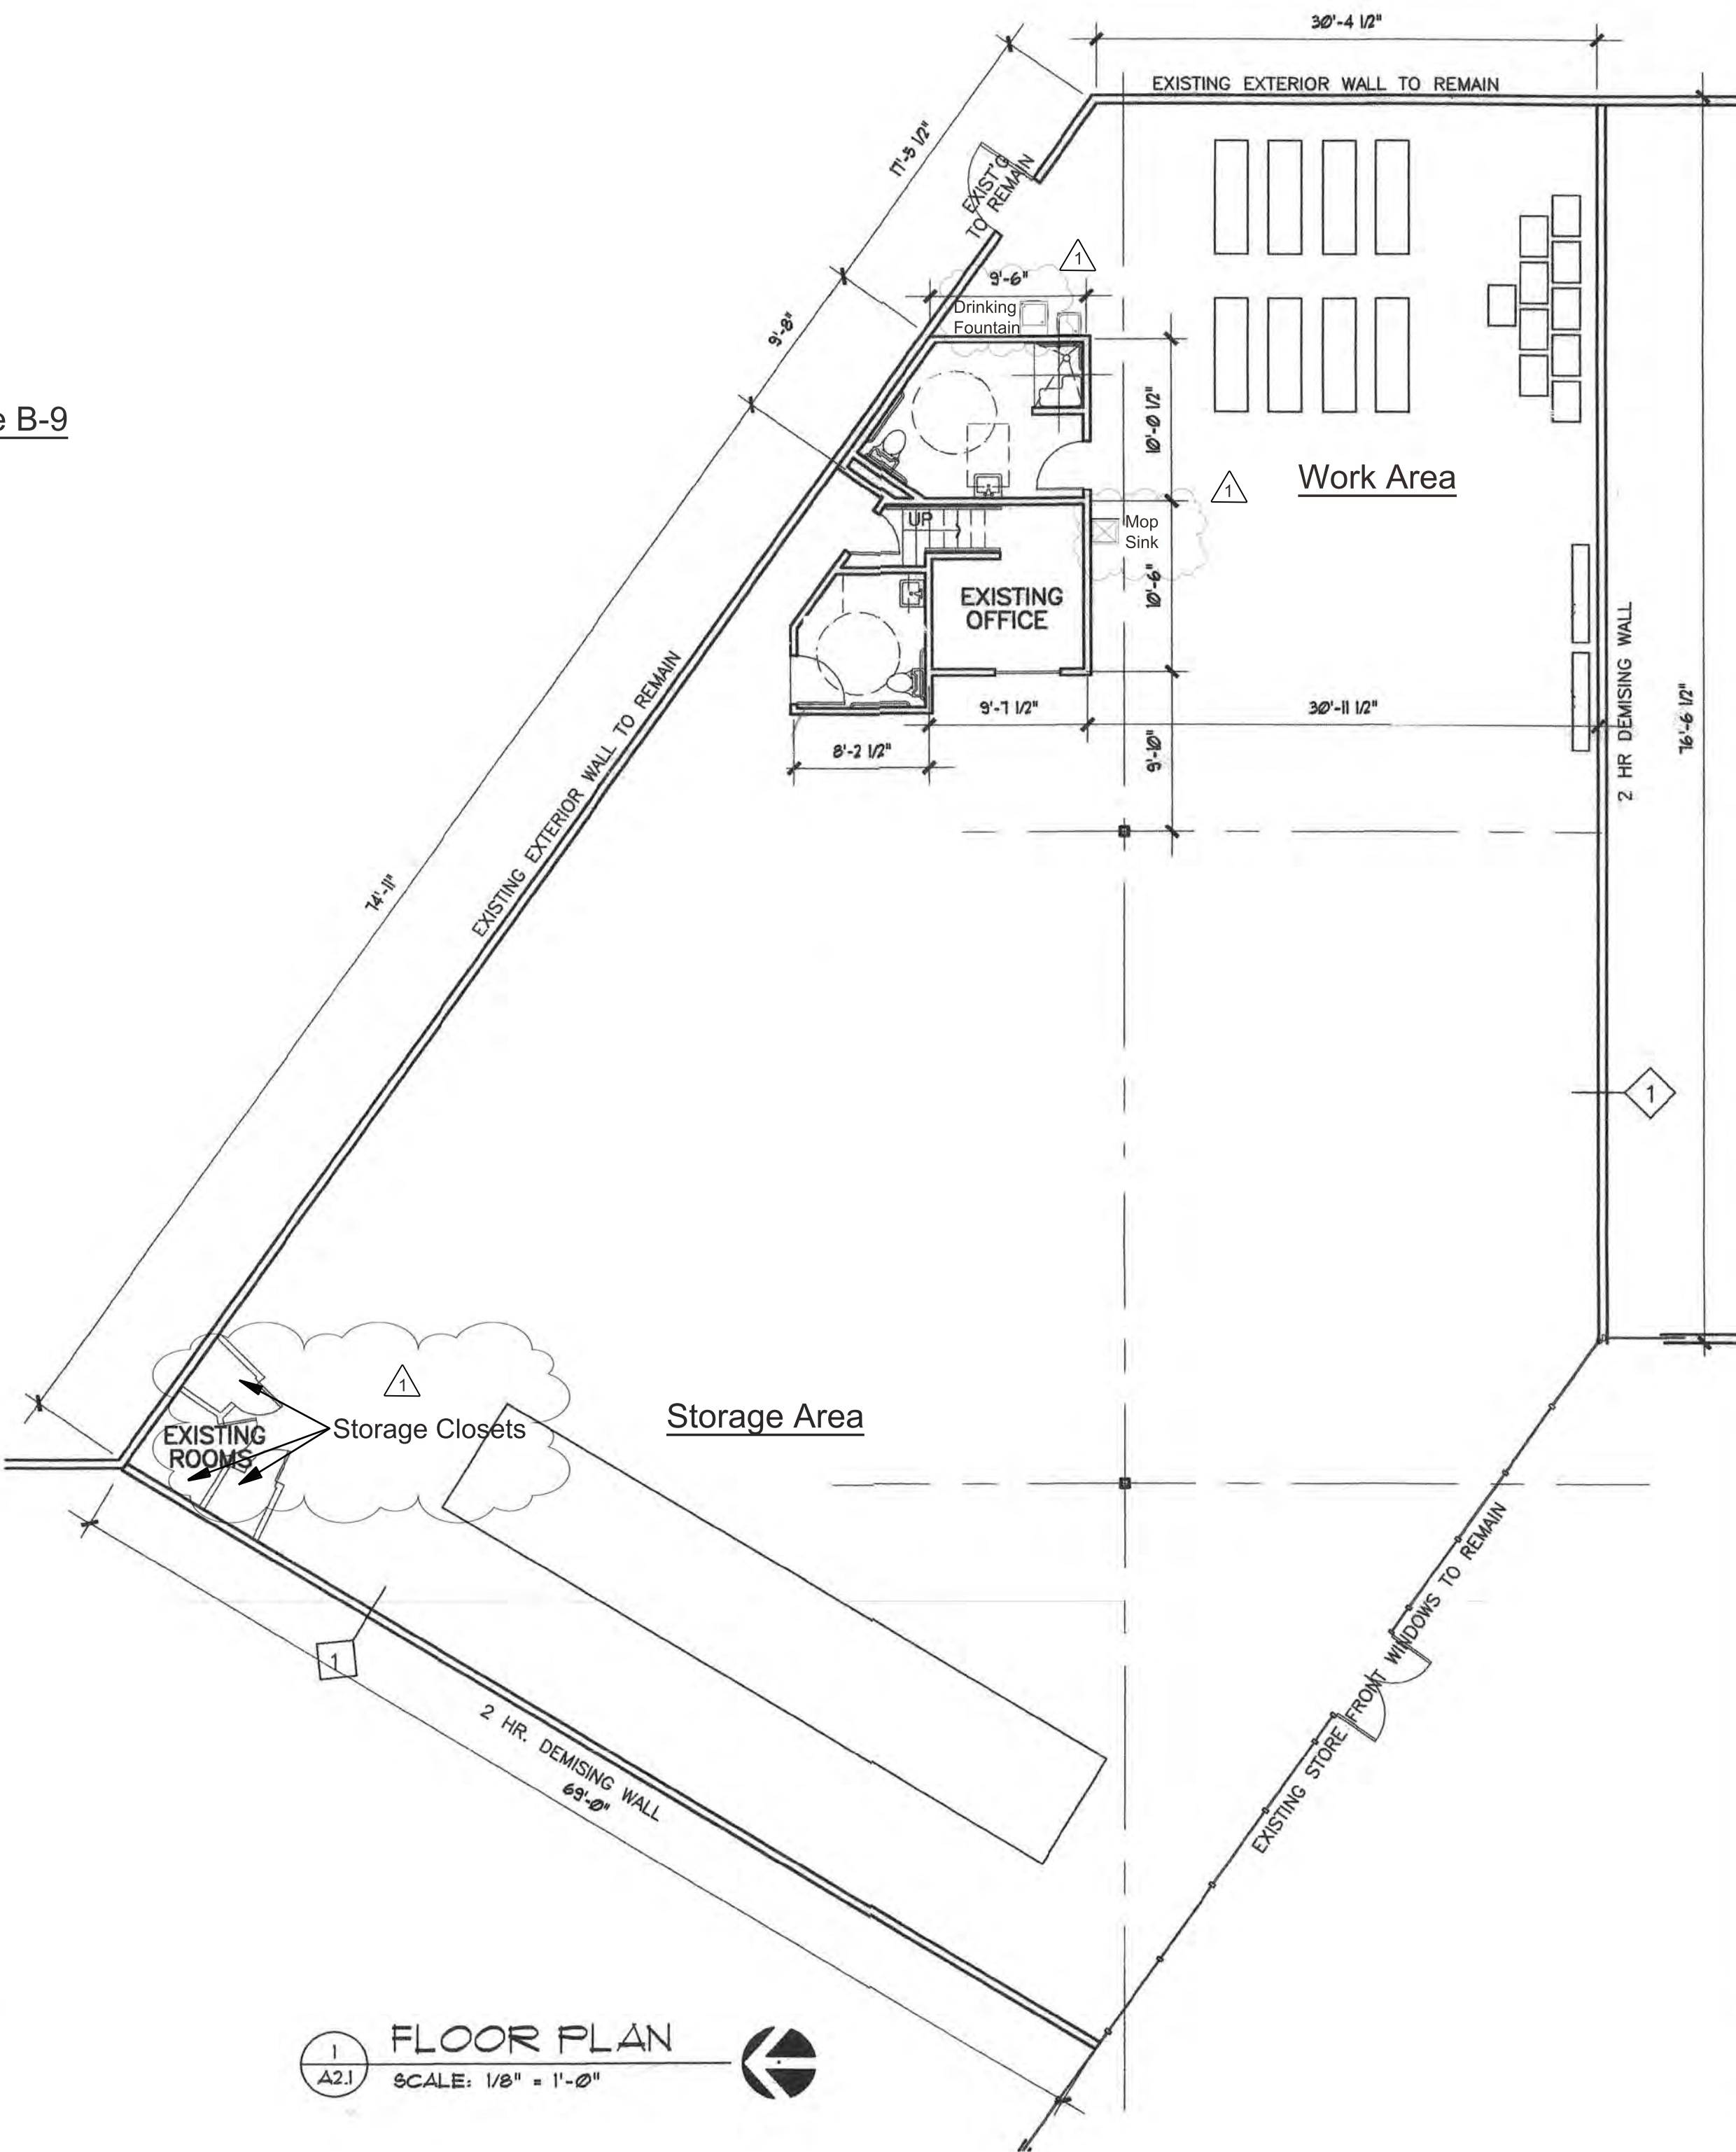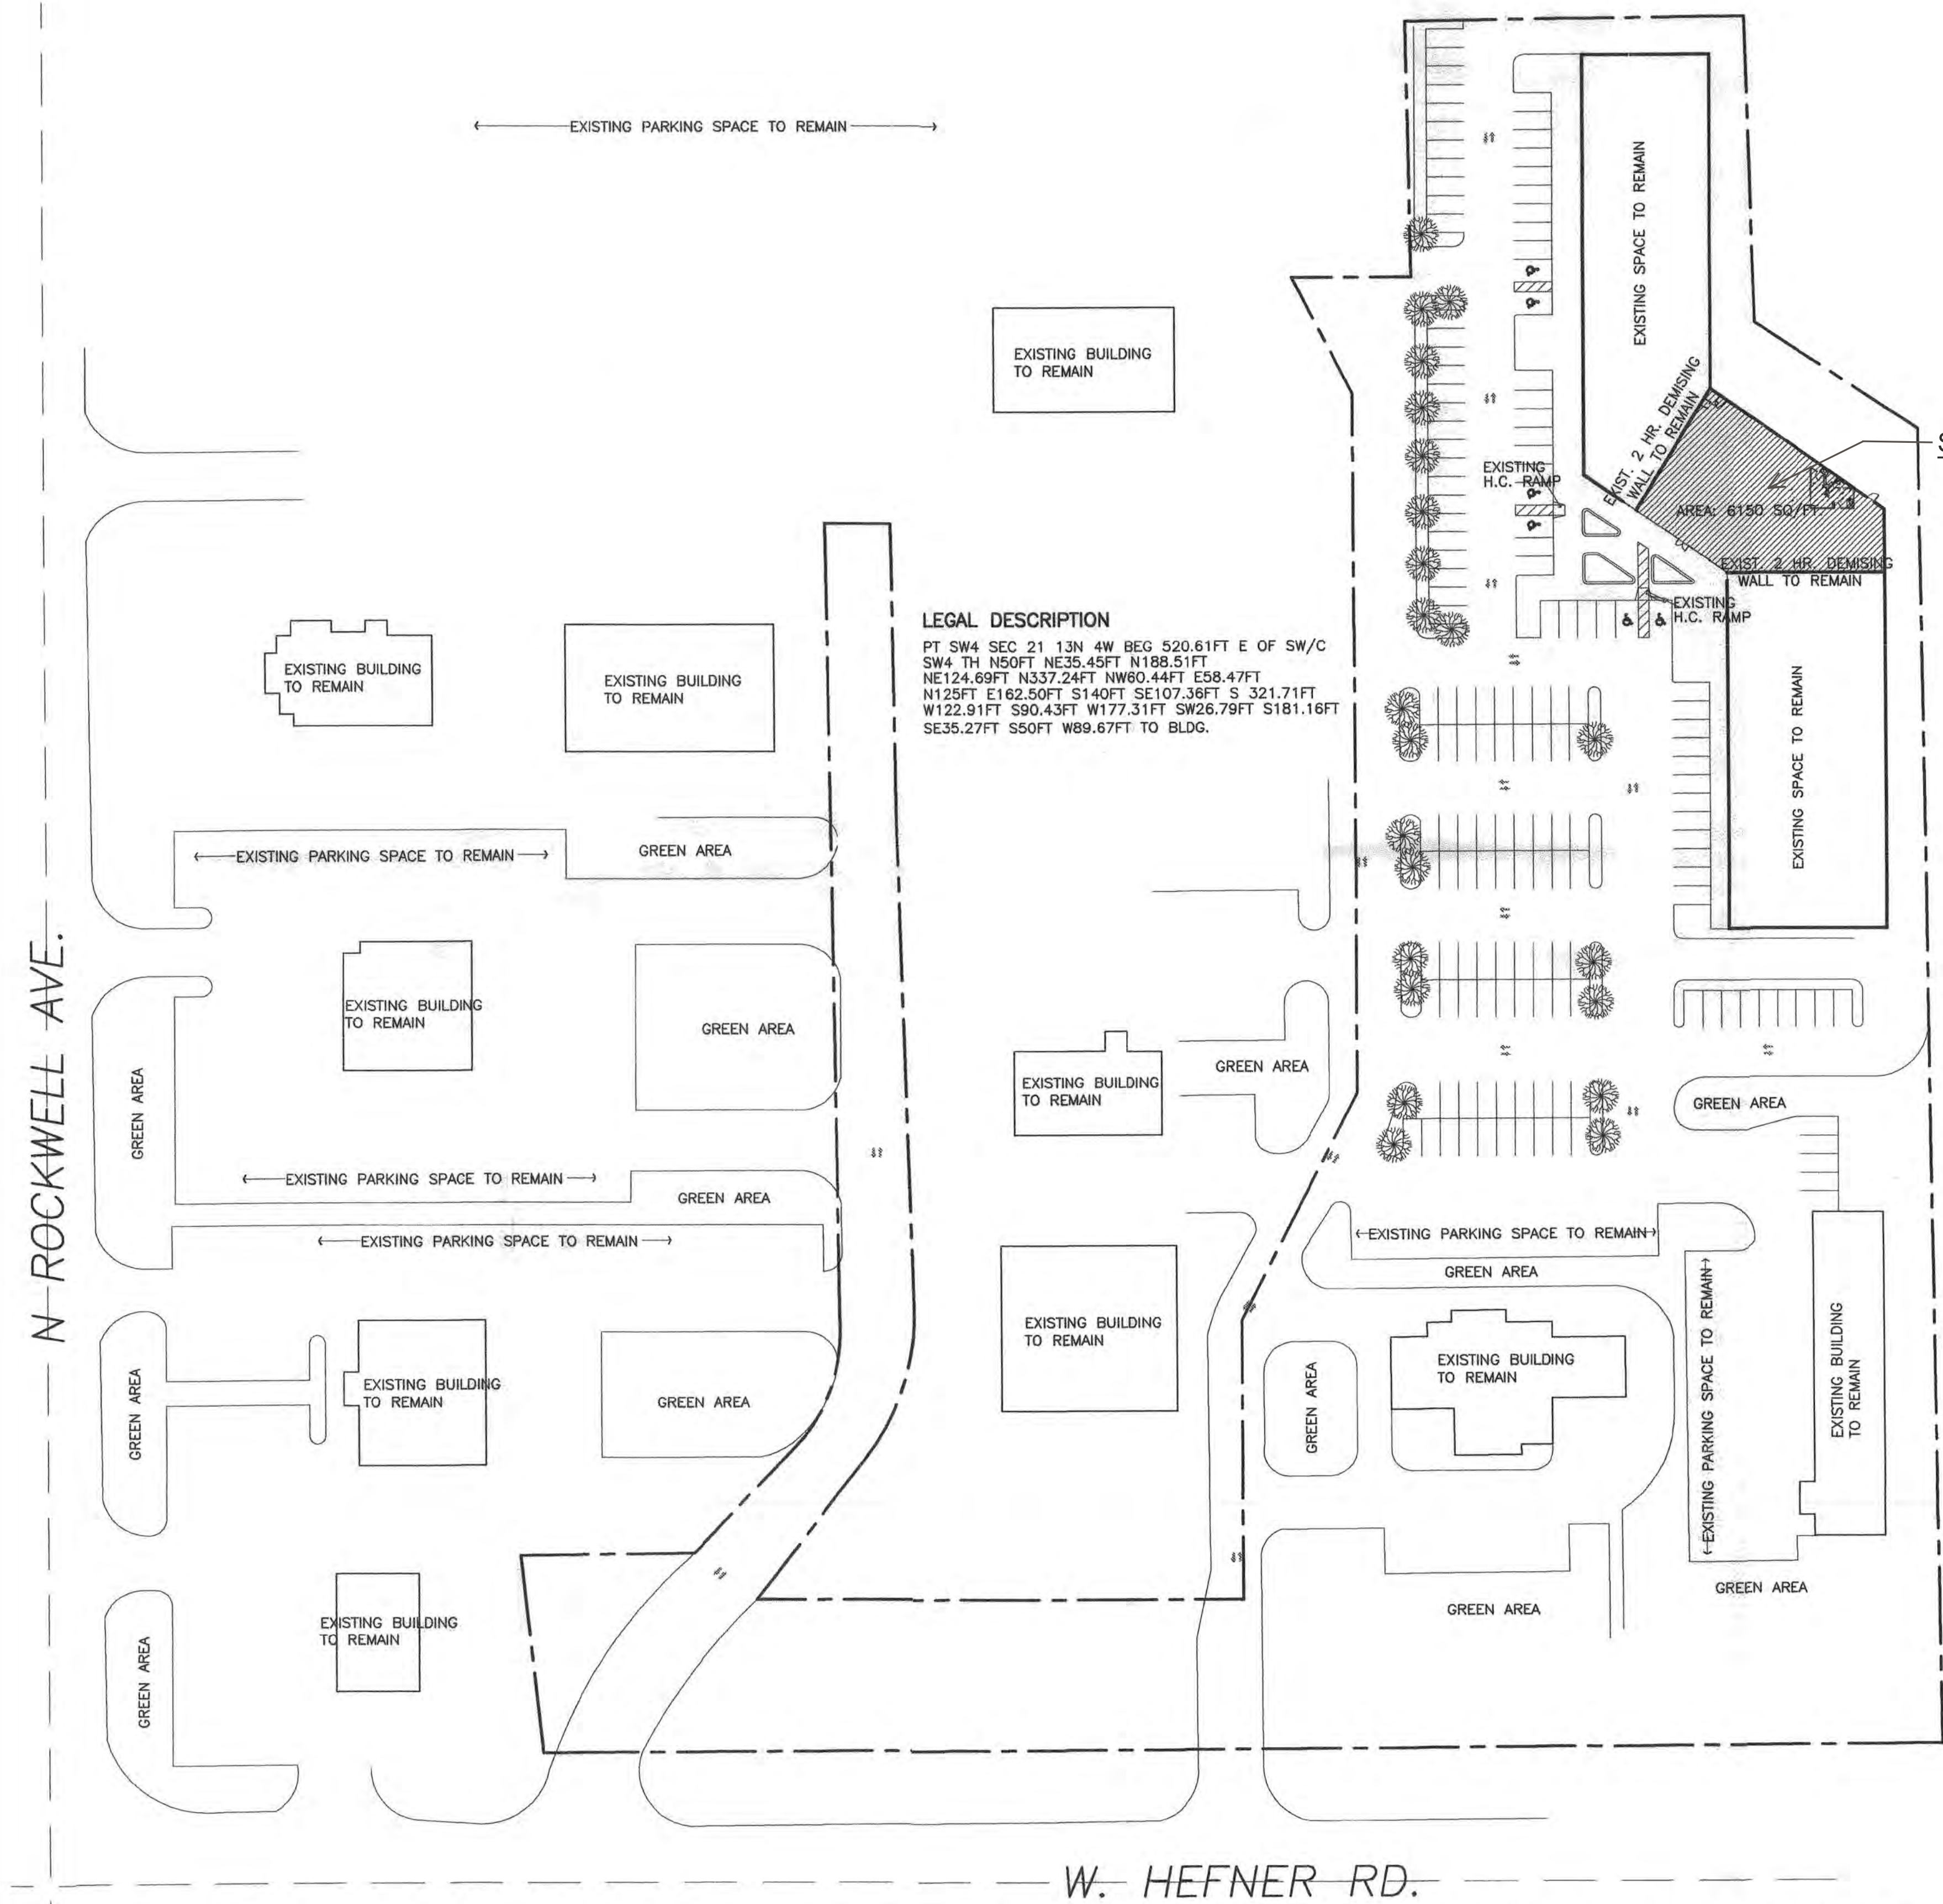

- 7/20/2022 -Add Drinking Fountain
- Add Mop Sink
- Lable Storage Closts