


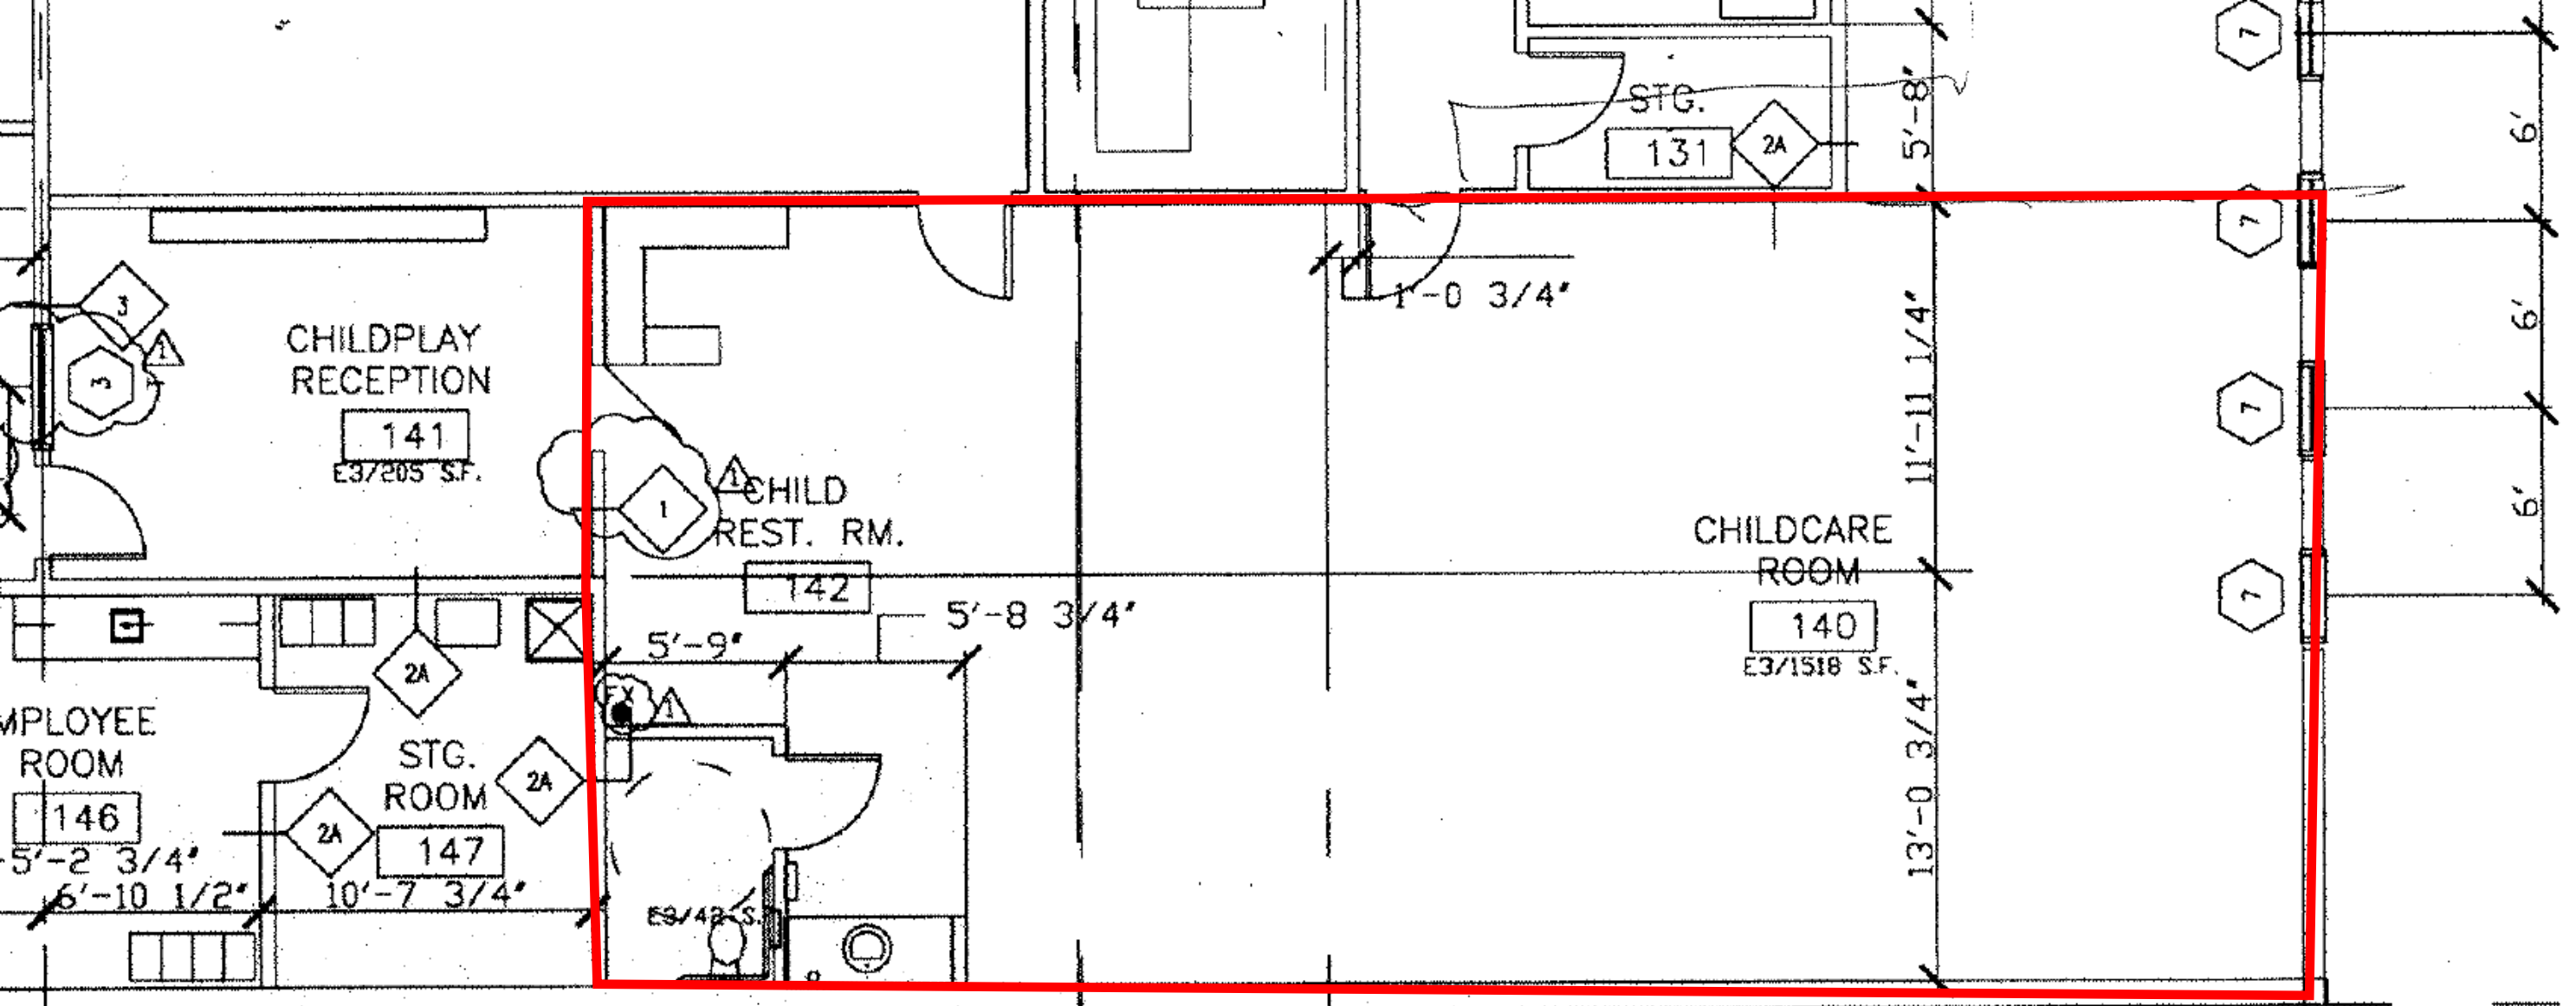

FIRST FLOOR PLAN

SCALE 1/8" = 1'-0"

Exterior Door