


Z:\Weather Flaming\630 Fitzwatertown Road\2024-0394 630 Fitzwatertown Rd WG PA Bldg B 1ST FLOOR HF.dwg

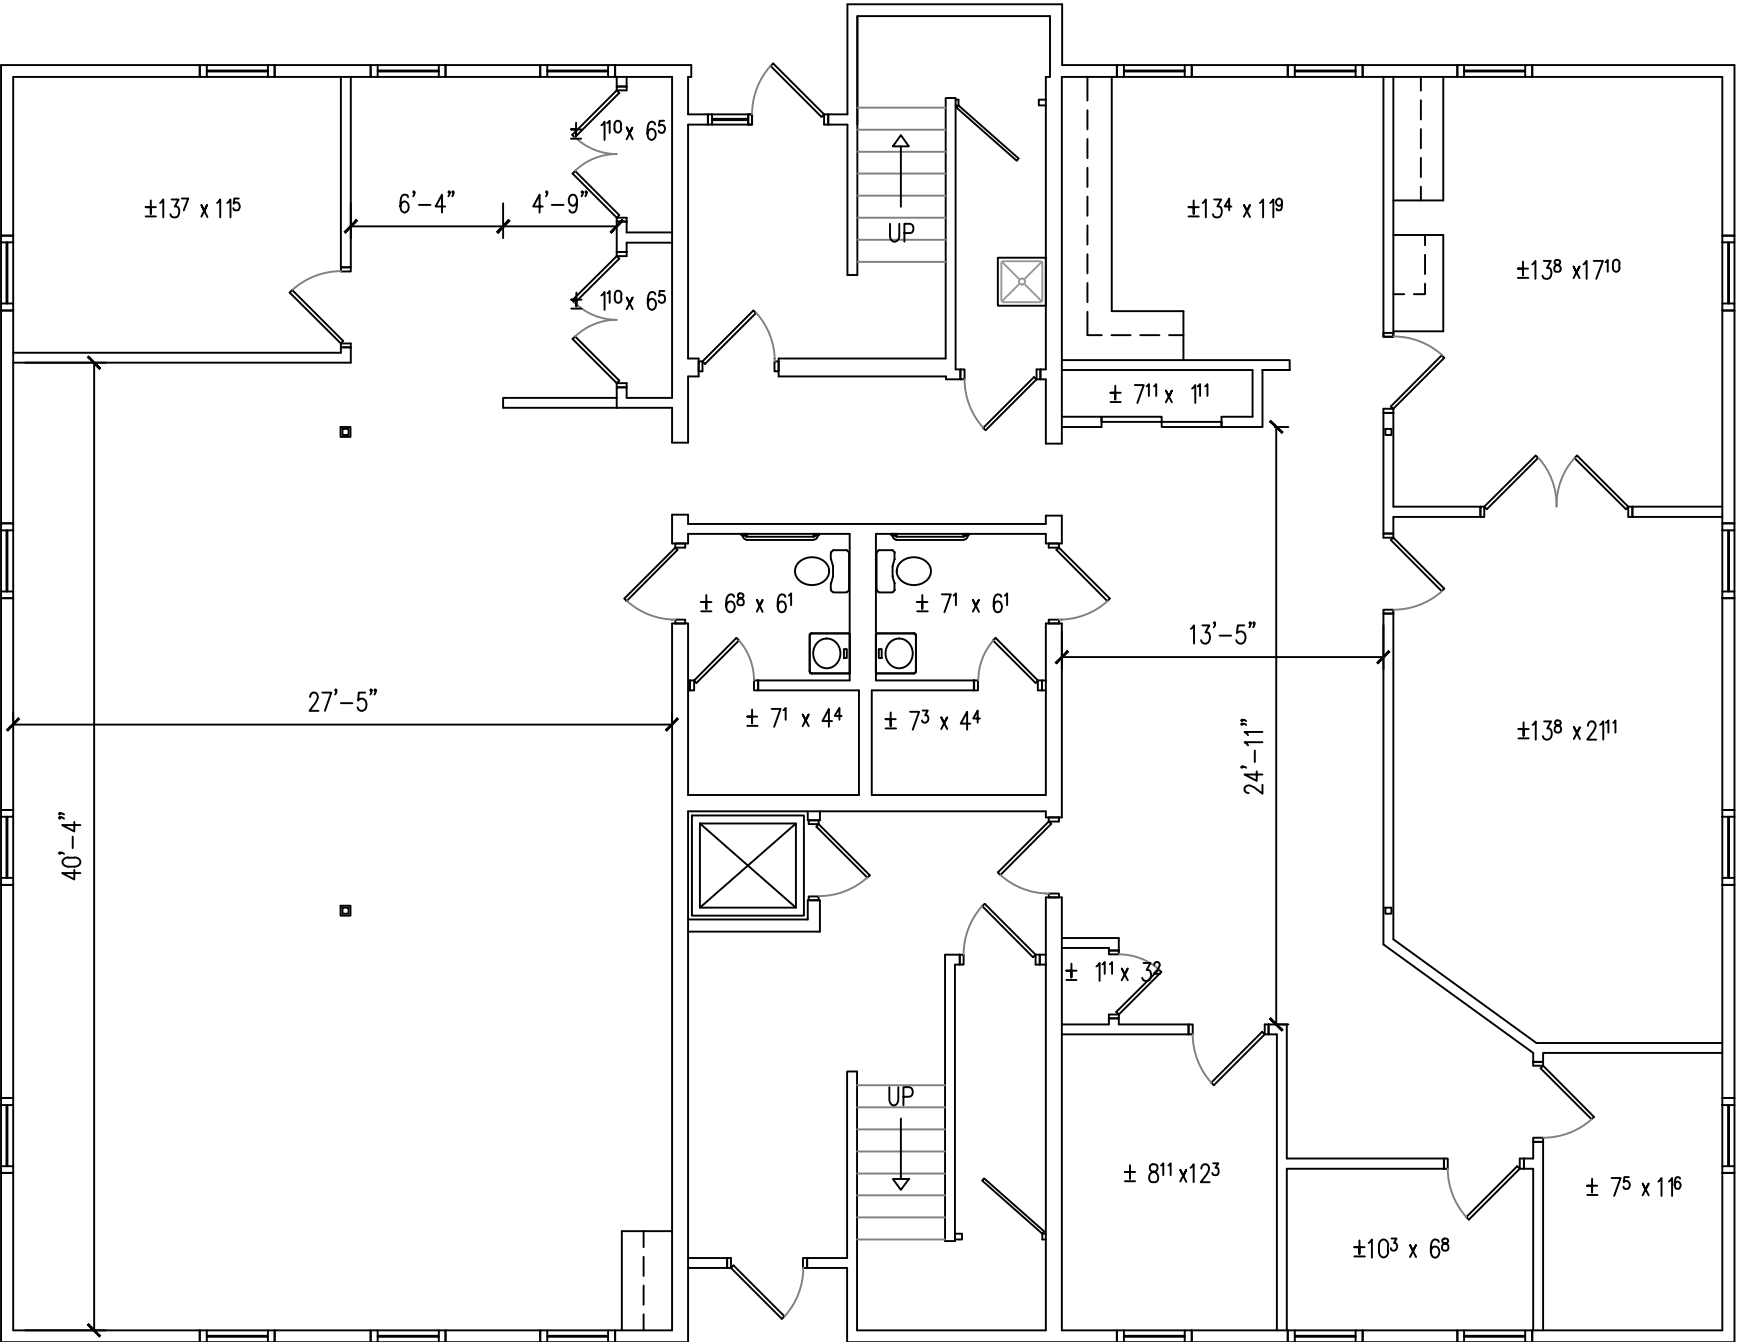

**FLOOR PLAN**

SCALE: 1/8" = 1'-0"

EXISTING CONDITIONS FOR:  
**BUILDING B**  
630 FITZWATERTOWN ROAD  
WILLOW GROVE, PA 19090

**RHJ ASSOCIATES, PC**  
ARCHITECTS · PLANNERS · DESIGNERS

|                                     |                                  |                                  |                                |
|-------------------------------------|----------------------------------|----------------------------------|--------------------------------|
| KING OF PRUSSIA, PA<br>610.337.4555 | MOUNT LAUREL, NJ<br>856.252.0040 | PHILADELPHIA, PA<br>215.279.5845 | WILMINGTON, DE<br>302.482.2269 |
| www.rhjassoc.com                    |                                  |                                  |                                |

|             |            |
|-------------|------------|
| DATE        | 05.20.2024 |
| PROJECT NO. | 2024-0394  |