


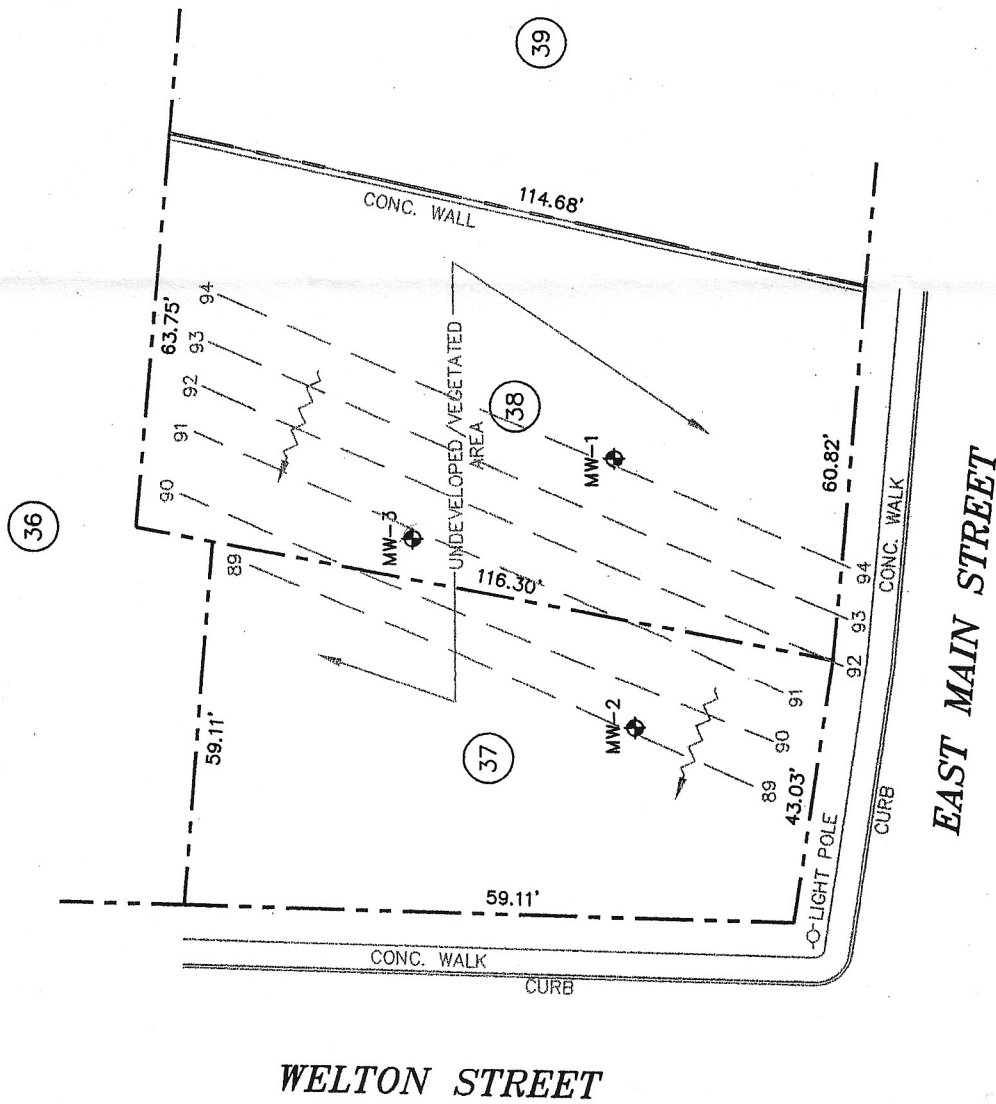

WELTON STREET

EAST MAIN STREET

MAP REFERENCE:

1. CITY OF WATERBURY, CT TAX ASSESSOR MAP NO. 296
NO DATE, NO SCALE

NOTES:

1. EXISTING CONDITIONS DEPICTED BASED ON A LIMITED SITE INVESTIGATION
BY ASW CONSULTING GROUP, LLC ON 7/6/06.
2. BUILDING SIZE AND LOCATION BASED ON BEST AVAILABLE INFORMATION
PROVIDED BY THE CITY OF WATERBURY, CT (SEE MAP REF. NO. 1 AND
PROPERTY RECORD CARDS FROM THE TAX ASSESSOR'S OFFICE).
3. MONITORING WELL LOCATIONS ARE BASED ON SWING TIE MEASUREMENTS
BY ASW CONSULTING GROUP, LLC.

LEGEND:

- PROPERTY LINE
- (8) TAX ASSESSOR LOT NO.
- TRAFFIC LIGHT POLE
- MW-1 MONITORING WELL/SOIL BORING BY ASW ON 7/6/06
- 89--- GROUNDWATER CONTOUR
- ~~~~~ ESTIMATED GROUNDWATER FLOW
(AUG. 17, 2006)

DRAWING NO.

FIG. 4

GROUNDWATER
CONTOUR MAP

563-573 EAST MAIN STREET
WATERBURY, CT

SCALE: 1"=30' DATE: 11/14/06

PREPARED FOR:
MAIN EAST ASSOCIATES, LLC
146 ALLENTOWN ROAD
WOLCOTT, CT 06716

PREPARED BY:
ASW CONSULTING GROUP, LLC
329 MAIN STREET, SUITE 203
WALLINGFORD, CT 06492-0495

ASW PROJECT NO. 1634