HOLLINS FERRY THREE

3321 HOLLINS FERRY ROAD,BALTIMORE, MD 21227

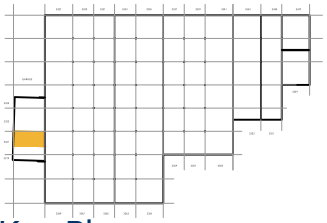

Key Plan

TOTAL SF AVAILABLE -1,050 SF

OFFICE - 0,000 SF

WAREHOUSE - 1,050 SF

Click to access **CADD file**

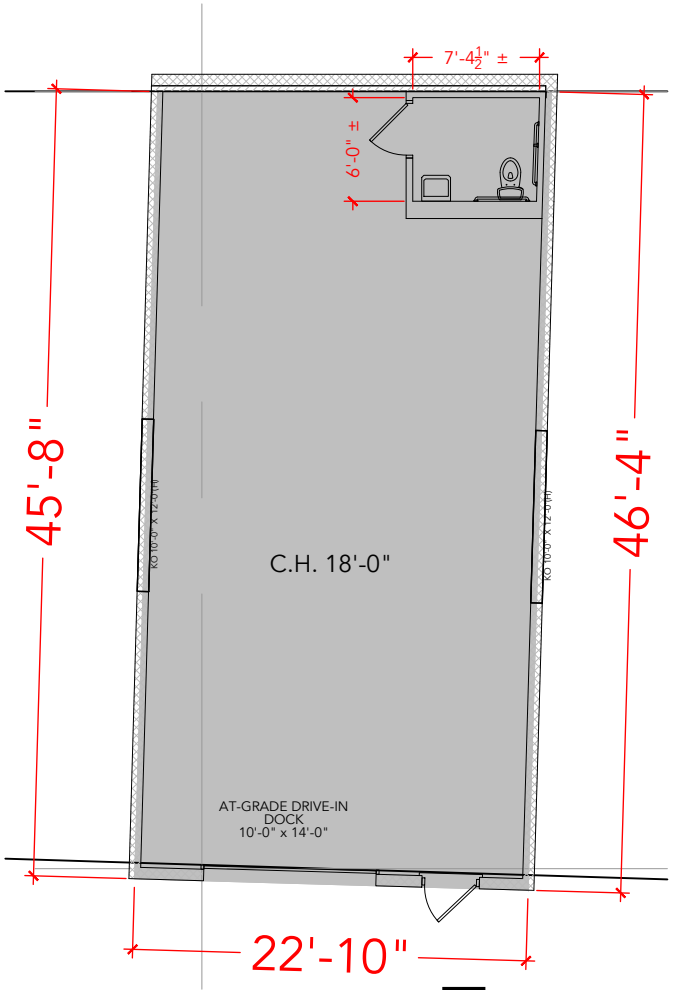

Floor Plan

PLAN NOT TO SCALE - THIS IS NOT A CONSTRUCTION DOCUMENT

DRAWING #: 017-3321 ASBUILT DATE: **NEEDS TO BE**