



Division of Environmental Health
865-429-1766 – Phone / 865-429-1965 - Fax
envirhealth@seviercountyttn.org

REQUEST FOR INFORMATION REGARDING

Subsurface Sewage Disposal (SSD) System Permit and Certificate of Completion

Complete the following information:

1. Current Owner's Name: ADF Capital LLC c/o Andrew Wenn
2. Address of Property: 4228 Wears Valley Rd
or Sevierville, TN 37876
3. Road Name of Lot Location: _____
Subdivision Name: _____
Lot # 161/162 Block 2 Phase: _____ Section: _____
Vacant Lot Yes X No _____
4. Date Home Constructed: _____ Number of Bedrooms: 4
5. Original Owner: _____
6. Previous Owners: _____

Do you want the results of this file search: Faxed _____ Office Pick-up _____ Mailed _____ E-Mailed _____
If mailed a stamped self-addressed envelope must be included in the application

Date: 9-3-26 Signature Michael S. Vink Fax Number: _____
Phone Number: 865-806-9005 Email: Brandon@SCALE-Group.net

For SCEH use only:

Date Received: 9.4.26

RESULT OF FILE SEARCH

SSD System Permit Issued: Date: _____ for a _____ Bedroom system.
☒ SSD System Certificate of Completion Approval: No _____ Yes ☒ for a SEE NOTE Bedroom system.
_____ File search was unable to locate any record of this property based upon the information provided.

Comment: See attached approval for FOUR bedrooms. Each unit is a Two bedroom.

Since no site visit has been made in regard to this request no comment or warranty about the current condition or future performance of the SSD system is given. This is not an INSPECTION LETTER and is not to be used for loan closings. Nor can the Division make any representation about whether unauthorized modifications have been made to either the SSD system or the original structure. This document only reflects what the Division's records show about the number of bedrooms authorized in the subsurface sewage disposal system permit based on the information provided in this application.

Environmental Specialist/ Office Personal [Signature] Date 9.4.26

SEVIER COUNTY HEALTH DEPARTMENT • DIVISION OF ENVIRONMENTAL HEALTH
CERTIFICATE OF COMPLETION OF SUBSURFACE SEWAGE DISPOSAL SYSTEM

Issued To: Vesper Properties Development
Owner, Developer, Contractor, Installer, Etc.

Location: Timber Cove
Lots 141/142

Type of System:


() 1. Conventional
☒ 2. EZ Flow () 12" () 14"
 () 3. Chamber System () 2' () 3'
 () 4. Large Diameter Gravelless Pipe () 8" () 10"
 (a) Gravel backfill required Yes () No ()

() 5. Other Concrete 1000 (x3) Atchley Septic Tank
(type) (volume)

Estimated Absorption Rate 30 # Bedrooms FOUR
(minutes per inch) Total

☒ New Installation () Repair () Other

Installed by: B. Hayes

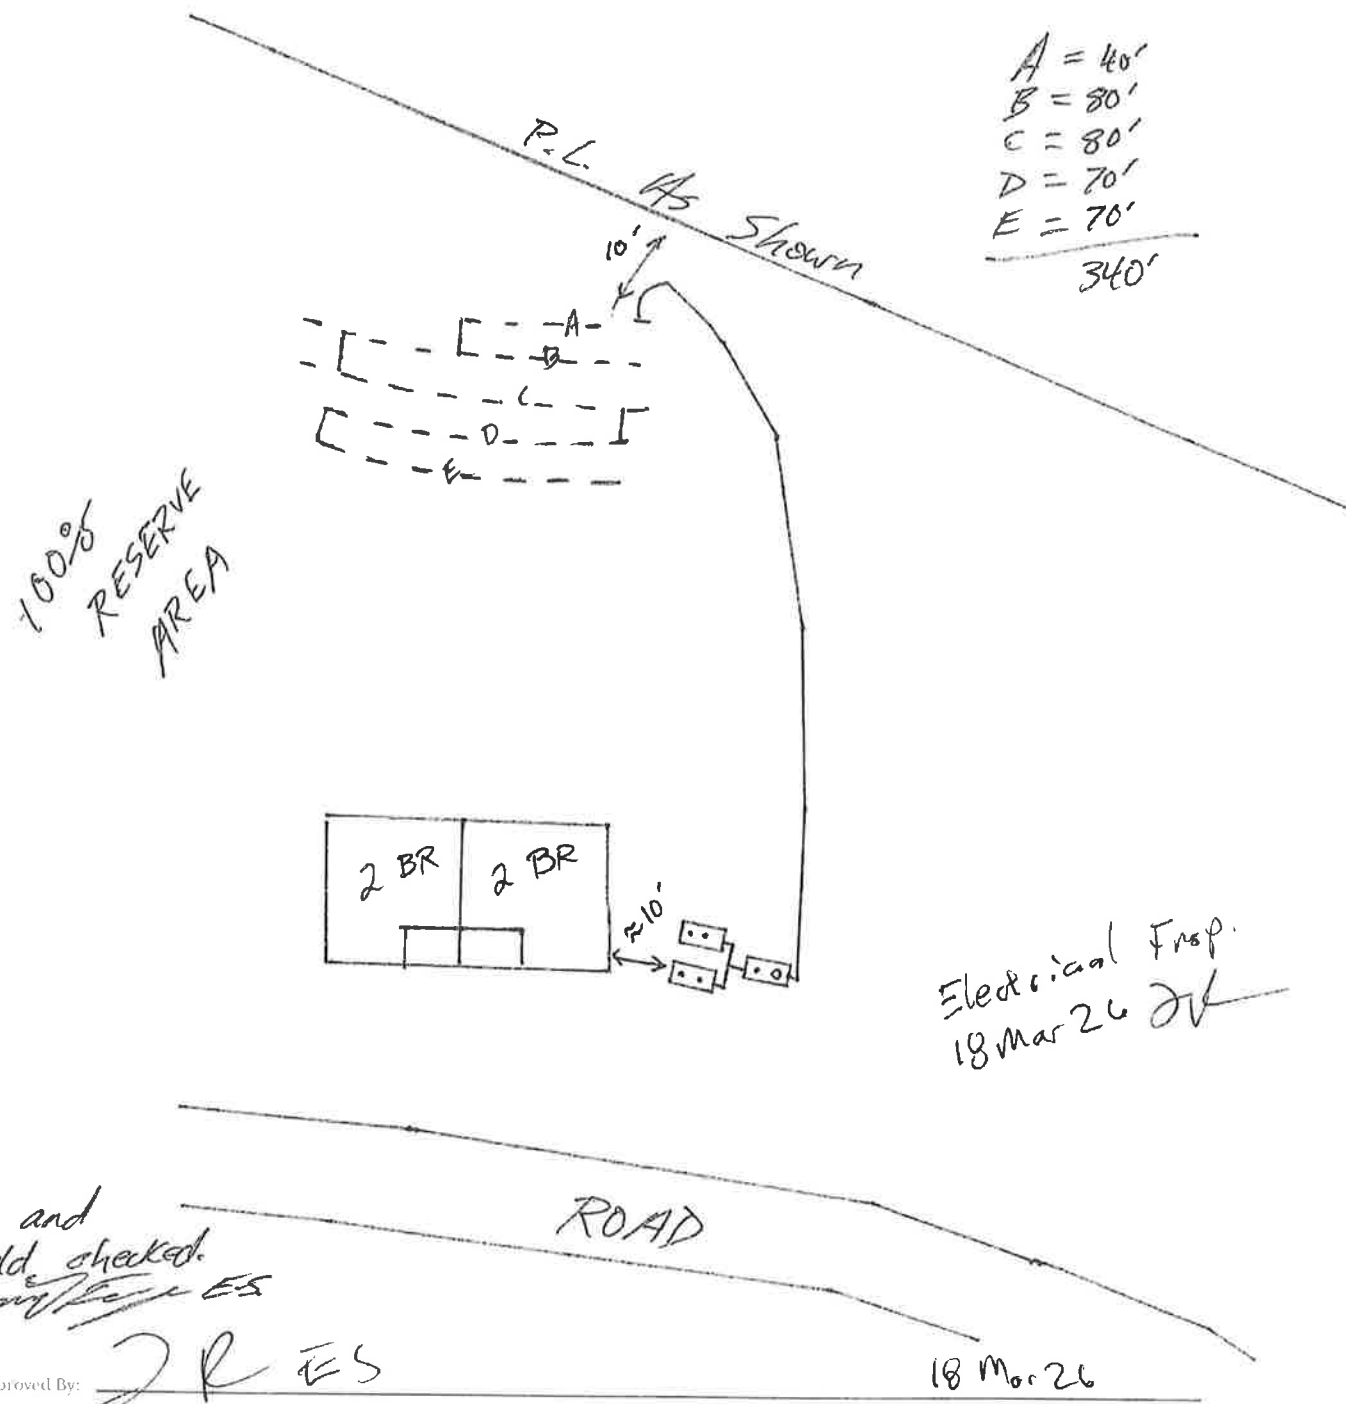

Tanks and
 drainfield checked.
Danny [Signature] ES

Construction Approved By: JR ES
(Name and Title)

18 Mar 26
(Date)

Original - File
 Copy - Owner