



ALAMANCE COUNTY HEALTH DEPARTMENT
ENVIRONMENTAL HEALTH SECTION

Improvement Permit- New

IP

A Construction Authorization must be purchased to obtain a building permit (This is not a Construction Authorization)

Tax Map Number 7-8-12	GPIN 8881703561	Application Date 7/19/2023	Permit Number 7649IMPR23
--------------------------	--------------------	-------------------------------	-----------------------------

Site Address 4230 S NC 87 HWY. GRAHAM, NC 27253

Directions HWY 87 SOUTH; ON LEFT BEFORE PREACHER HOLMES RD

Applicant	ALFRED & CHRISTINA STURGES 5909 OSCAR GAMMON RD MEBANE, NC 27302 (336) 213-3514	Owner	ALFRED & CHRISTINA STURGES 5909 OSCAR GAMMON RD. MEBANE, NC 27302 (336) 213-3514
Phone		Phone	
Fax		Fax	
Other		Other	
Email	whitetailhuntsplus@yahoo.com	Email	whitetailhuntsplus@yahoo.com

Type of Structure	BUSINESS	Business Type	Businesses - other
Pump Required	Yes	Business Sub-Type	n/a
Grease Trap Required	No	Number of employees	3
Projected Daily Flow	100 GPD		
Permit Valid For	Expires 8/22/2028	Type of Water Supply	Well
Wastewater System Type	Pump Type IIIB		
System Description	Pump to Conventional Septic System		
System Distribution	n/a		
Repair System Type	N/A		
Repair Description			
Repair System Distribution	n/a		
LTAR			
Usable soil depth to Limiting Condition for Initial area	0 inches		
Usable soil depth to Limiting Condition for Repair area	0 inches		
Minimum Trench Depth	18 inches		
Maximum Trench Depth	0 inches		

Permit Conditions:

Other: PRECONSTRUCTION VISIT WITH EHS REQUIRED TO ENSURE EXISTING SEPTIC SYSTEM IS MARKED OR ROPED OFF BEFORE INSTALLATION.

DO NOT CUT OR FILL EXISTING SEPTIC SYSTEM AREA. DO NOT DRIVE OVER, DISTURB, OR PUT GRAVEL OR CEMENT OVER EXISTING SEPTIC SYSTEM. DO NOT PUT DRIVEWAY OR PARKING LOT OVER ANY PARTS OF THE EXISTING SEPTIC SYSTEM. EXISTING SEPTIC SYSTEM AREA MUST BE MARKED AND ROPED OFF PRIOR TO CONSTRUCTION OF WAREHOUSE. SEPTIC CONTRACTOR MUST LOCATE SEPTIC TANK AND PUMP TO ORIGINAL SEPTIC TANK. SEPTIC CONTRACTOR MUST AVOID HITTING EXISTING SEPTIC SYSTEM WHEN INSTALLING TANKS AND SUPPLY LINE. HIGHLY RECOMMEND EXISTING SEPTIC SYSTEM ALWAYS BE MARKED OR ROPED OFF DURING AND AFTER CONSTRUCTION OF PROPOSED WAREHOUSE.


All pump designs and installations shall be in accordance with the Laws and Rules for Sewage Treatment, and Disposal Systems 15A NCAC 18E subject to approval by Alamance County Health Department.

See Attached Site Sketch

The issuance of this permit in no way guarantees the issuance of other permits. The permit holder is responsible for checking with appropriate governing bodies in meeting their requirements. This permit is subject to revocation if the site plan, plat, or the intended use changes. The Improvement Permit shall not be affected by a change in ownership of the site. This permit is subject to compliance with the provisions of 15A NCAC 18E and to the conditions of this permit.

Authorized State Agent Hannah Maness

Date 8/22/2023

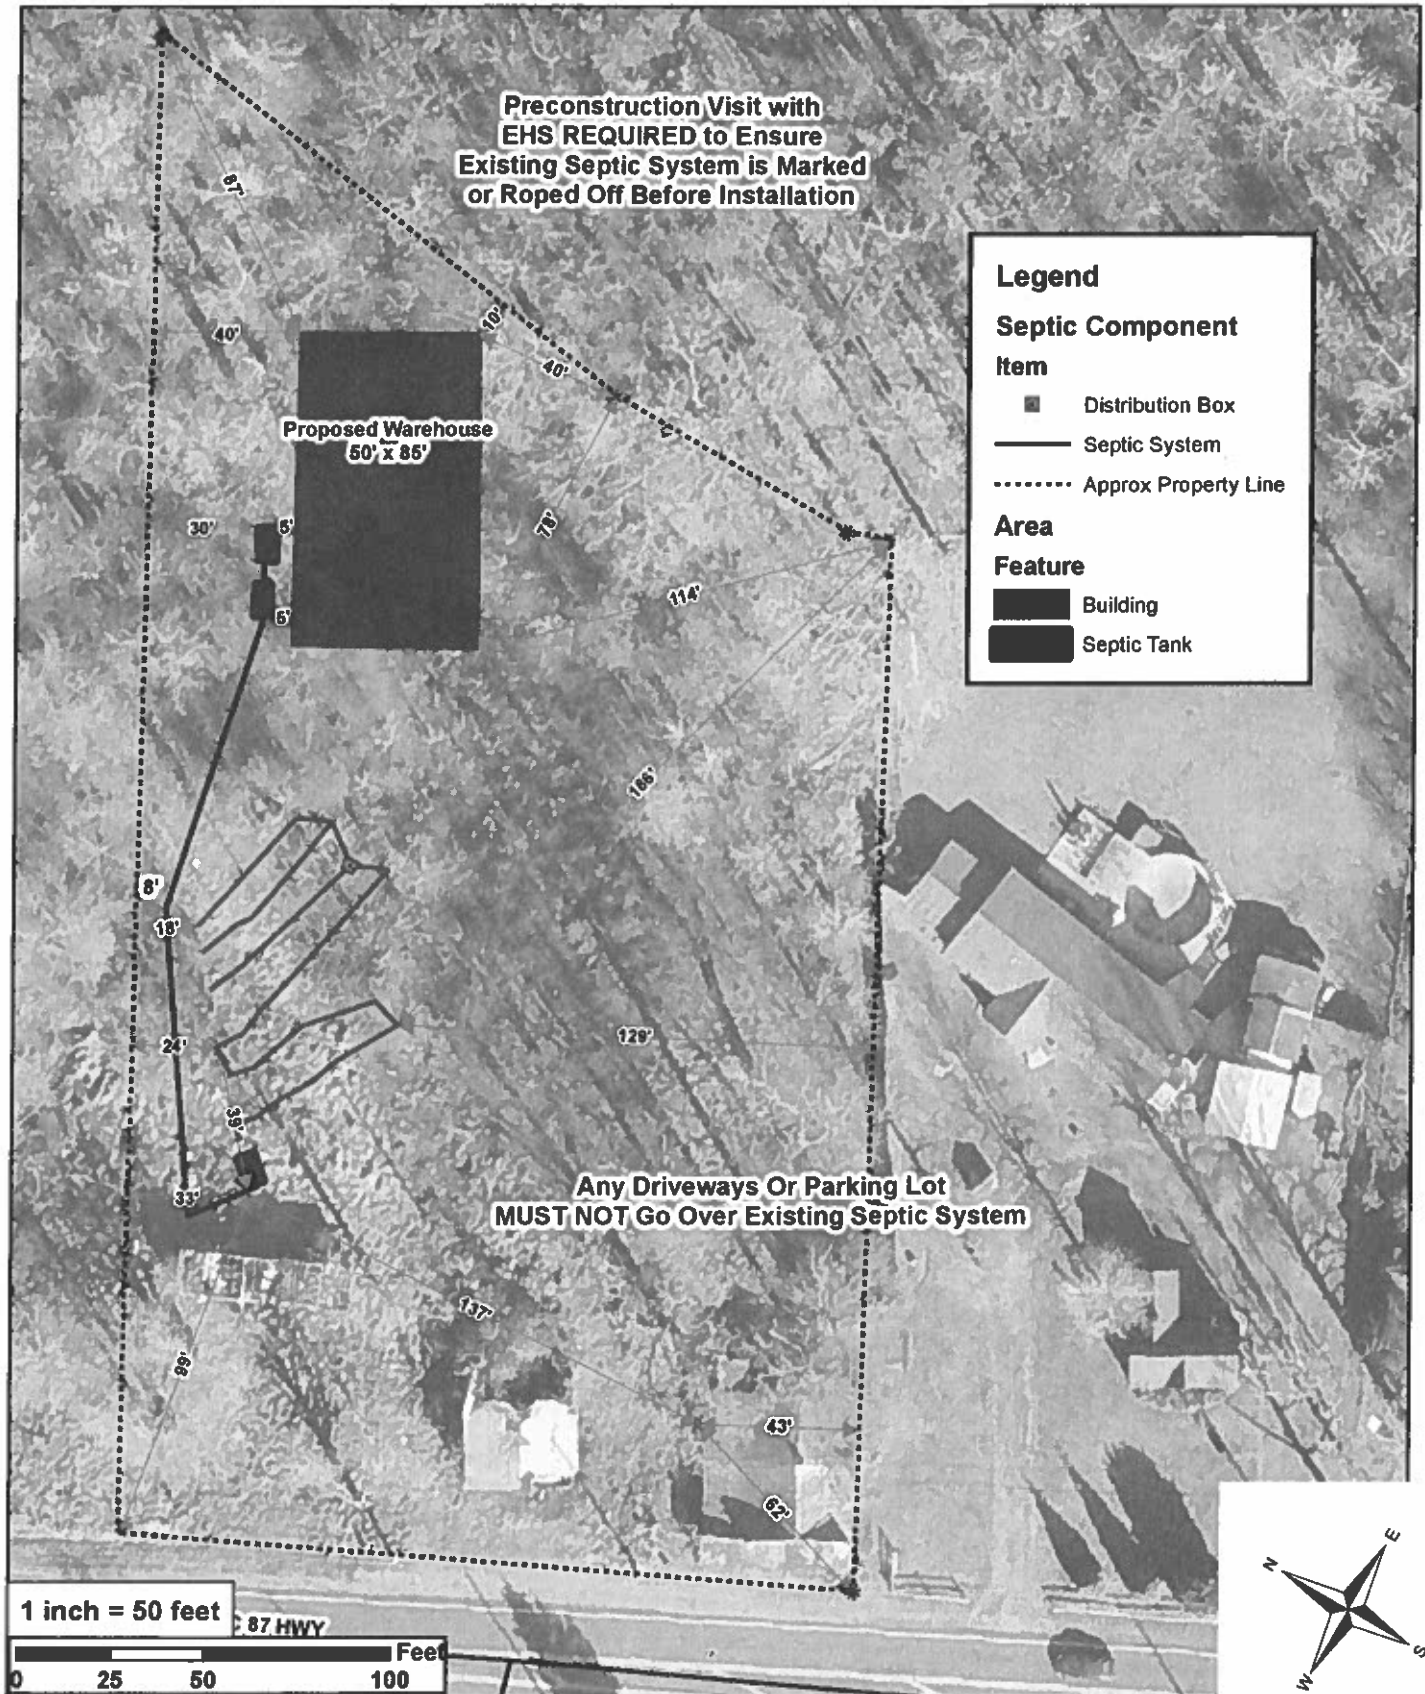

Scale is approximate and may not be accurate on emailed, scanned, and faxed copies of this drawing.

This Map is the best representation of field data based on information supplied to ACHD and is accurate within the limits of our equipment. This is not a survey map. Property Lines must be clearly marked in the field by the property owner prior to work on the well and septic system.

Drawn By: HM
Date Printed: 9/7/2023