


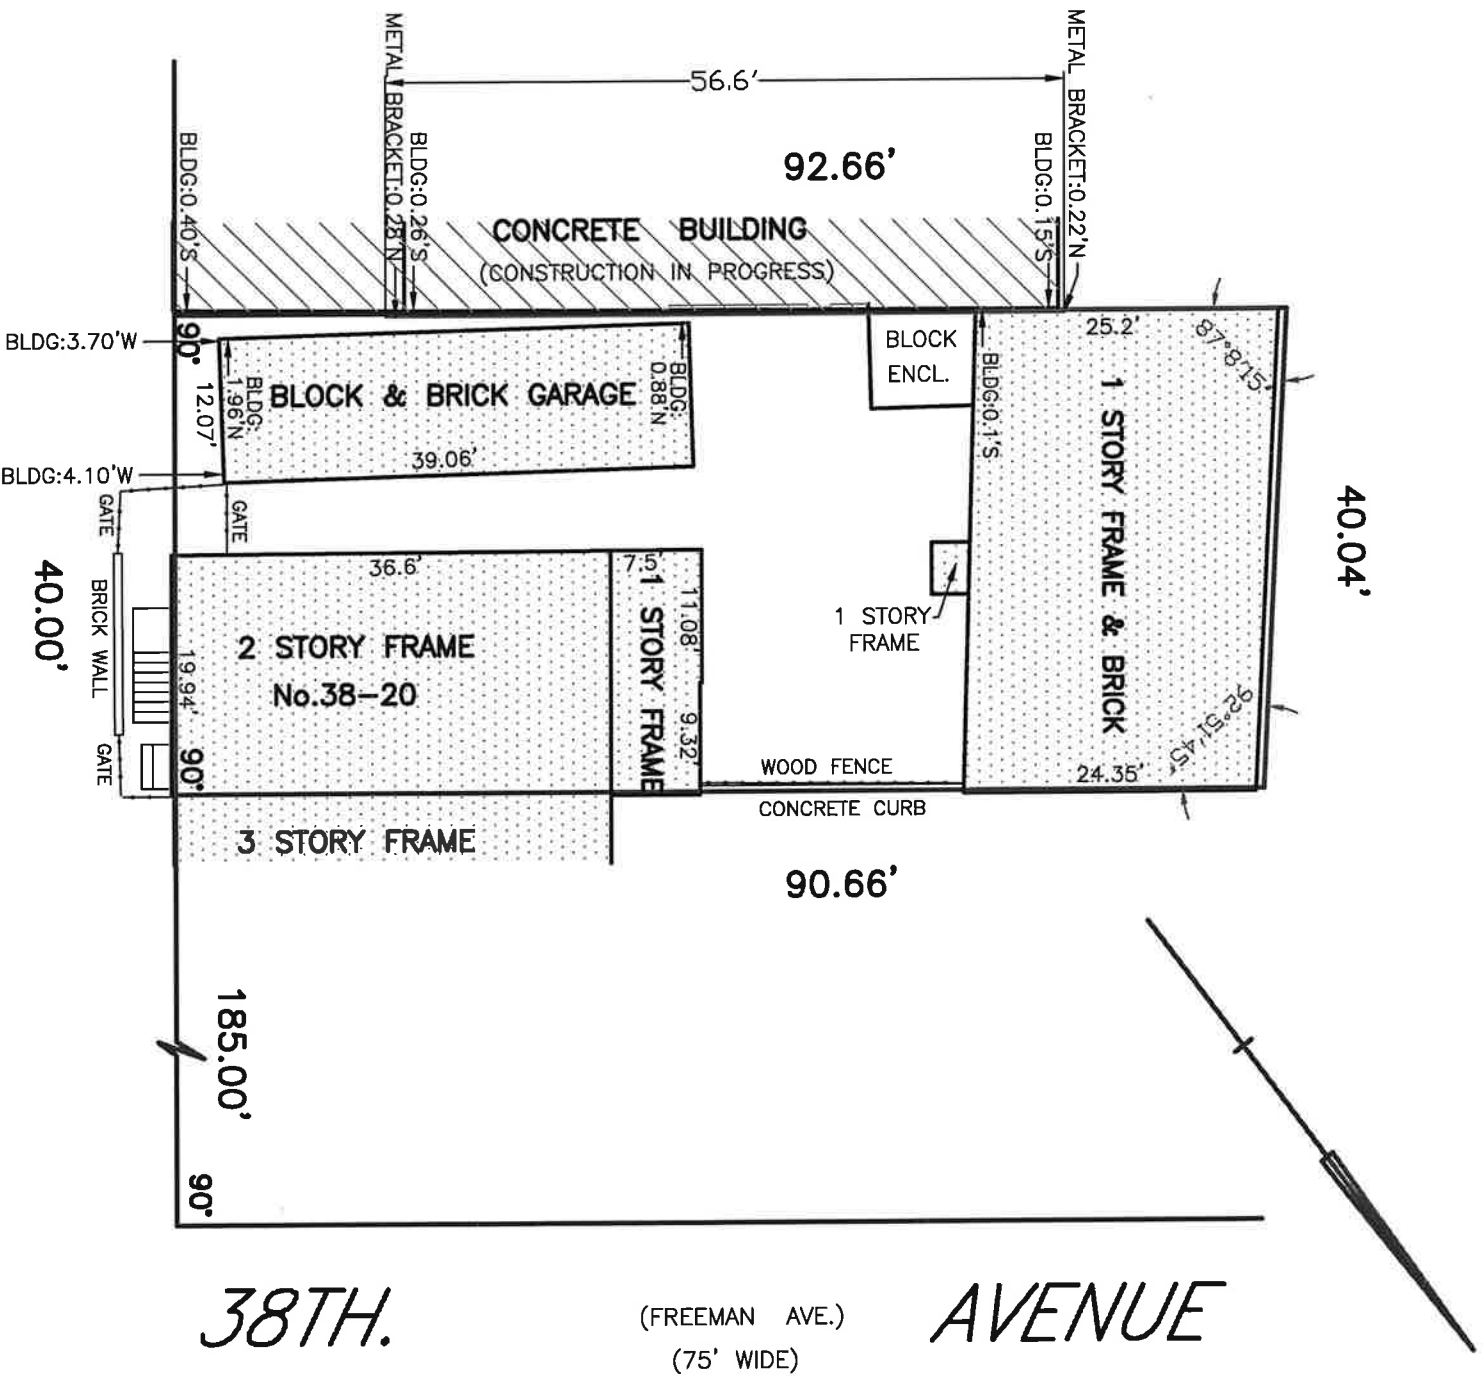

27TH.

(PROSPECT ST.)
(60' WIDE)

STREET

38TH.

(FREEMAN AVE.)
(75' WIDE)

AVENUE

MAP OF SURVEY
OF PROPERTY AT
QUEENS

SCALE: 1"=16'

<u>LOCATION OF NEW CONSTRUCTION</u>		<u>AUTAR LAND SURVEYING, P.C.</u> 214-43 JAMAICA AVENUE QUEENS VILLAGE, N.Y. 11428 TEL (718) 740-1339 FAX (718) 740-0024 Email: ajl@autar.com
<u>SURVEYED FOR:</u> DAVID ZARATE		<i>Autar.</i>
TITLE No.:		
TAX MAP DESIGNATION:		
SECTION : 3		
BLOCK : 387		
LOT : 28		
SURVEYED: SEPTEMBER 24, 2013		5575 DZ

UNAUTHORIZED ALTERATION OR ADDITION TO
THIS SURVEY IS A VIOLATION OF SECTION 2209(2)
OF THE NEW YORK STATE EDUCATION LAW.
ONLY COPIES FROM THE ORIGINAL OF THIS SURVEY
MARKED WITH AN ORIGINAL OF THE LAND SURVEYOR'S
INKED SEAL OR EMBOSSED SEAL SHALL BE
CONSIDERED A VALID TRUE COPY.
CERTIFICATIONS INDICATED HEREON SHALL RUN
ONLY TO THE PERSON FOR WHOM THE SURVEY IS
PREPARED AND ON HIS/HER BEHALF TO THE TITLE
COMPANY, GOVERNMENTAL AGENCY AND LENDING
INSTITUTION LISTED HEREON AND TO THE ASSOCIATES
OF THE LENDING INSTITUTION.
CERTIFICATIONS ARE NOT TRANSFERABLE TO ADDITIONAL
INSTITUTIONS OR SUBSEQUENT OWNERS.

Autar