
Area Certification:
As evidenced by our signature and in accordance with the existing lease agreement, we hereby certify the Total Leasable Area of this premises to be **1,499 Square Feet** as indicated below. Area shown does not include a proportionate share of utility room.

Measure Masters Edmonton

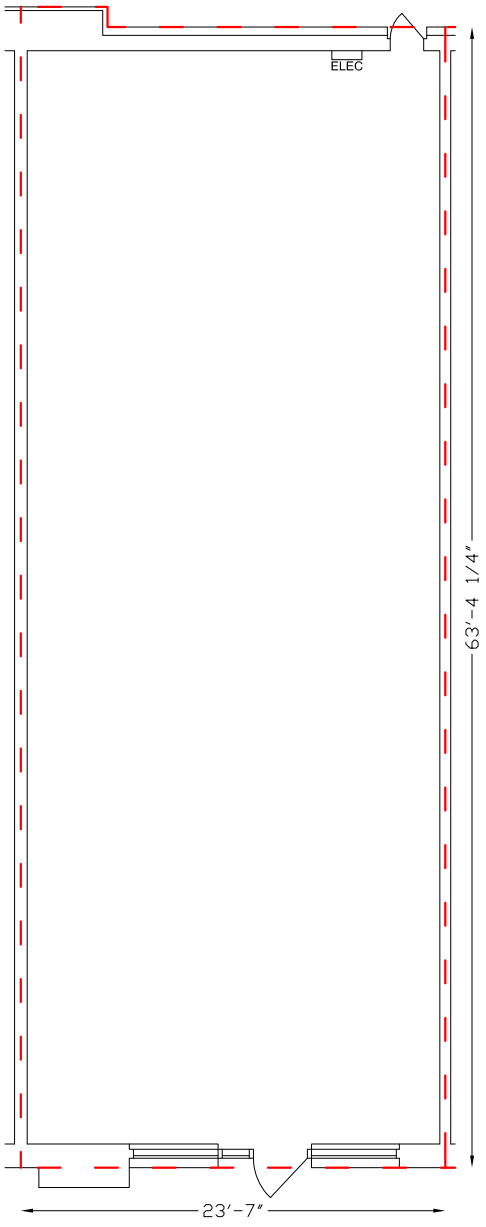

MELCOR DEVELOPMENTS LTD. 1971-2011
900, 10310 Jasper Avenue
Edmonton, AB T5J 1Y8

Project: Village at Blackmud Creek
904-920 - 103A Street
Edmonton, AB

MEASURE MASTERS EDMONTON
t: (780) 413-7236
e: edmonton@measuremasters.ca

Drawing: CRU 912

Scale: 3/32" = 1 Ft

Drawn by: DG

Date: Jan 9/14