

[illegible]



Containing within said bounds 18,779 acres (818,019 square feet) more or less.

THE LANDS SURVEYED, SHOWN AND DESCRIBED HEREON ARE THE SAME LANDS AS DESCRIBED IN THE TITLE COMMITMENT PROVIDED BY FIDELITY NATIONAL TITLE INSURANCE COMPANY.

ALTA/NPS LAND TITLE SURVEY
PREPARED FOR
Southlake Pavilion Update
DATE OF FIELD SURVEY: Sept. 26, 2019
NETWORK PROJECT NUMBER: 201904602.001
1-(800)-SURVEYS (787-8397)
TRANSACTION SERVICES

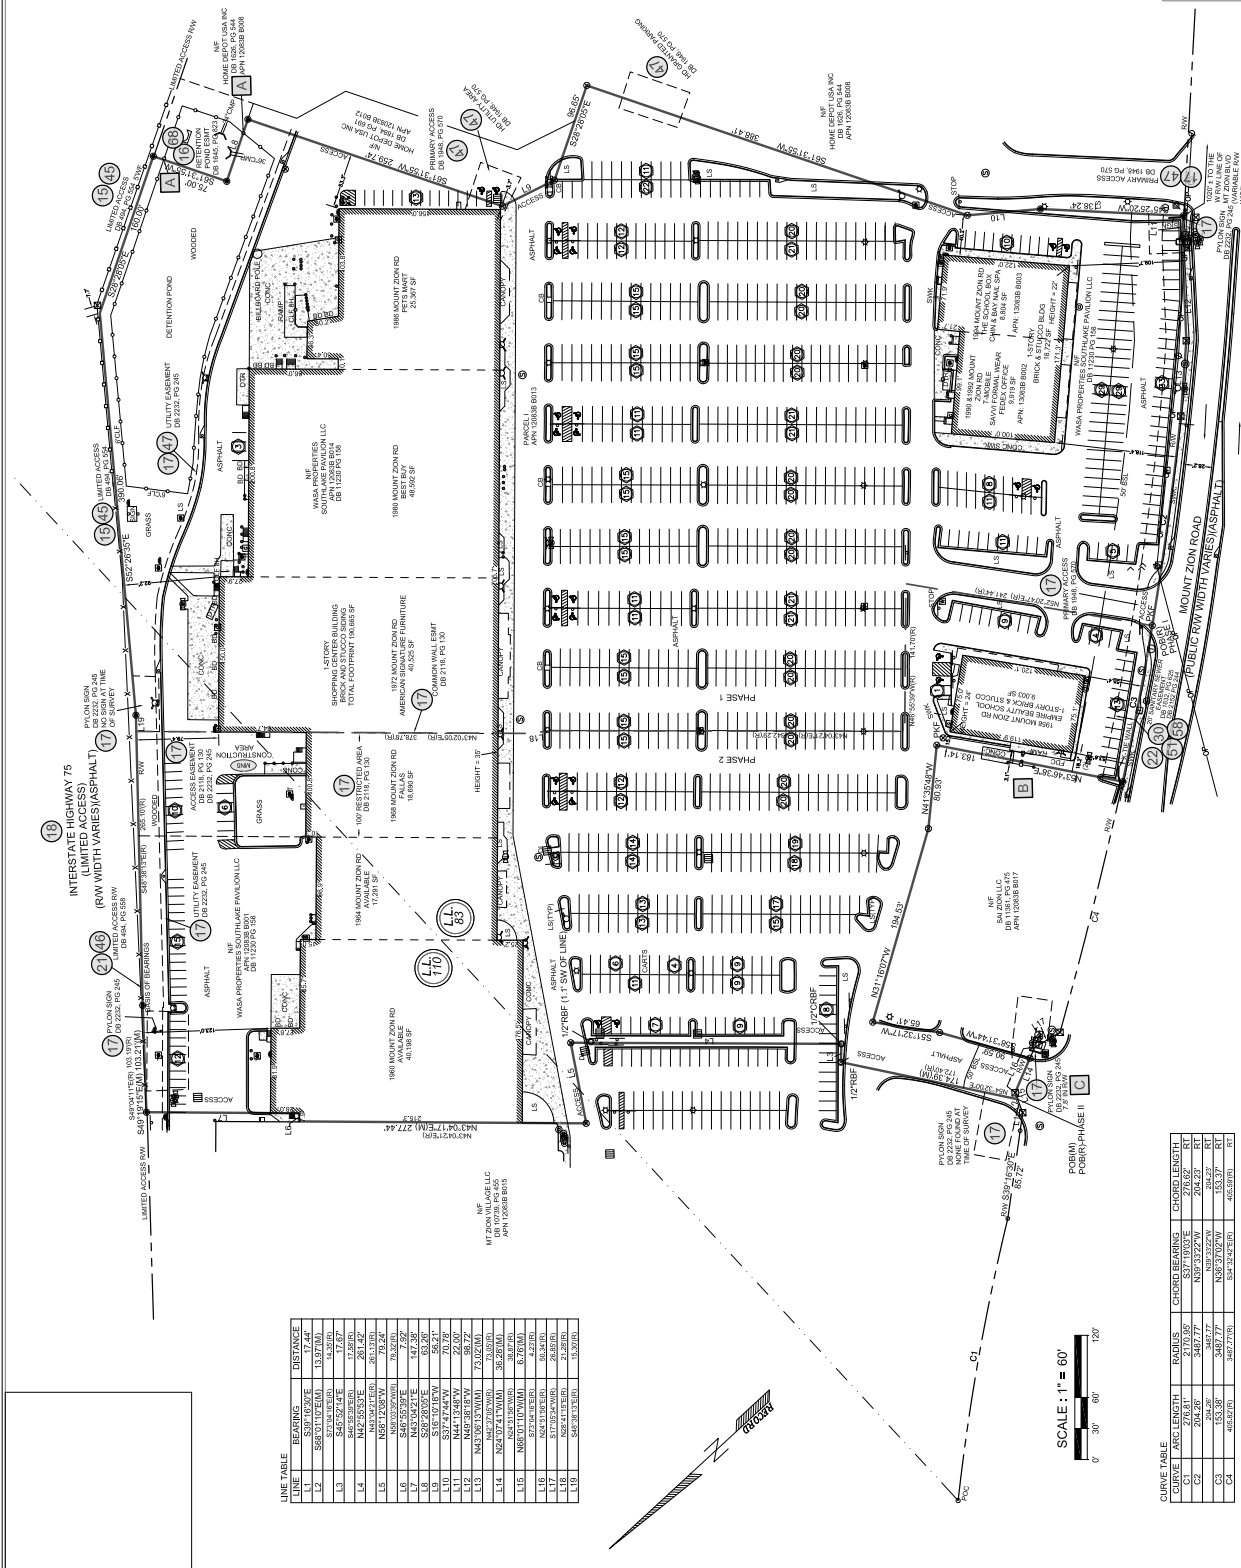

CURVE	ARC LENGTH	RADIUS	CHORD BEARING	CHORD LENGTH
C1	276.81'	2170.95'	S37°19'03"E	276.62' RT
C2	204.26'	3487.77'	N39°33'22"W	204.23' RT
C3	204.26'	3487.77'	N39°33'22"W	204.23' RT
