


2596 THIRD AVENUE
BRONX, NY 10035

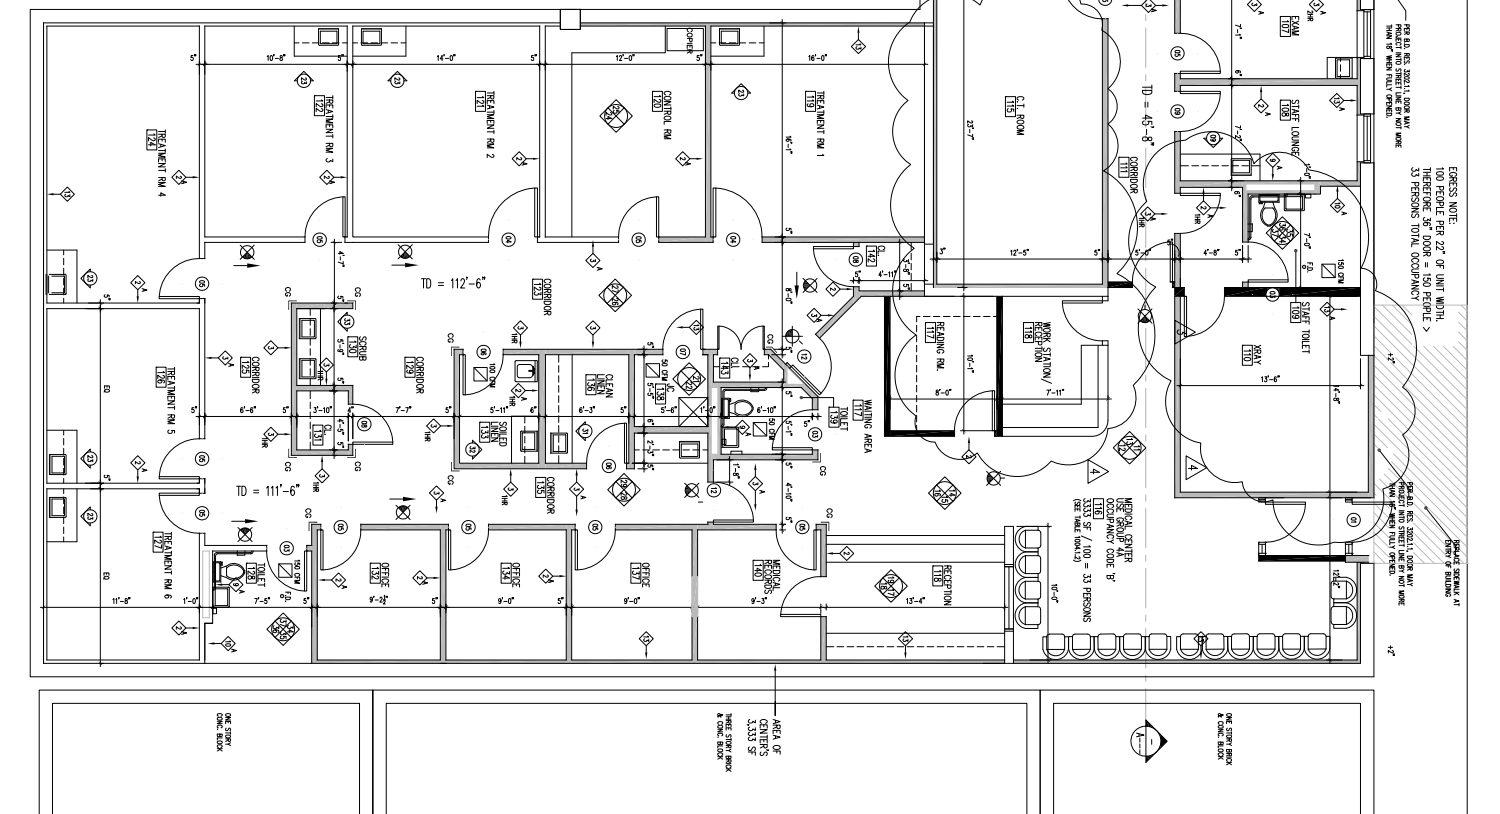

ISSUE:	
NUMBER	DESCRIPTION
1	1-5-10
2	1-11-10
3	8-19-10
4	1-6-11
5	4-13-12
6	
7	
ARCHITECT

Terjesen Associates Architects PC
248 West 35th Street Suite 11E New York, NY 10001
212.233.1526 Fax: 212.736.7899
Website: <http://www.terjesenarchitects.com>

Sleep Center @ 1st Floor
All Med
THIRD AVENUE
BRONX, NY

DRAWING TITLE
FIRST & CELLAR
FLOOR PLANS

DATE	03.18.09
PROJECT NUMBER	2792
DRAWN BY	
SCALE	
AS NOTED	
DRAWING NUMBER	A-002.02

SEAL



— OF 3

