


1-357

(FORMERLY DIAMOND ST)
FORBES ST 50'

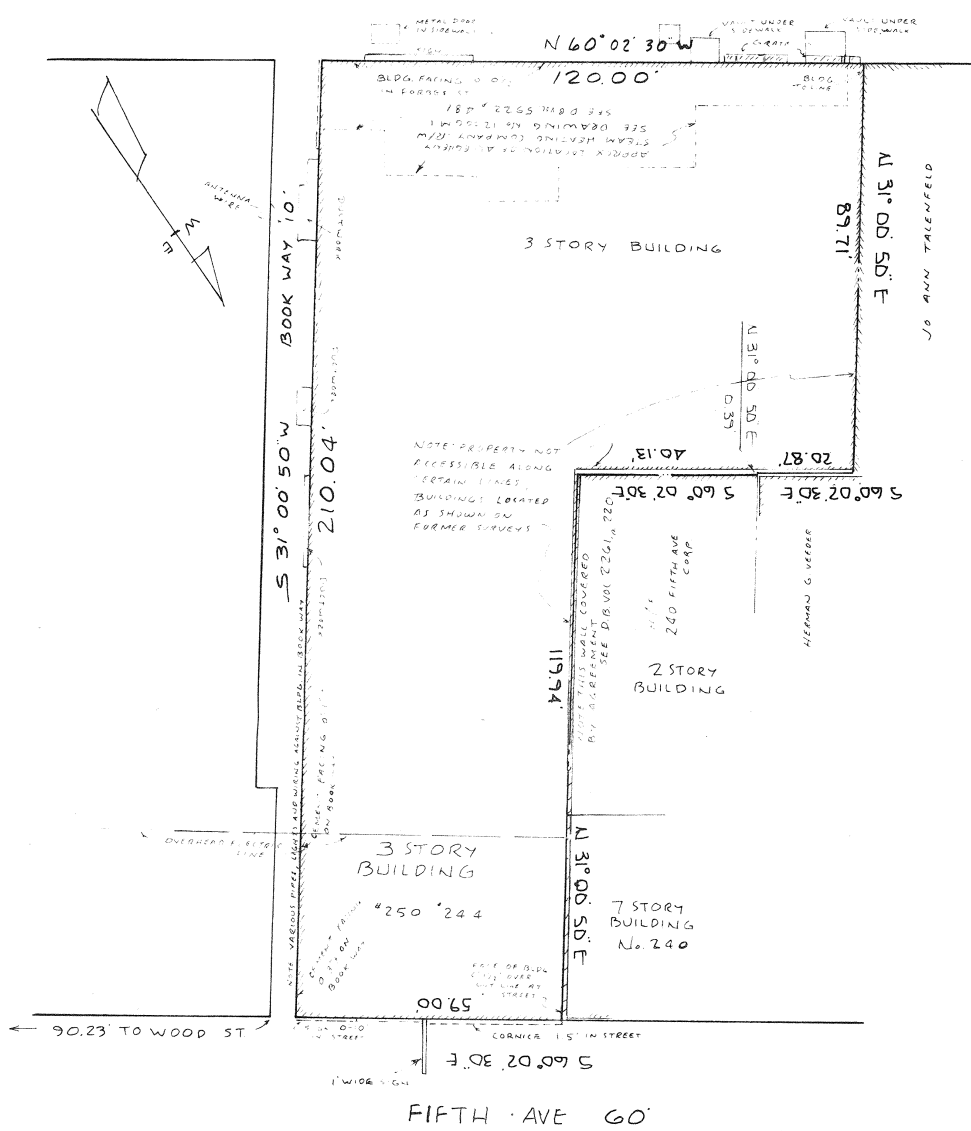

I hereby certify to, and solely for the benefit of
REYCO D S INC.
CHICAGO TITLE INSURANCE COMPANY
WELLS FARGO BANK N.A.
MARINE MIDLAND, N.A. AGENTS

that this plan was prepared from a survey made upon the premises
this 9th day of November, 1986, showing the location of
buildings, easements or servitudes apparent from an inspection of
the premises. This plan may not be relied upon by anyone
other than the above named for whose benefit it has been
prepared and embossed with an impression seal. Copies
of this plan without impression seal are for mere
convenience of reference only.

Joseph M. Puskar
Registered Professional Land Surveyor
8199 - E

PLAN OF SURVEY
SITUATE IN
2ND WARD, CITY OF PITTSBURGH, ALLEG CO, PA
SURVEYED FOR
MARVIN SOLGANIC
NOV. 1986 SCALE: 1"=20'
JOSEPH M. PUSKAR REGISTERED SURVEYOR
PITTSBURGH, PENNSYLVANIA