


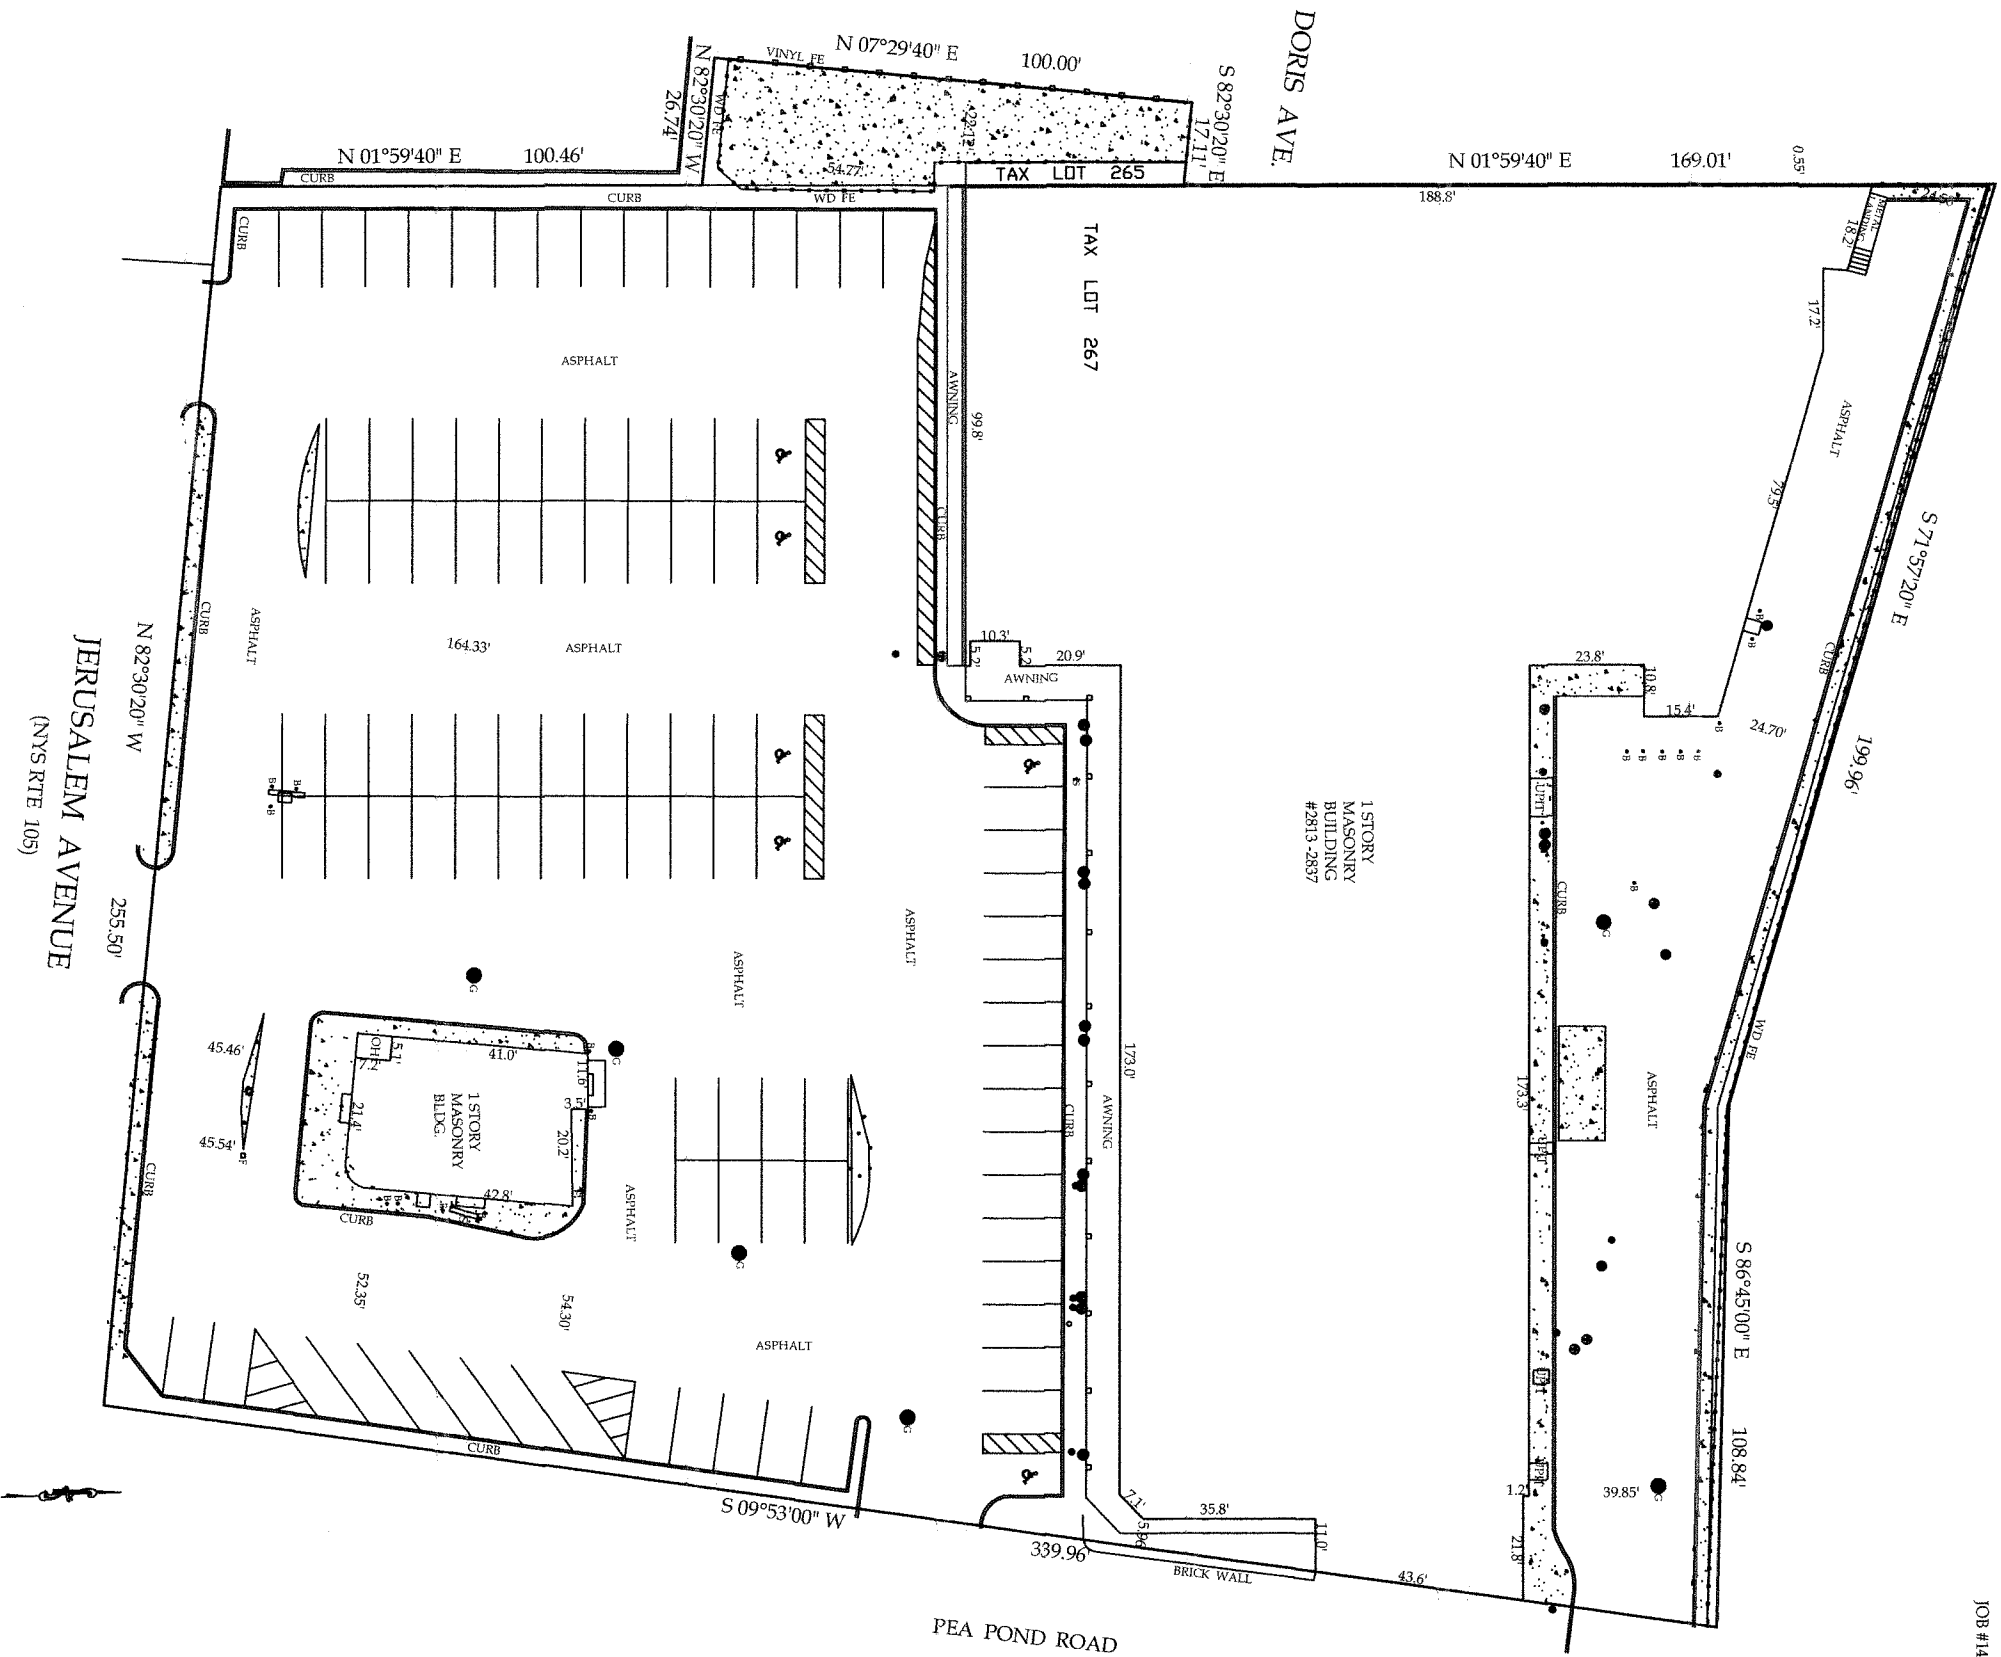

UNAUTHORIZED ALTERATION OR ADDITION TO THIS SURVEY IS A VIOLATION OF SECTION 2809 OF THE NEW YORK STATE EDUCATION LAW

COPIES OF THIS SURVEY MAP NOT BEARING THE LAND SURVEYORS INKED SEAL OR EMBOSSED SEAL SHALL NOT BE CONSIDERED TO BE VALID TRUE COPY


GUARANTEES INDICATED HEREON SHALL RUN ONLY TO THE PERSON FOR WHOM THE SURVEY IS PREPARED, AND ON HIS BEHALF TO THE TITLE COMPANY, GOVERNMENTAL AGENCY, AND LENDING INSTITUTION LISTED HEREON, AND TO THE ASSIGNEES OF THE LENDING INSTITUTION. GUARANTEES ARE NOT TRANSFERABLE TO ADDITIONAL INSTITUTIONS OR SUBSEQUENT OWNERS

ALL STRUCTURES, EASEMENTS, OR UNDERGROUND UTILITIES NOT SHOWN ARE NOT GUARANTEED

THE OFFSETS OR DIMENSIONS SHOWN HEREON FROM THE STRUCTURES TO THE PROPERTY LINE ARE FOR A SPECIFIC PURPOSE AND USE, AND THEREFORE ARE NOT INTENDED TO GUIDE THE ERECTION OF FENCES, RETAINING WALLS, POOLS, PATIOS, PLANTING AREAS, ADDITIONS TO ANY BUILDINGS OR ANY OTHER CONSTRUCTION

- = HANDICAPPED PARKING
- = SANITARY
- = WATER
- = GAS
- = WATER METER
- = MANHOLE
- = CRATE
- = FLAG
- = SIGN
- = LIGHT POLE
- = UTILITY PIT

SURVEY OF PROPERTY
LOCATED AT NORTH BELLMORE
TOWN OF HEMPSTEAD
NASSAU COUNTY, NY
N.C.T.M. 51 - 71 - 267
51 - 72 - 265
CERTIFIED TO:
UNITED PROPERTIES CORP.,
INVESTORS BANK, ISADA ATIMA
FIDELITY NAT. TITLE INS. CO.
ISLAND ABSTRACT INC.
#1A06471N18CR

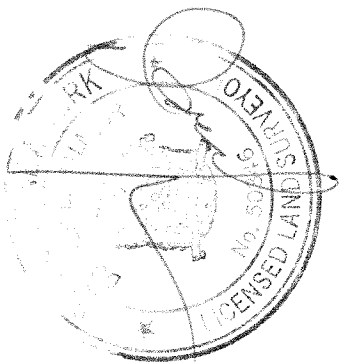

PREPARED BY:
DONALD L. MALM, JR
LAND SURVEYOR
61 NASSAU AVE
ISLIP, NY 11751
631-581-0003
SCALE: 1"= 40'
DATE: MAY, 2014
UPDATE: OCT. 12, 2018